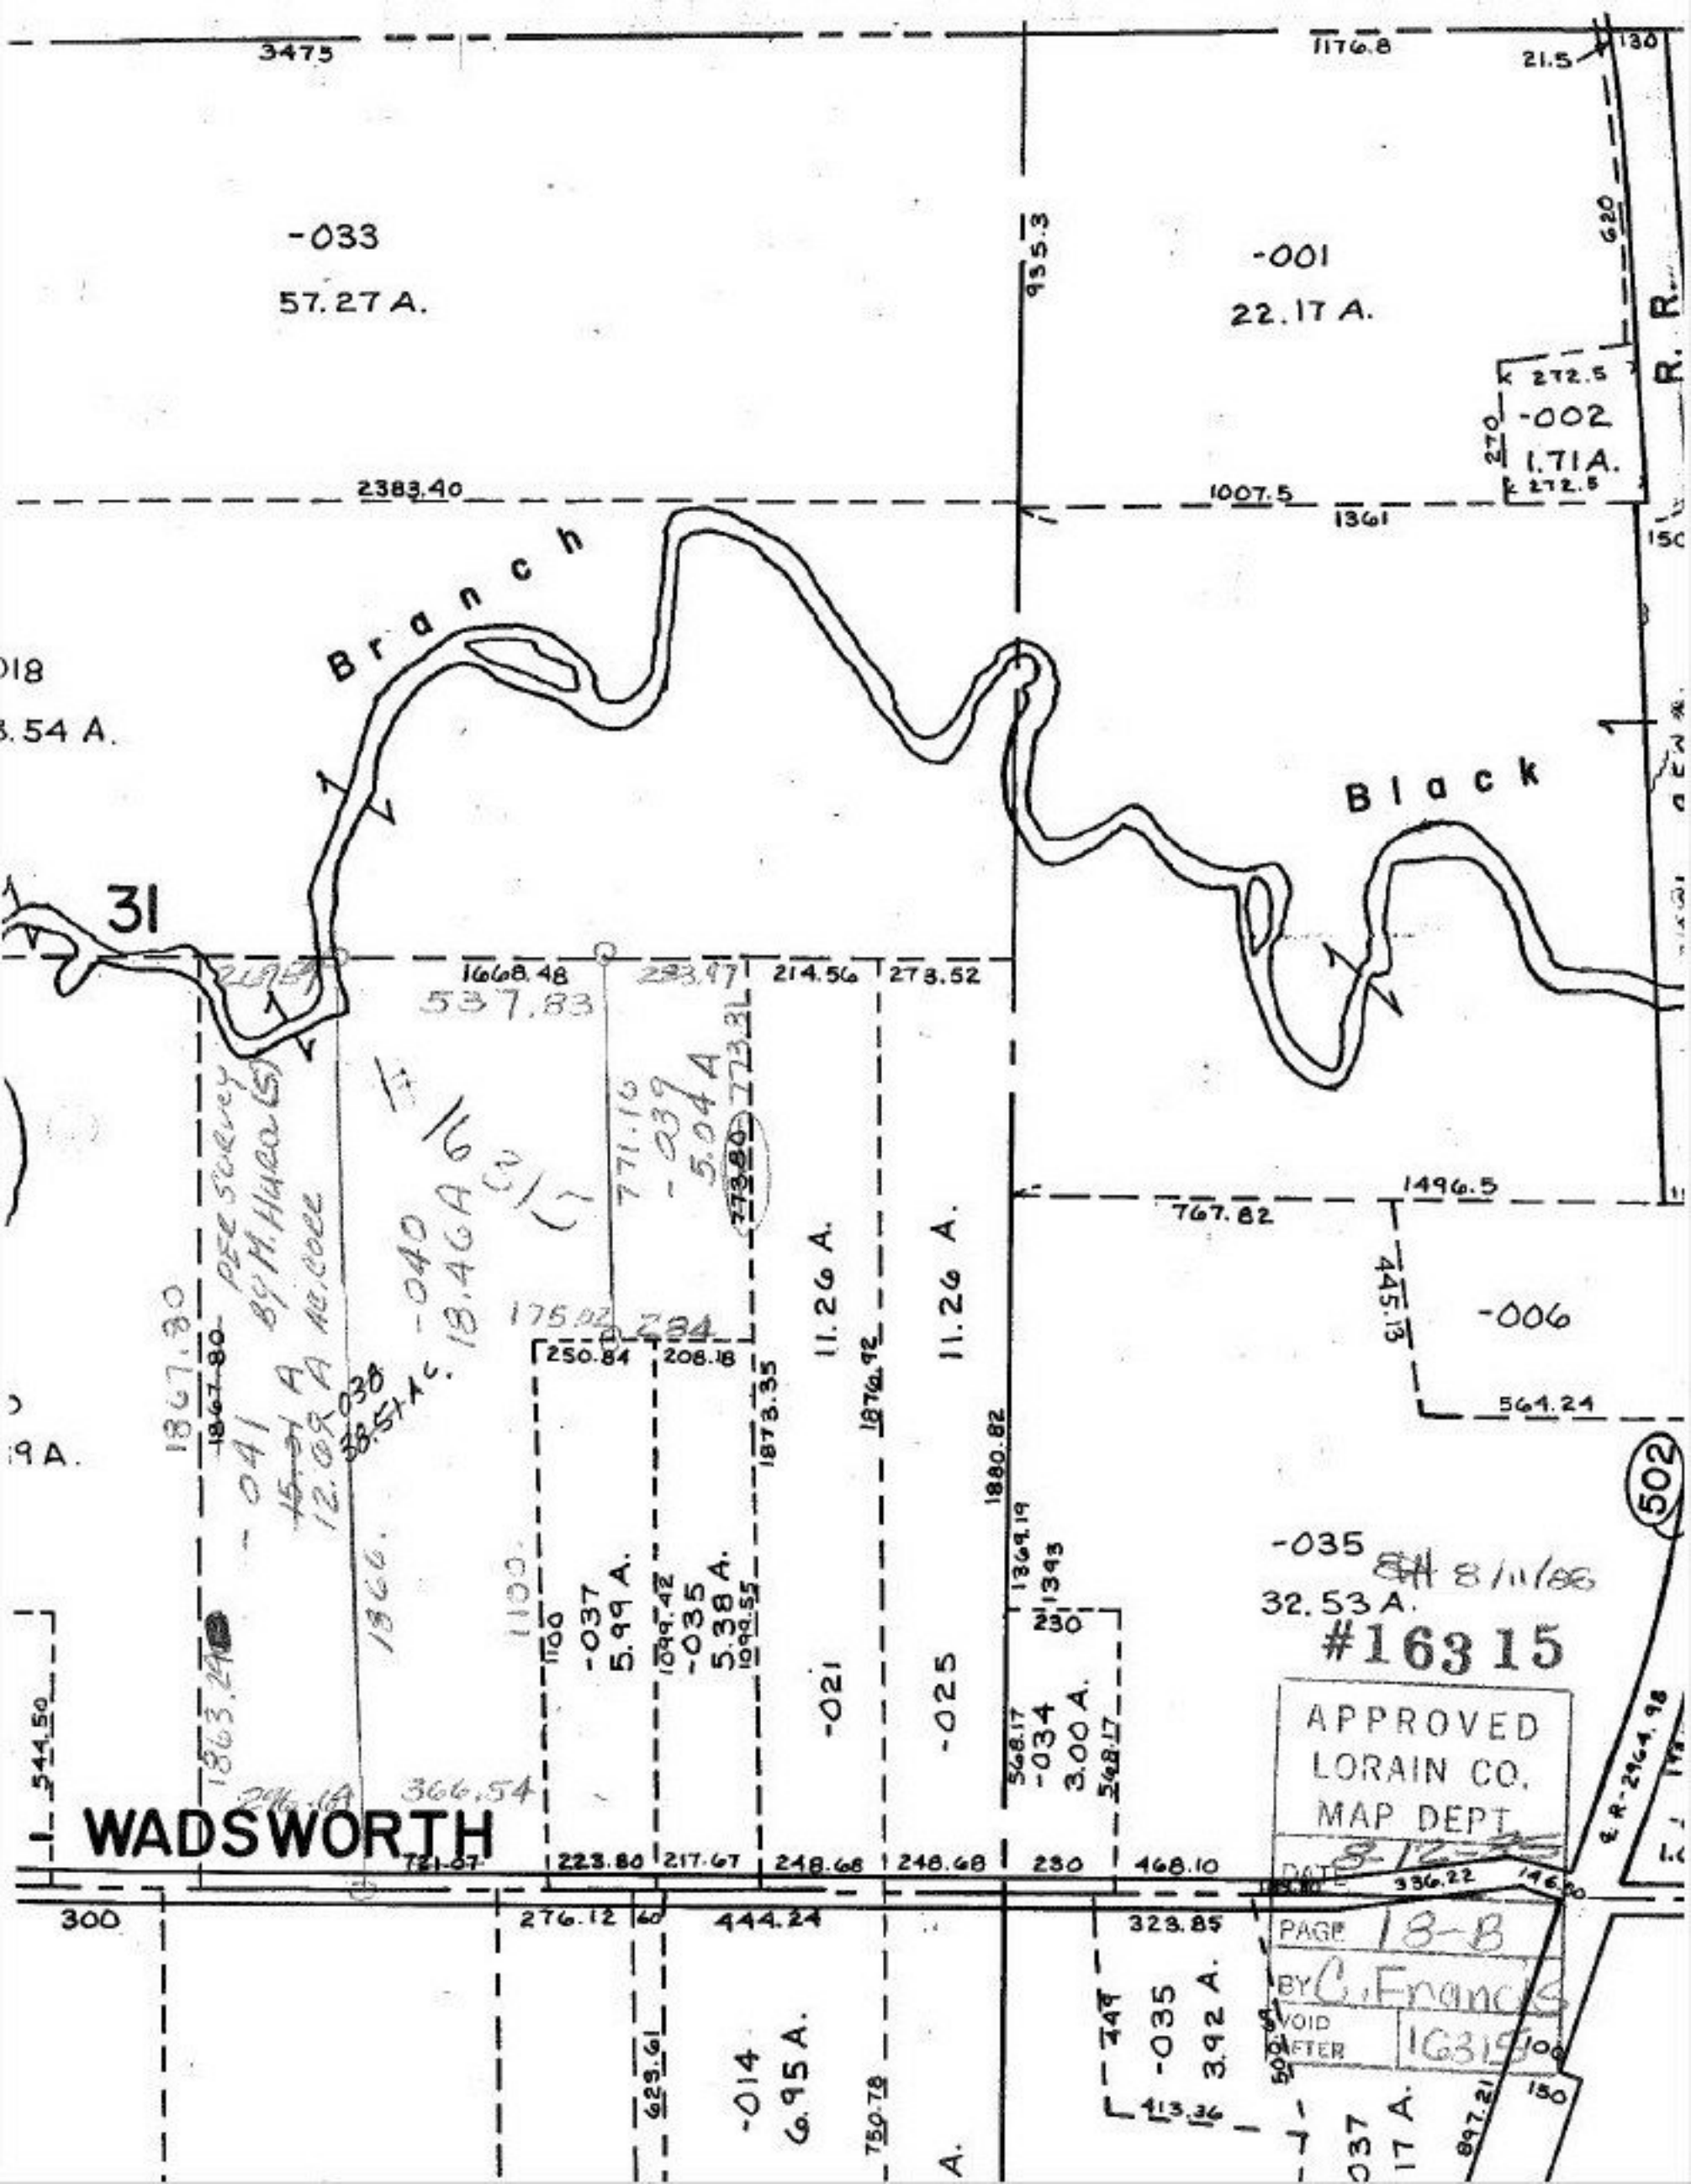

3475
1176.8
21.5
130
-033
57.27 A.
935.3
-001
22.17 A.
620
R. R.
272.5
-002
1.71 A.
270
272.5
2383.40
1007.5
1361
150
Branch
Black
018
3.54 A.
31
1668.48
537.83
233.97
214.56
273.52
773.80
771.16
-039
5.04 A
773.81
1496.5
767.82
445.13
-006
564.24
PER SURVEY BY M. HARA (S) AC. CORR
-040
18.46 A
175.02
284
250.84
208.18
11.26 A.
11.26 A.
1873.35
1876.92
1880.82
1867.80
1867.80
-041
-038
38.51 A.C.
1866.
1100
1100
-037
5.99 A.
1099.42
-035
5.38 A.
1099.55
-021
-025
1369.19
1393
230
-035
32.53 A.
8/11/86
#16315
APPROVED
LORAIN CO.
MAP DEPT.
DATE 8-12-86
PAGE 18-B
BY C. Francis
VOID AFTER 16315
502
544.50
1863.29
366.54
WADSWORTH
721.07
223.80
217.67
248.68
248.68
230
468.10
336.22
146.80
300
276.12
60
444.24
323.85
623.61
-014
6.95 A.
750.78
449
-035
3.92 A.
413.36
-037
17 A.
897.21
150