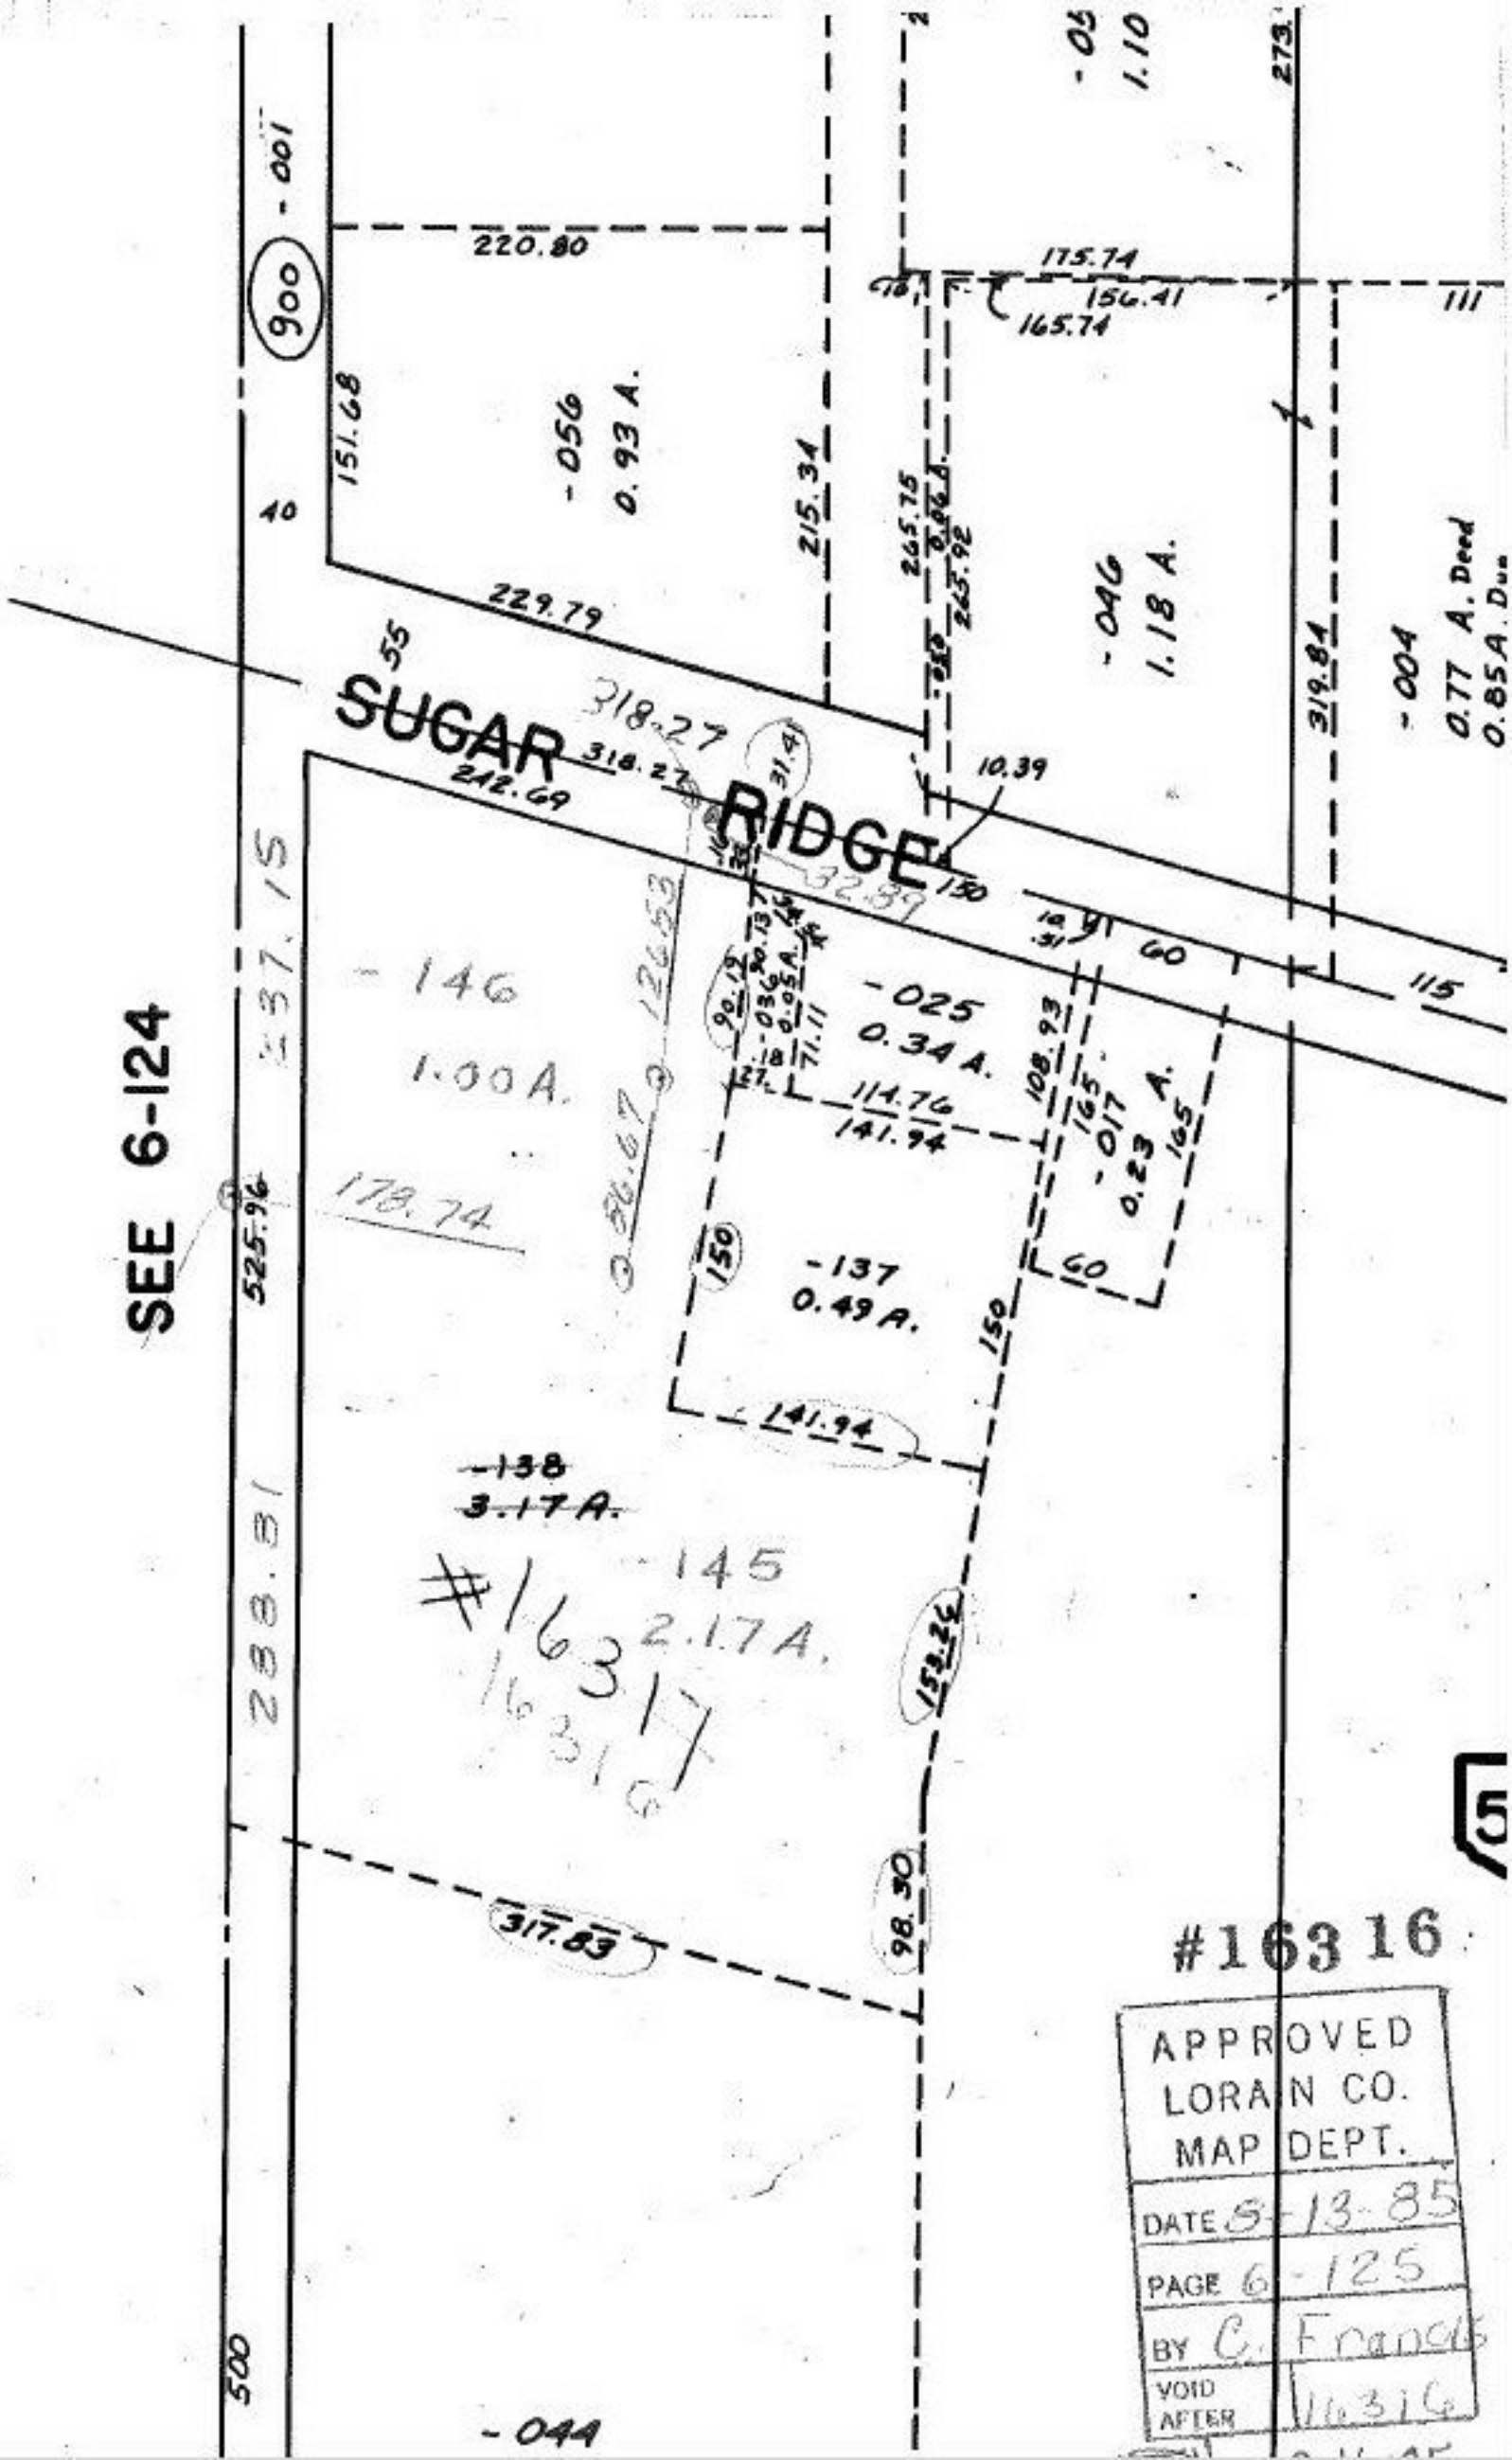
SUGAR RIDGE
900 - 001
220.80
151.68
0.93 A.
- 056
215.34
229.79
318.27
242.69
10.39
1.18 A.
- 046
319.84
- 004
0.77 A. Deed
0.85 A. Dee
175.74
156.41
165.74
111
273
SEE 6-124
337.15
- 146
1.00 A.
178.74
525.96
- 137
0.49 A.
141.94
- 138
3.17 A.
- 145
2.17 A.
#16317
16316
238.81
317.83
98.30
- 044
- 025
0.34 A.
114.76
108.93
- 017
0.23 A.
#16316
APPROVED
LORAIN CO.
MAP DEPT.
DATE 5-13-85
PAGE 6-125
BY C. Francis
VOID AFTER 16316