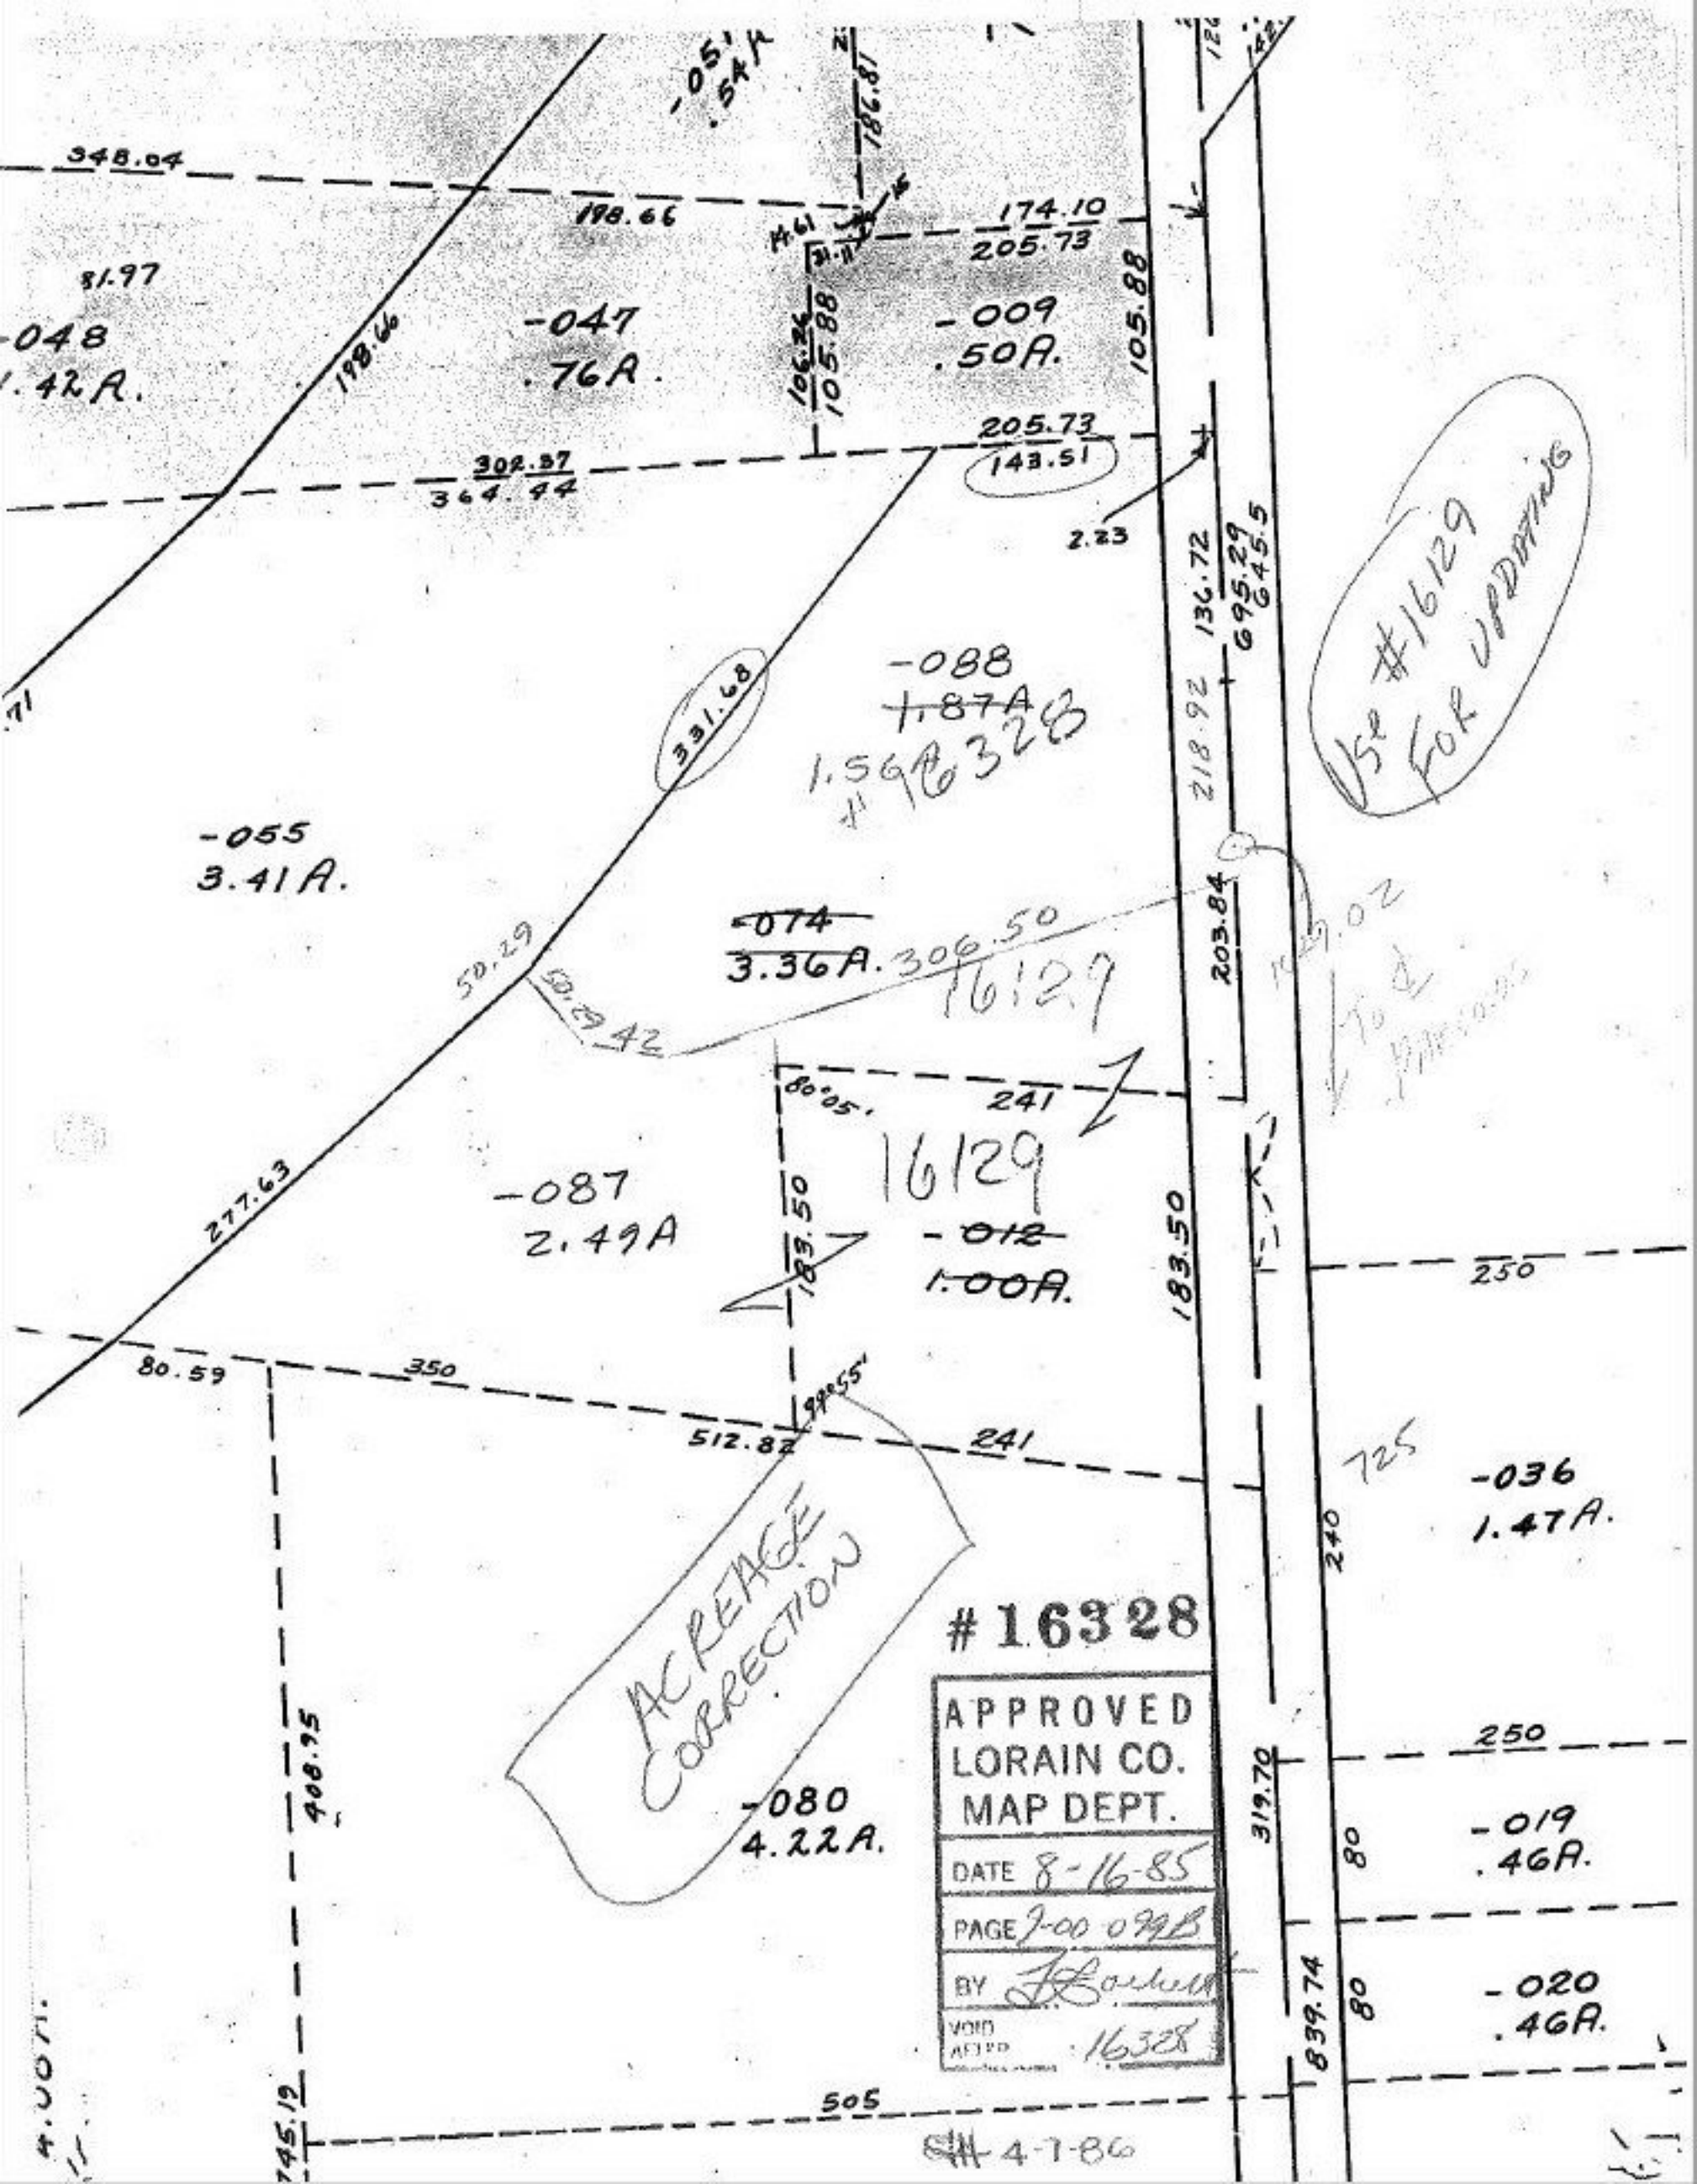
348.04
198.66
174.10
205.73
81.97
-048
1.42A.
198.66
-047
.76A.
106.26
105.88
-009
.50A.
105.88
205.73
143.51
302.37
364.44
2.23
136.72
695.29
645.5
Use #16129 FOR UPDATING
-088
~~1.87A~~
1.56A
#16328
331.68
218.92
-055
3.41A.
~~-074~~
3.36A.
306.50
16129
203.84
50.29
50.29
42
80°05'
241
16129
277.63
-087
2.49A
183.50
~~-012~~
~~1.00A.~~
183.50
250
80.59
350
99°55'
512.82
241
725
-036
1.47A.
240
ACREAGE CORRECTION
#16328
APPROVED
LORAIN CO.
MAP DEPT.
DATE 8-16-85
PAGE 9-00-099B
BY
VOID AFTER 16328
250
408.95
-080
4.22A.
319.70
80
-019
.46A.
839.74
80
-020
.46A.
505
745.19
4-7-86