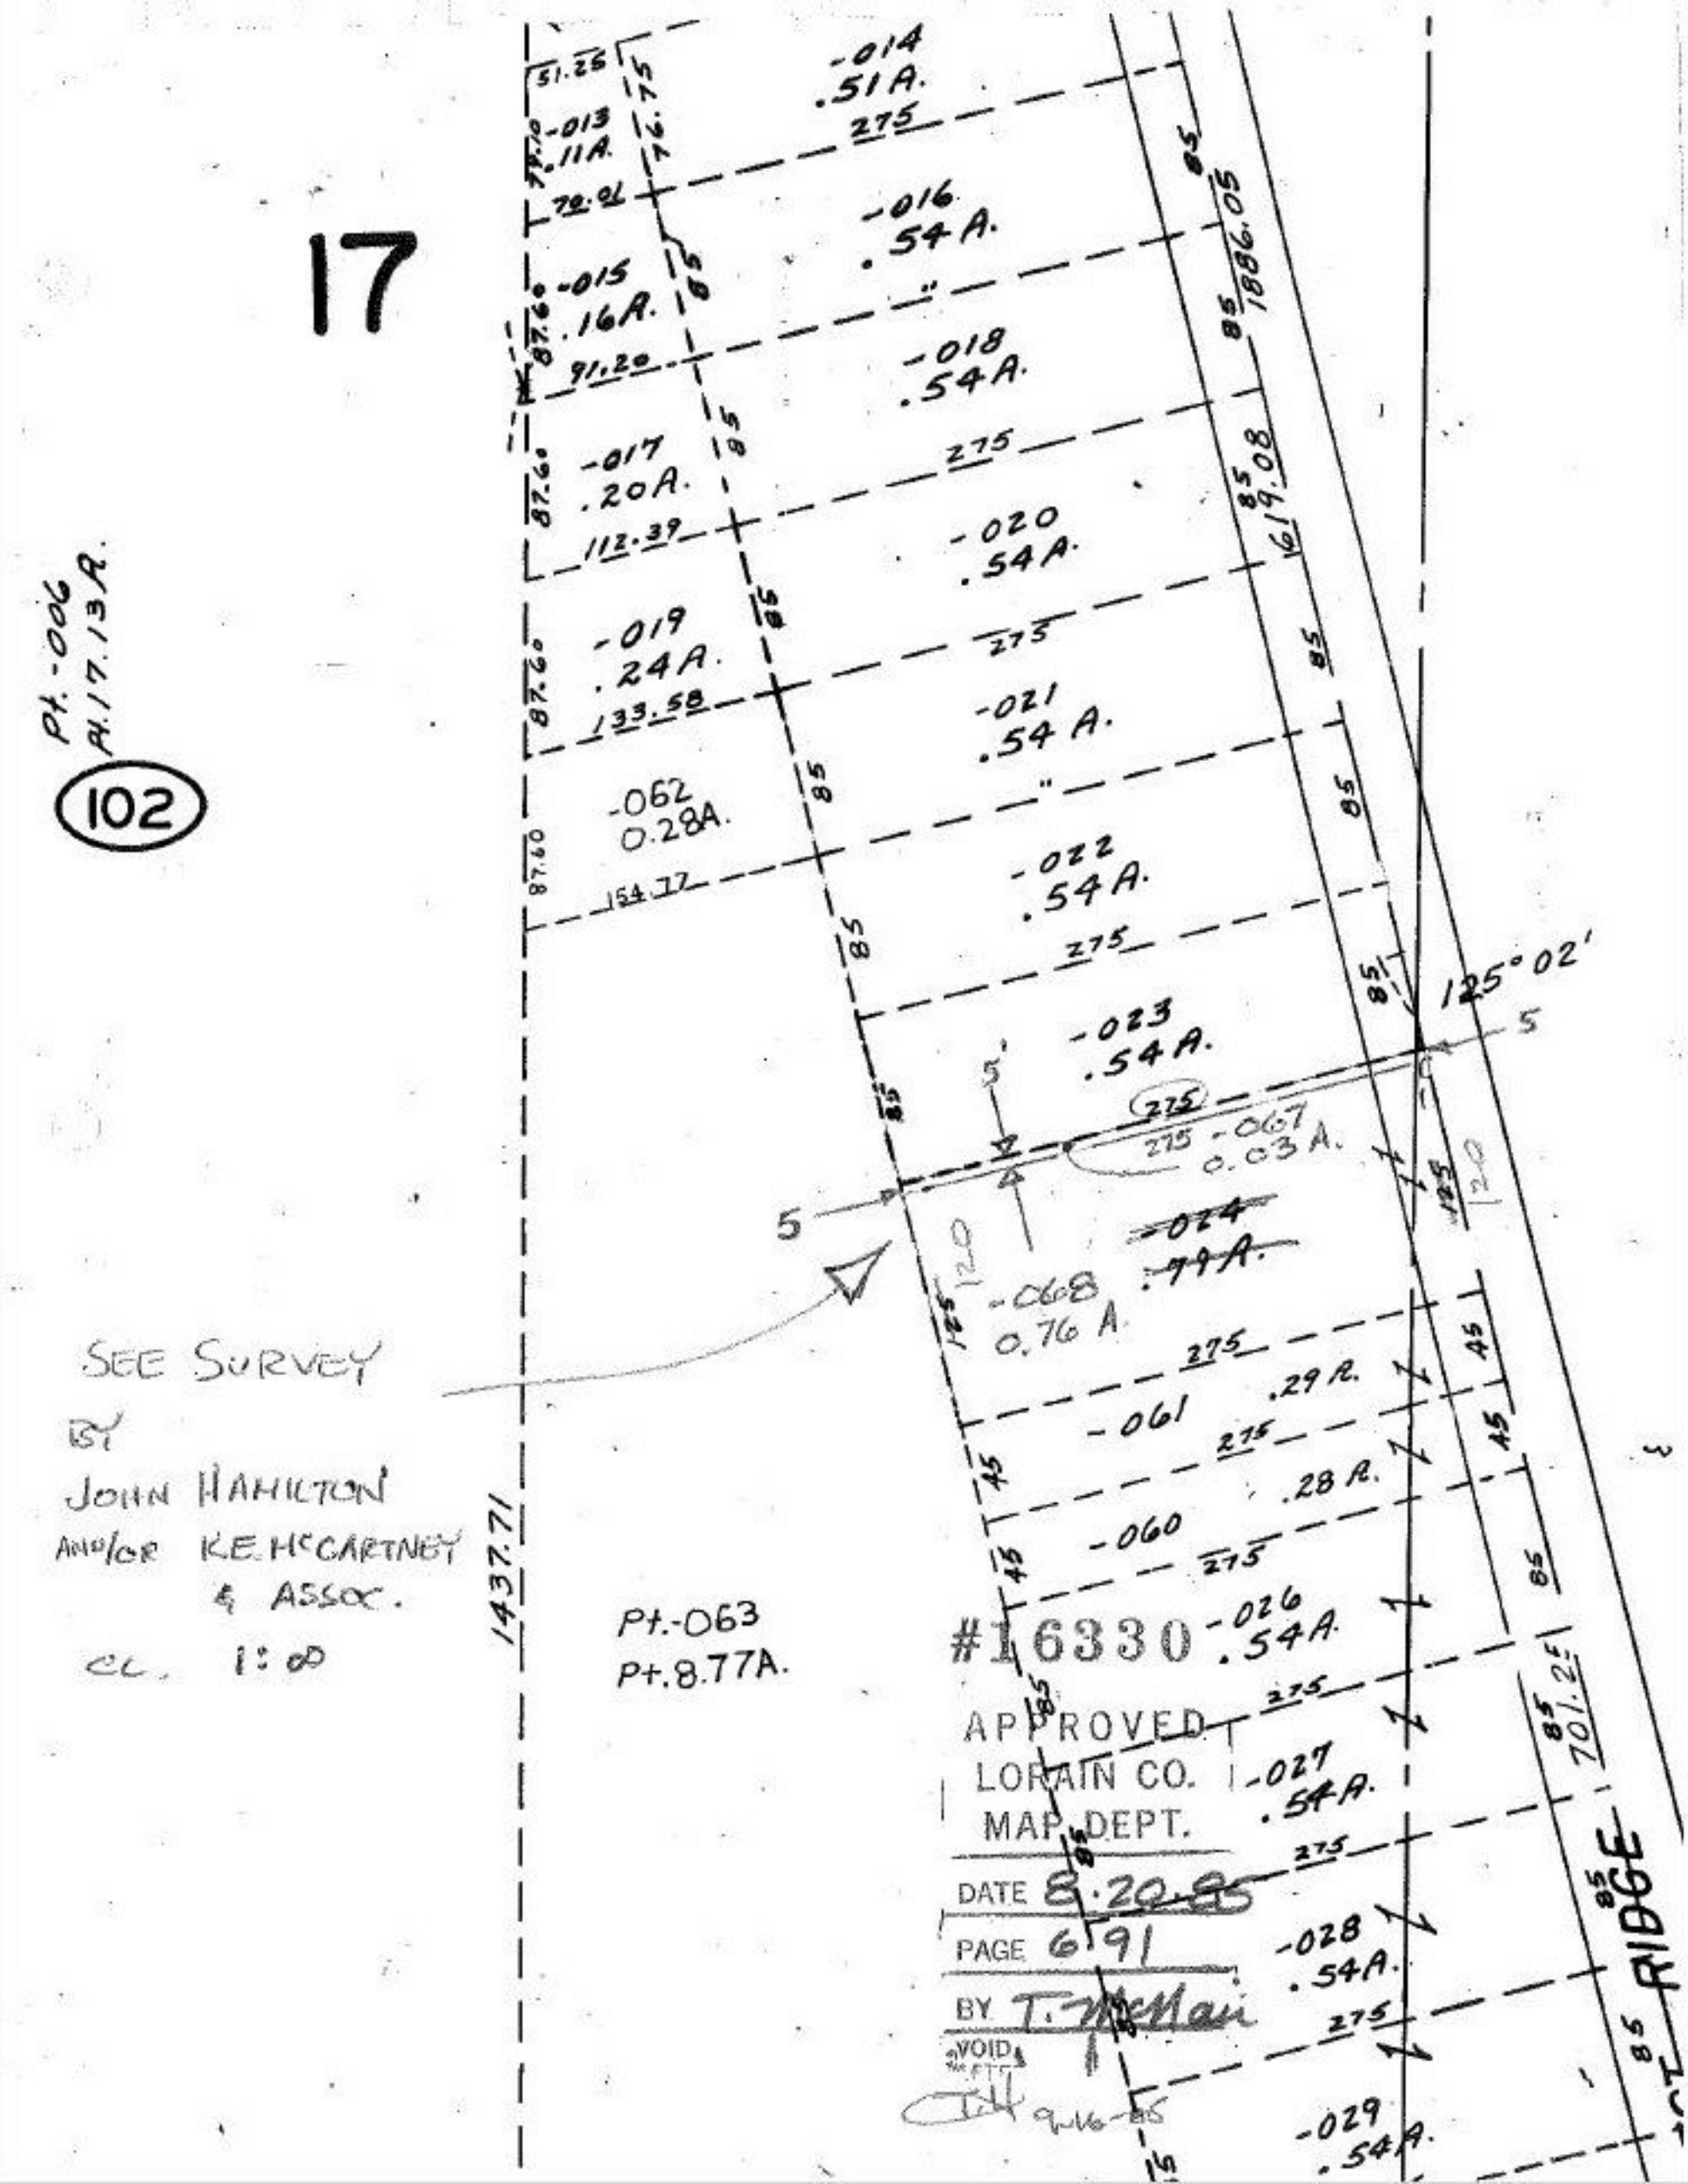
17
102
Pt.-006
Pt.17.13A.
-014
.51A.
275
-013
.11A.
51.25
76.75
70.01
-016
.54A.
-015
.16A.
87.60
91.20
-018
.54A.
-017
.20A.
112.39
-020
.54A.
-019
.24A.
133.58
-021
.54A.
-062
0.28A.
154.77
-022
.54A.
-023
.54A.
-067
0.03A.
-024
.79A.
-068
0.76A.
-061
.29A.
-060
.28A.
-026
.54A.
-027
.54A.
-028
.54A.
-029
.54A.
1886.05
1619.08
701.25
125°02'
1437.71
Pt.-063
Pt.8.77A.
SEE SURVEY
BY
JOHN HAMILTON
AND/OR K.E. McCARTNEY
& ASSOC.
CL. 1:∞
#16330
APPROVED
LORAIN CO.
MAP DEPT.
DATE 8.20.85
PAGE 691
BY T. McMain
VOID
9-16-85
RIDGE