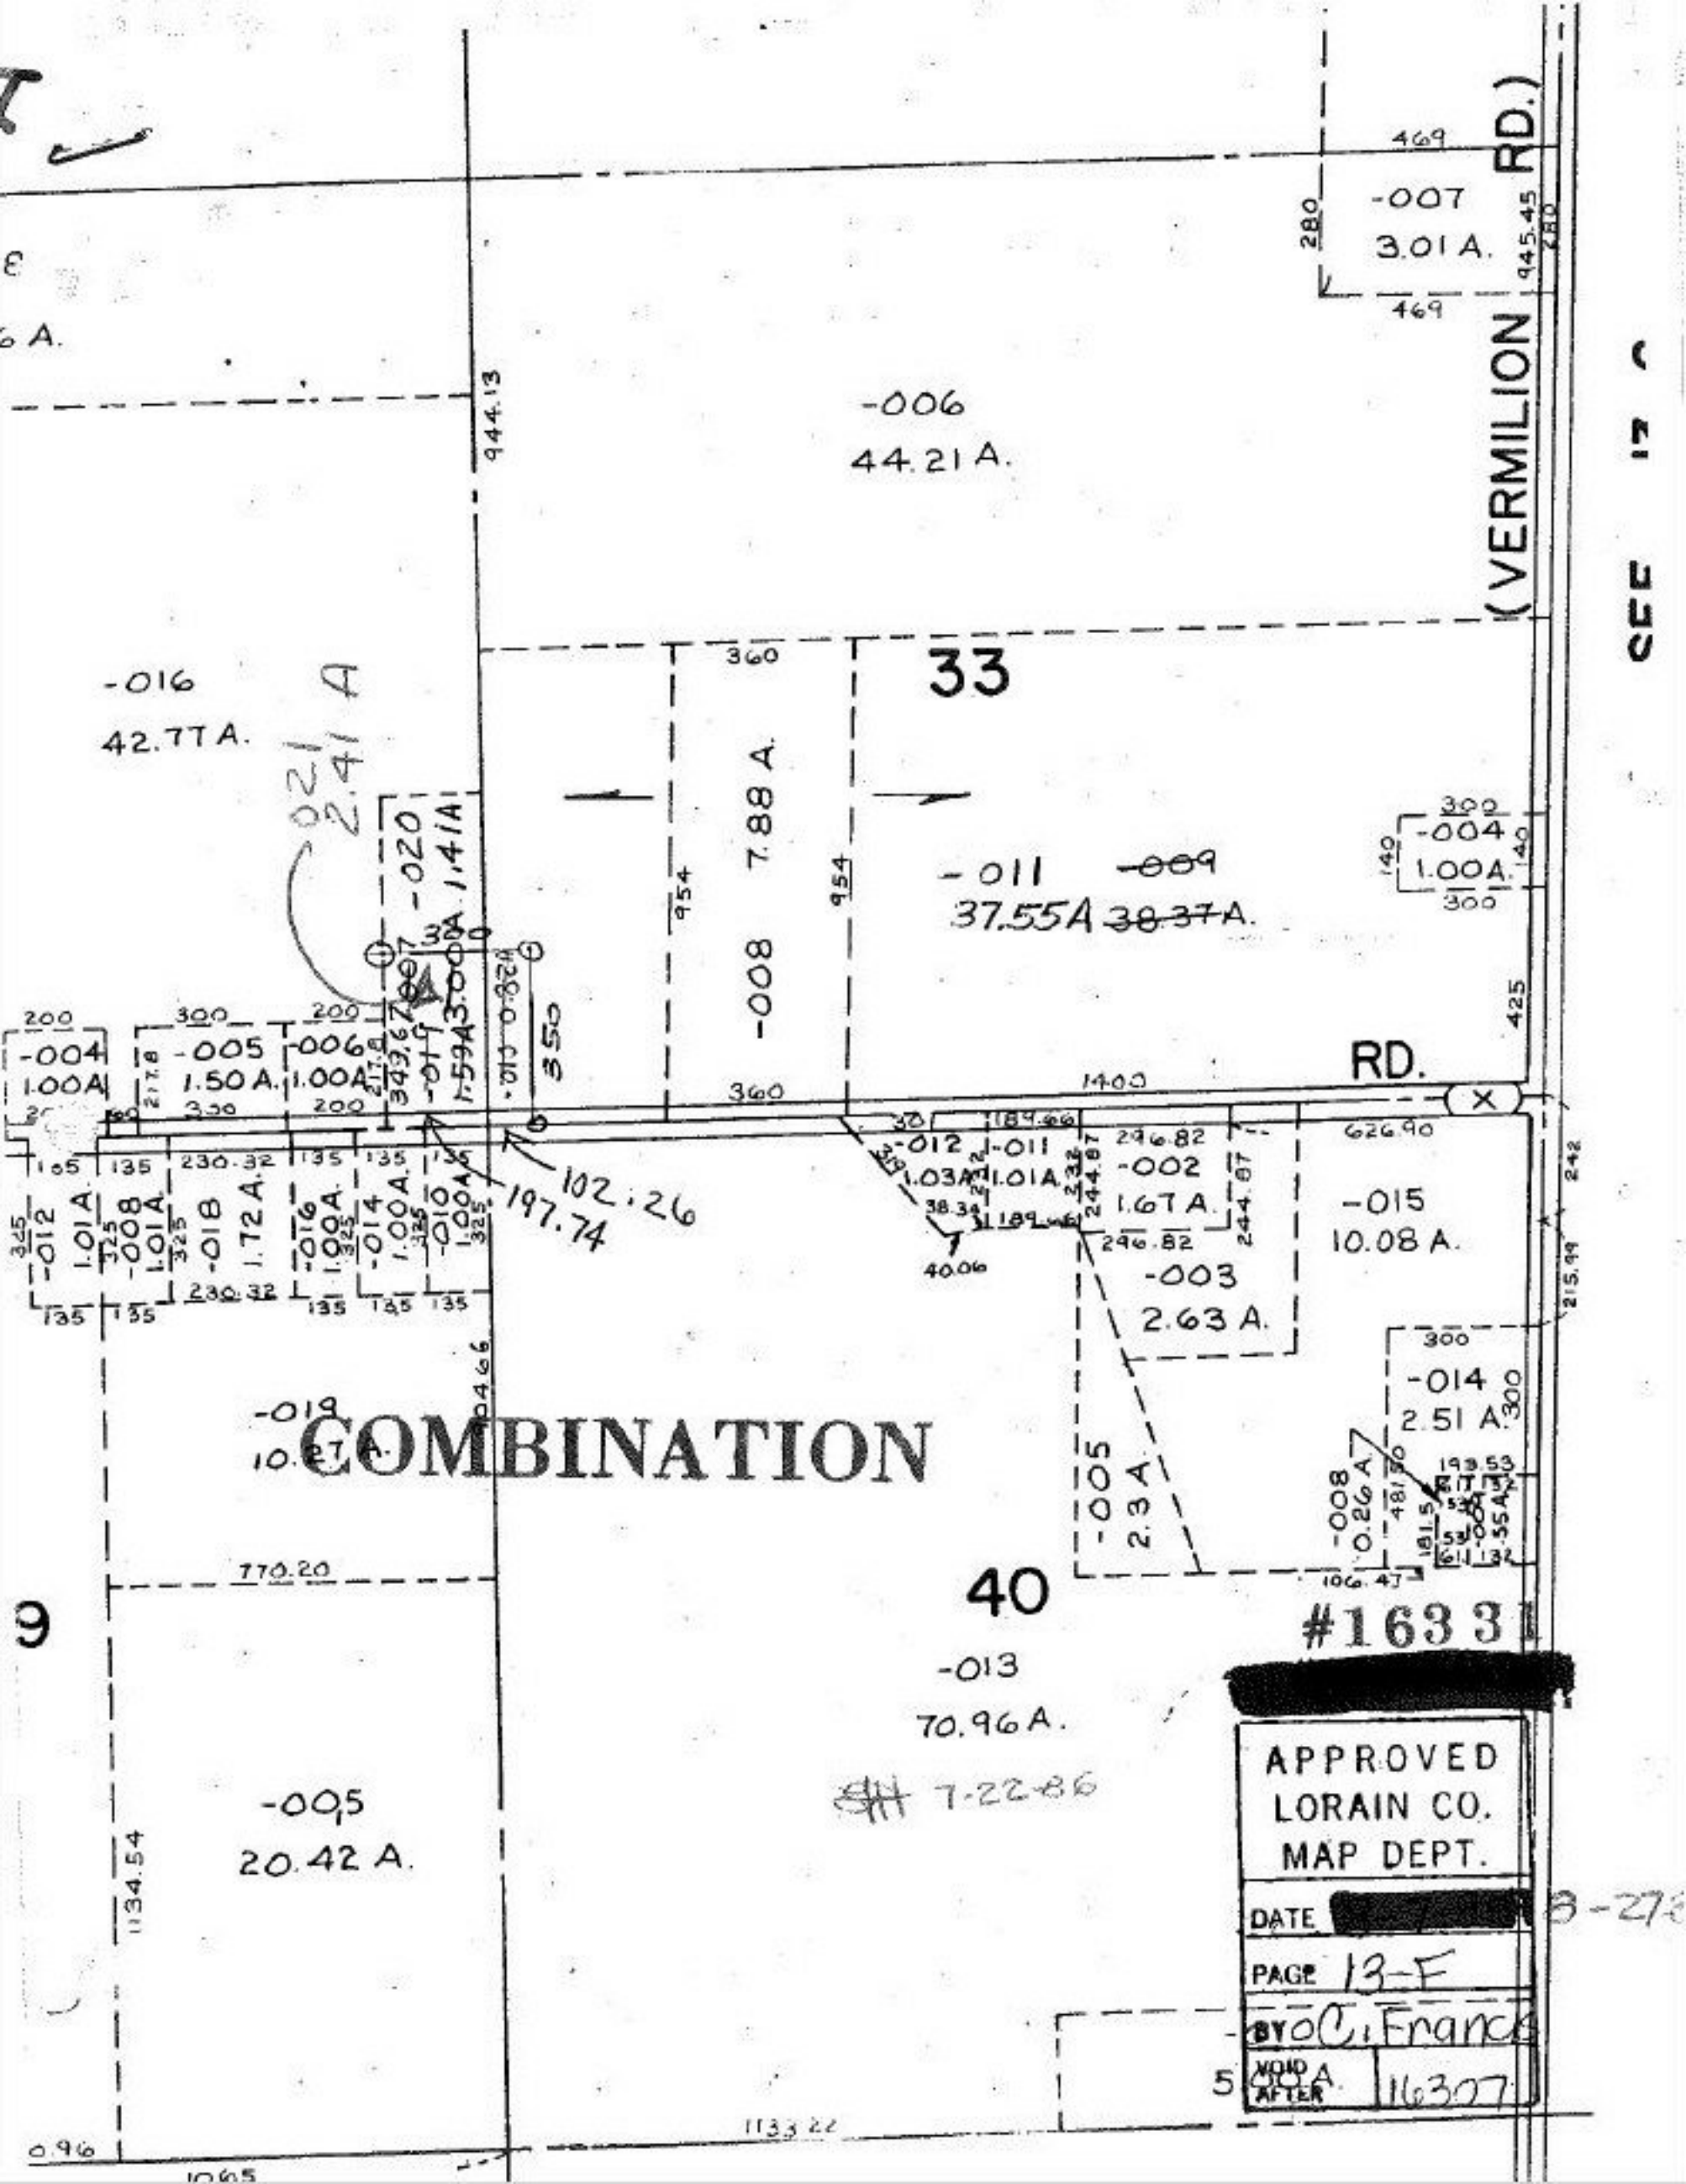

(VERMILION RD.)
-007
3.01 A.
-006
44.21 A.
-016
42.77 A.
021
2.41 A
33
-020
1.41A
-008
7.88 A.
-011
37.55A
-004
1.00A.
-004
1.00A
-005
1.50 A.
-006
1.00A
RD.
-012
1.03A
-011
1.01A
-002
1.67 A.
-015
10.08 A.
-003
2.63 A.
-014
2.51 A.
-005
2.3 A
-008
0.26 A
-019
10.27 A.
COMBINATION
-005
20.42 A.
40
-013
70.96 A.
#16331
[redacted]
APPROVED
LORAIN CO.
MAP DEPT.
DATE [redacted]
PAGE 13-F
BY C. Franck
VOID AFTER 16307