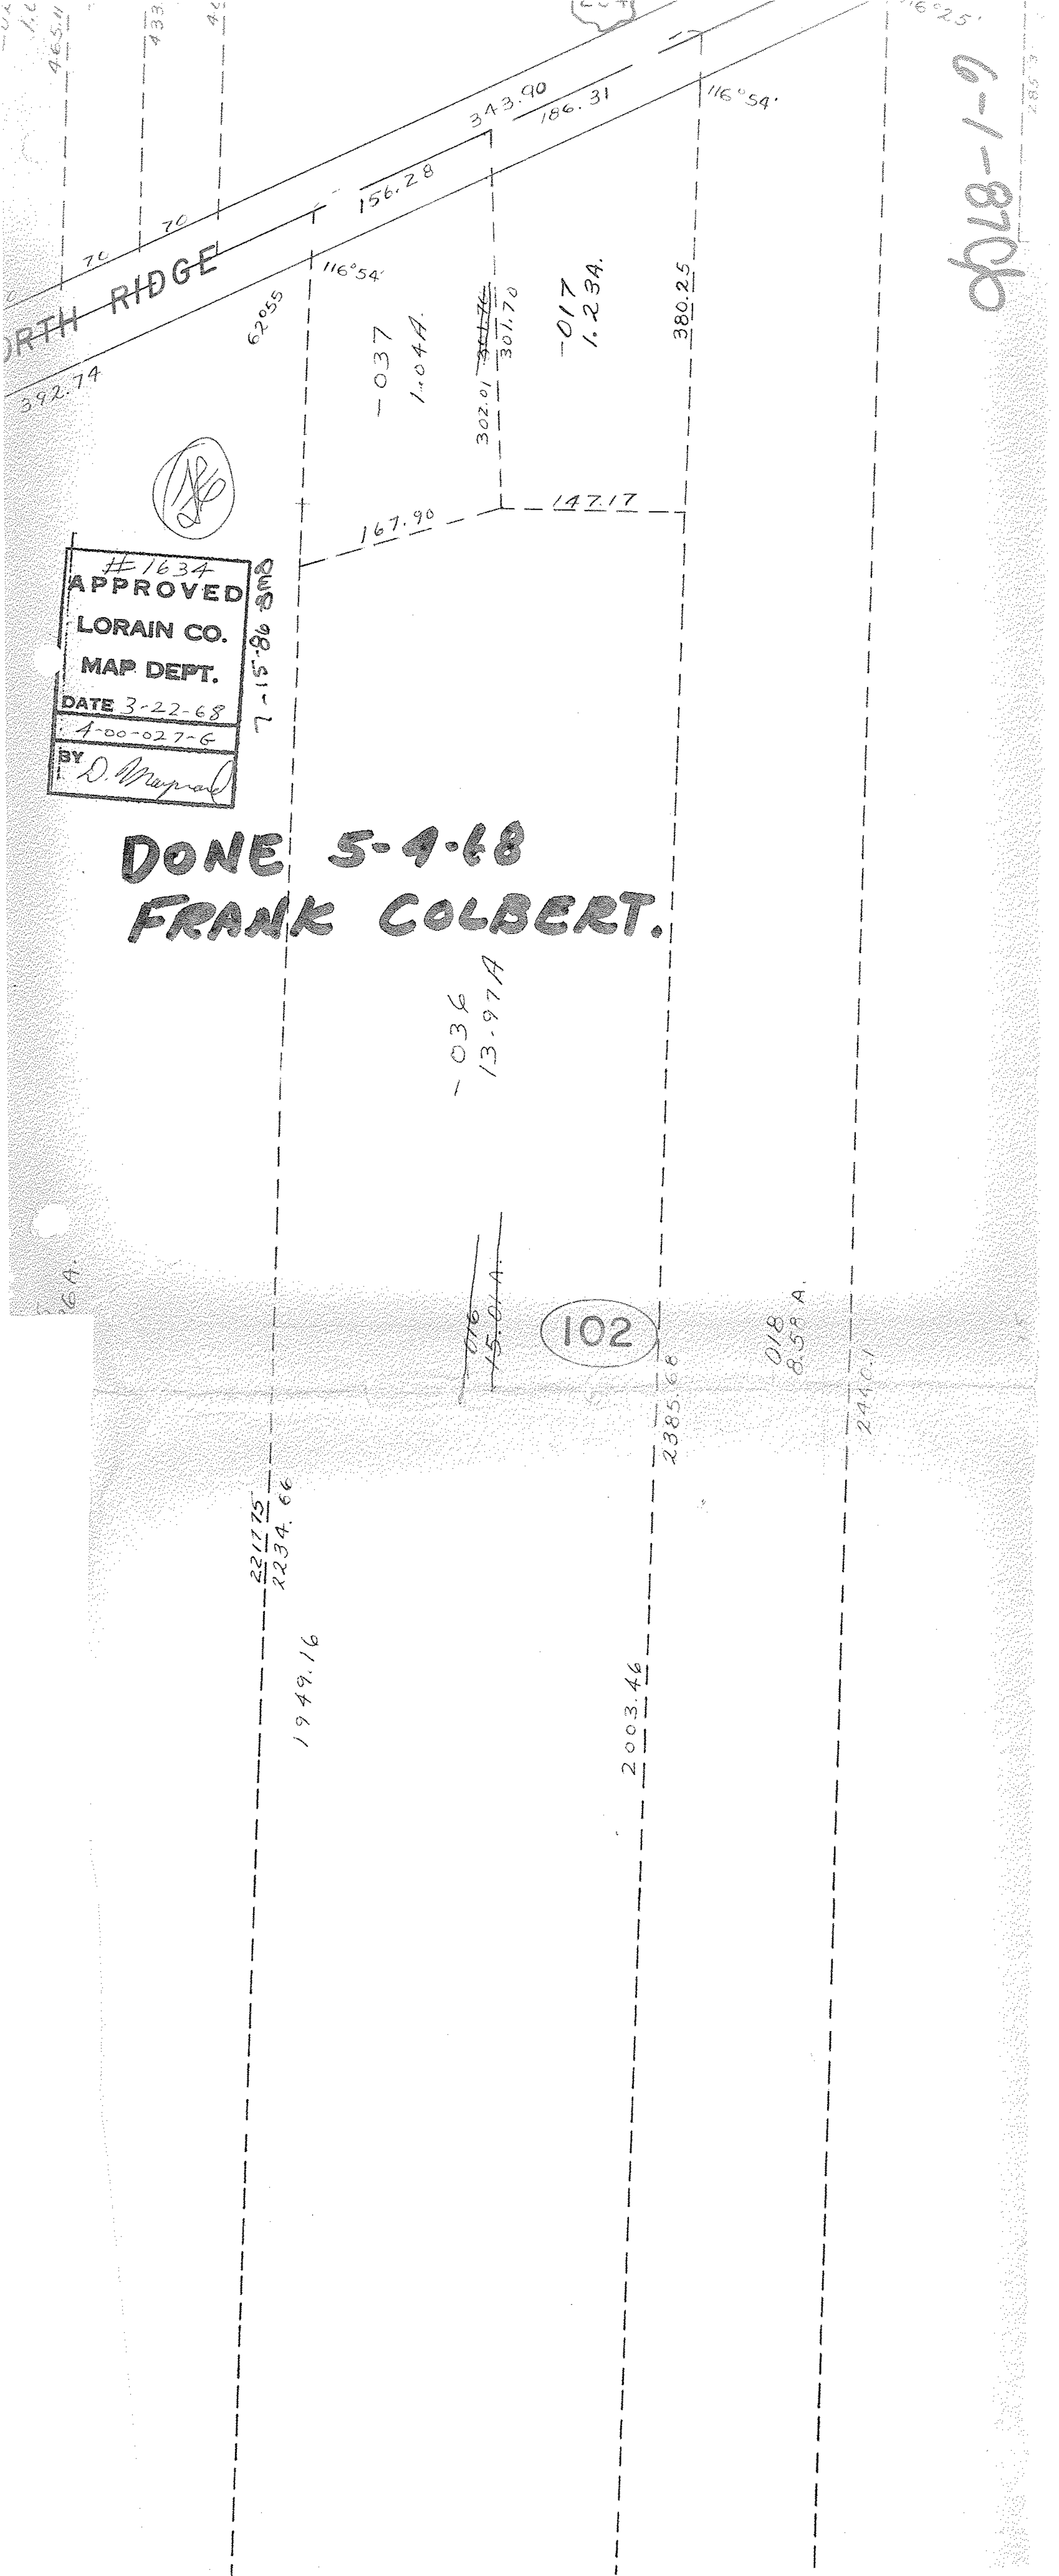
NORTH RIDGE
343.90
186.31
156.28
116°54'
62.55
392.74
-037
1.044A.
302.01
301.70
-017
1.234.
380.25
147.17
167.90
#1634
APPROVED
LORAIN CO.
MAP DEPT.
DATE 3-22-68
4-00-027-6
BY D. Murphy
7-15-86 SM2
DONE 5-4-68
FRANK COLBERT.
-036
13.971A
102
016
15.04A.
018
8.58A.
2385.68
2211.75
1234.66
1949.16
2003.46
2440.1
6-1-87