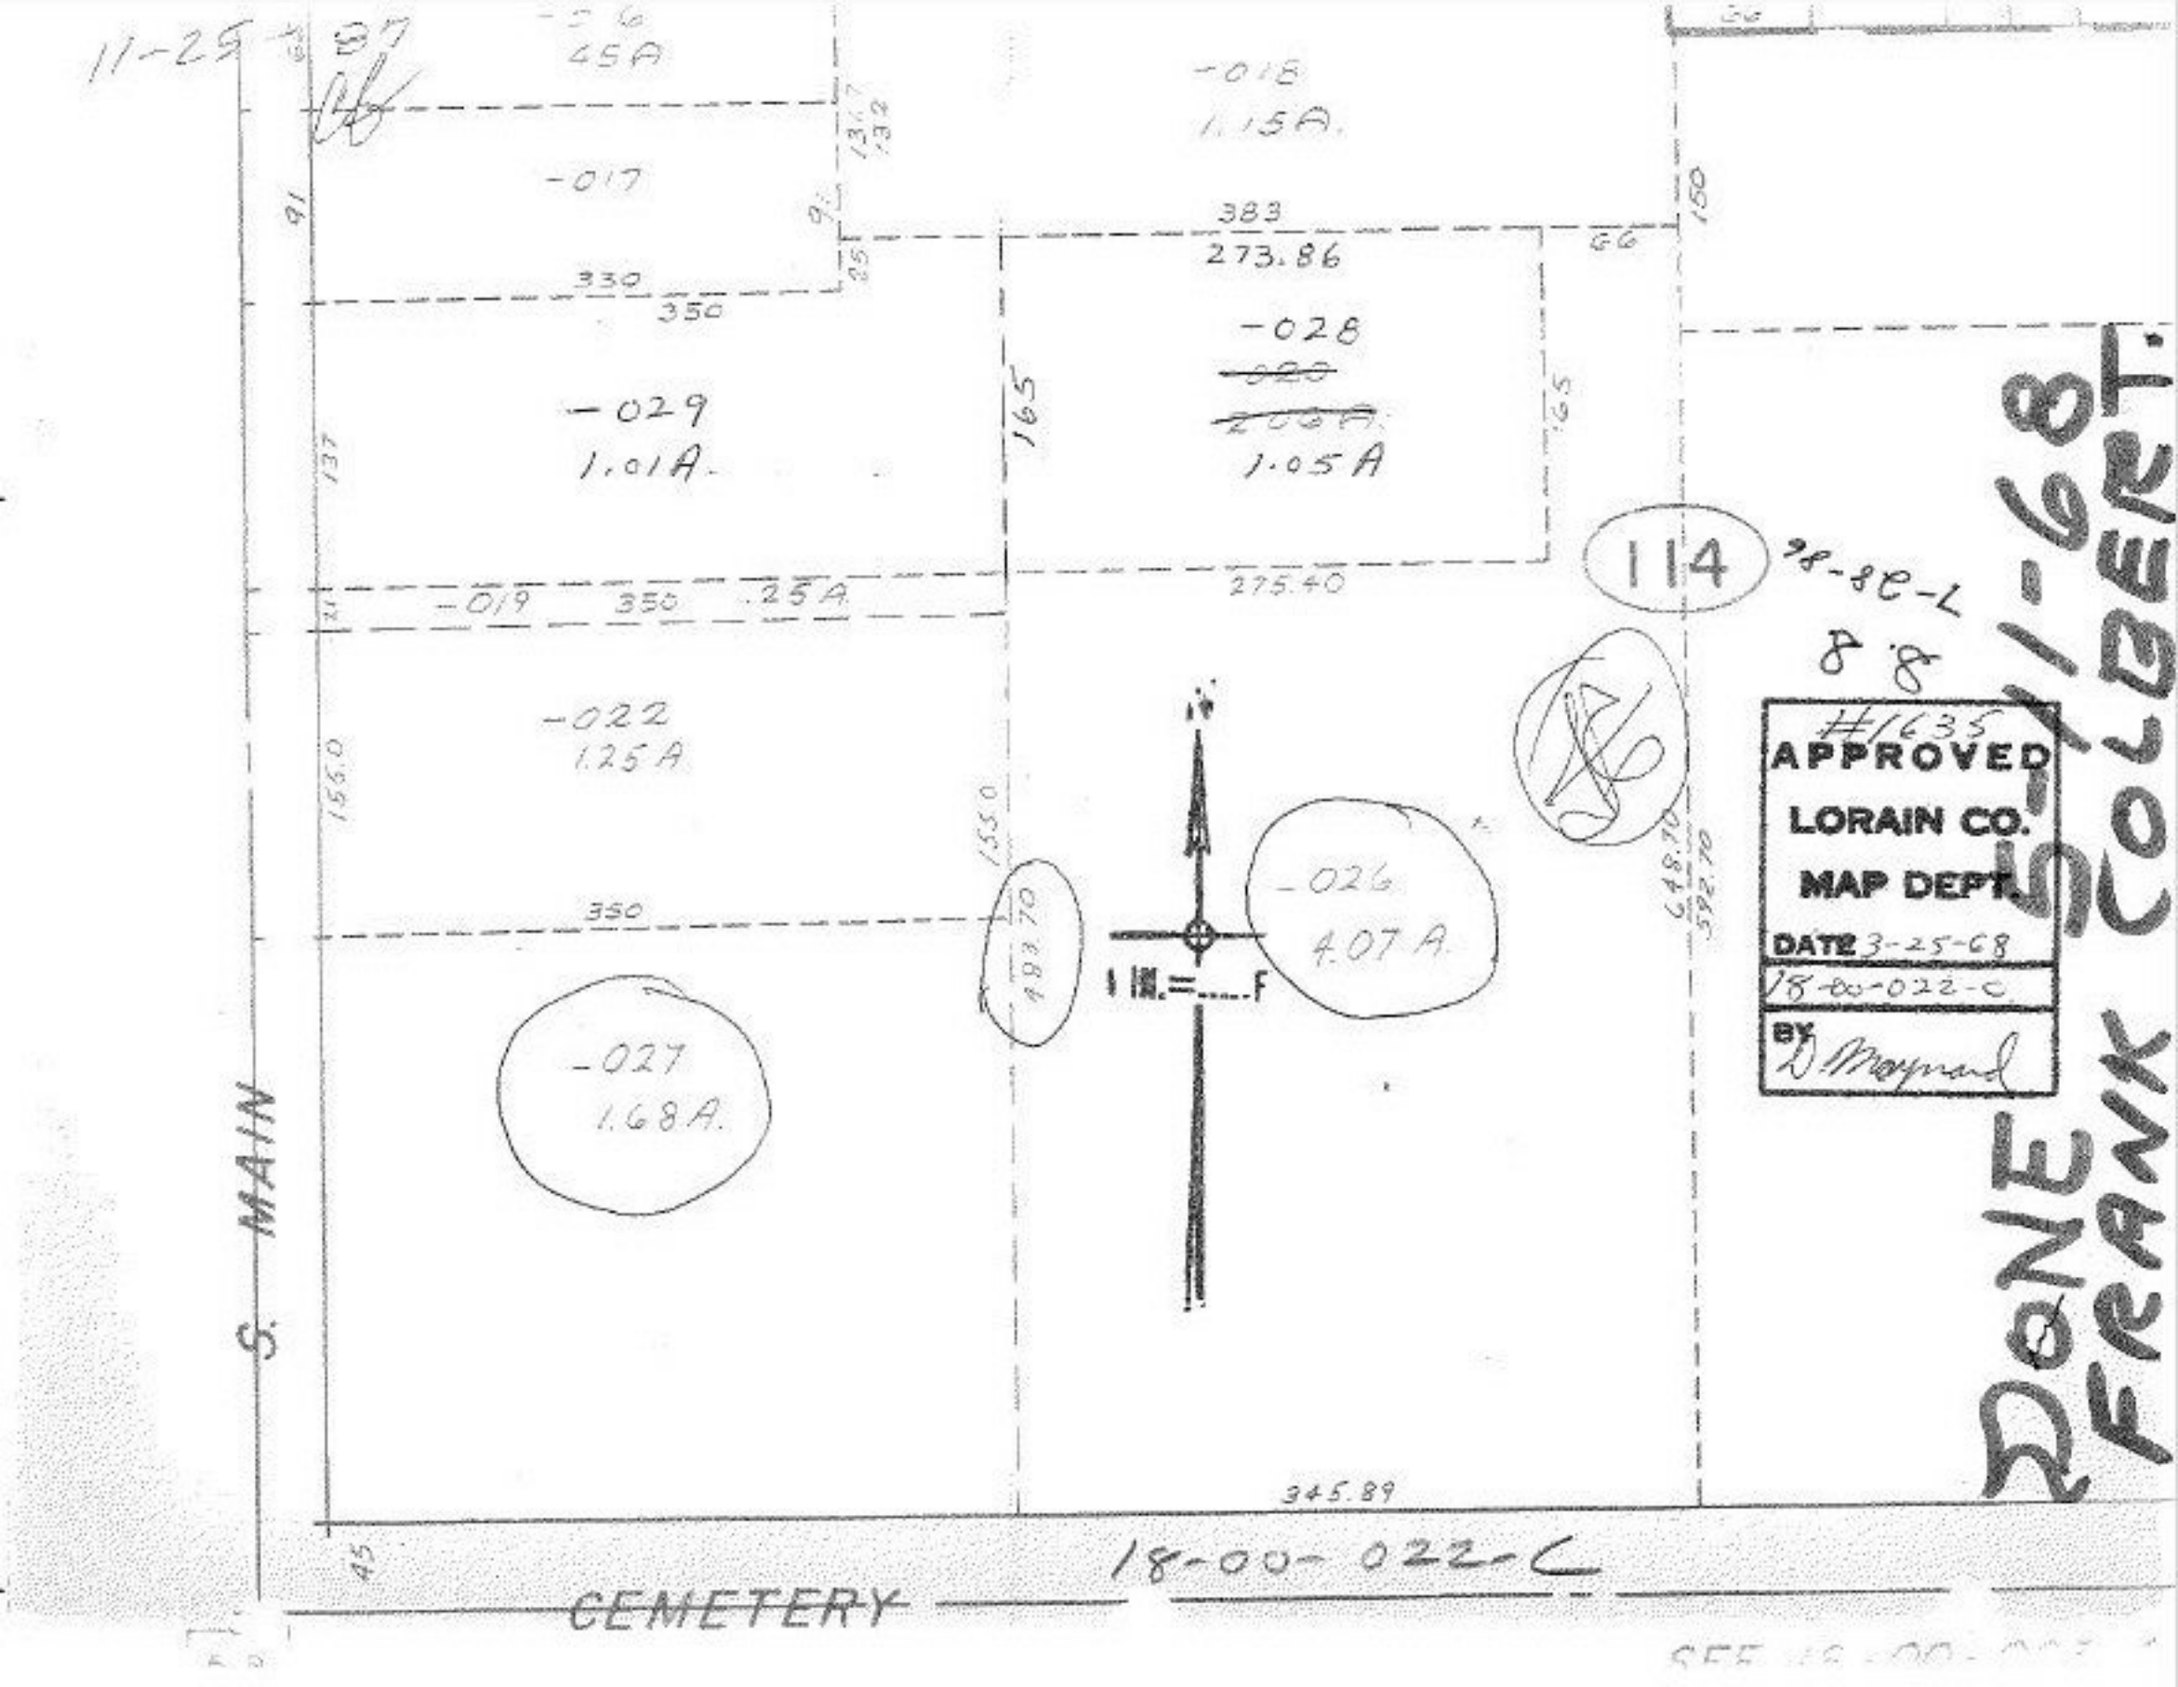
11-25
-016
45A
-017
1.15A.
383
273.86
330
350
-028
-029
1.01A.
1.05A
165
137
275.40
-019
350
.25A
-022
1.25A
155.0
193.70
350
-026
4.07 A.
-027
1.68A.
648.70
592.70
345.89
45
S. MAIN
CEMETERY
18-00-022-C
114
38-8C-L
8 8
#1635
APPROVED
LORAIN CO.
MAP DEPT.
DATE 3-25-68
18-00-022-C
BY D. Maynard
DONE 3-11-68
FRANK COLBERT