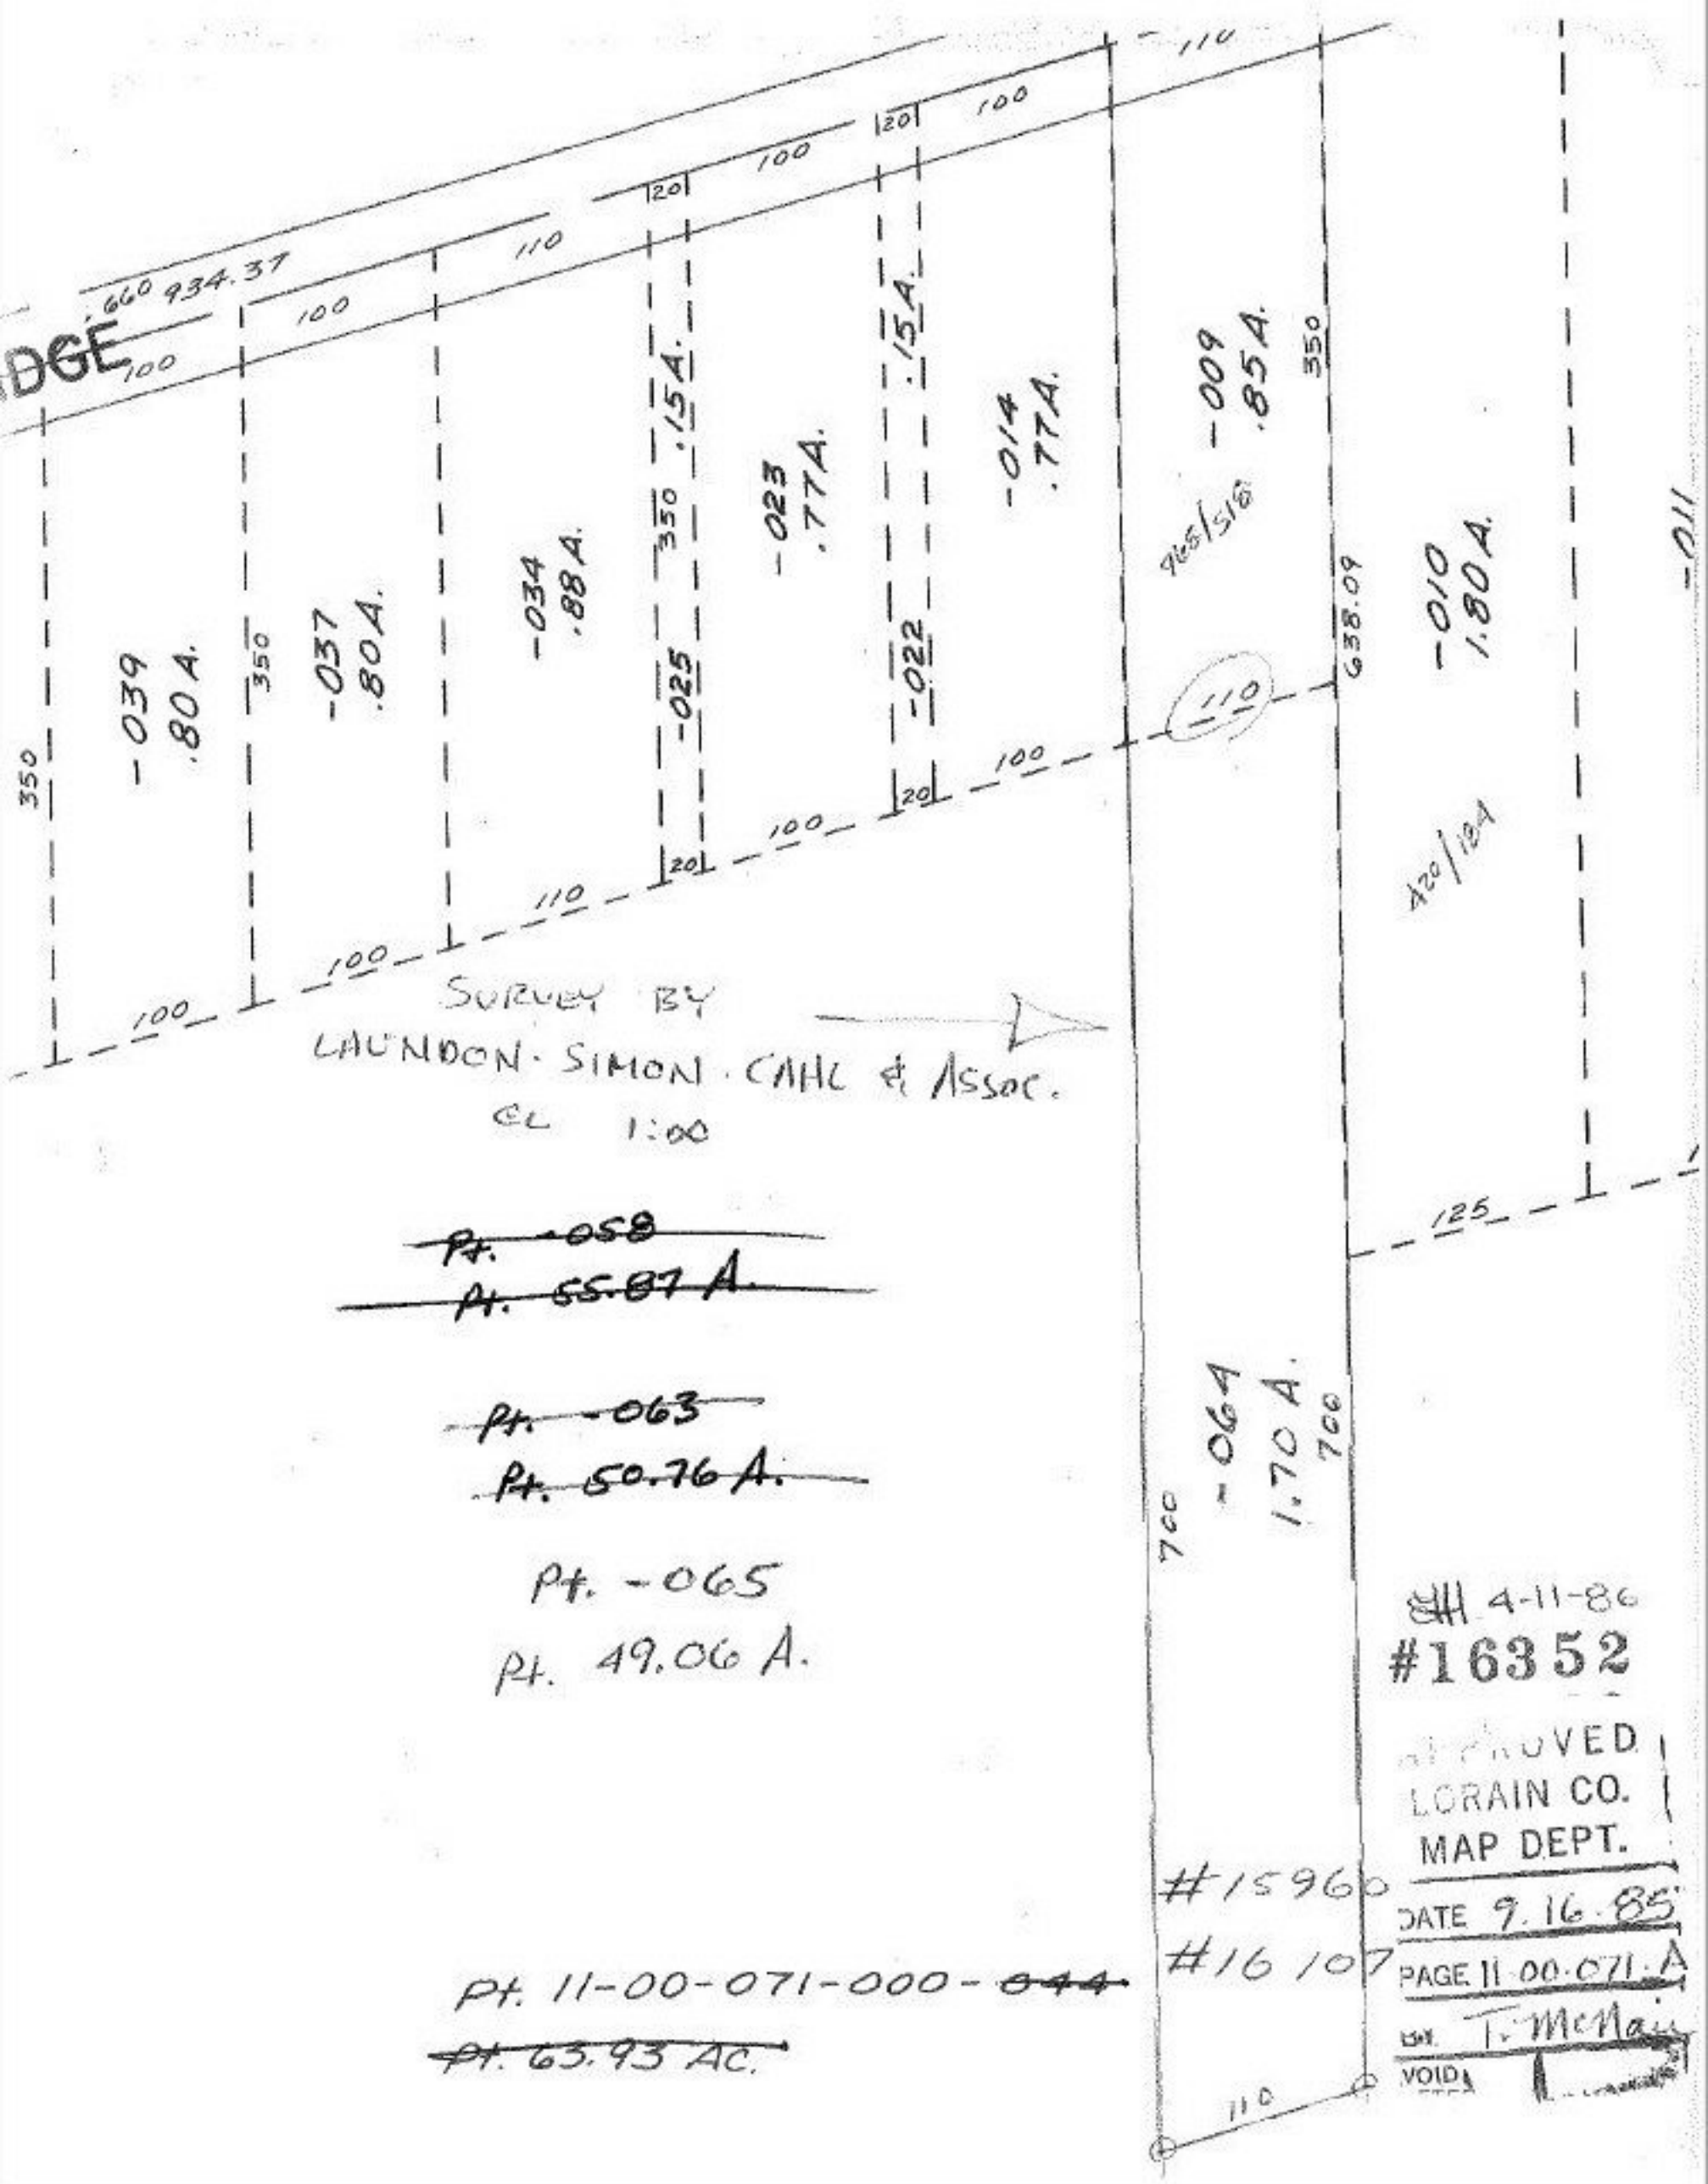
DGE
.660 934.37
-039
.80 A.
-037
.80 A.
-034
.88 A.
-025
.15 A.
-023
.77 A.
-022
.15 A.
-014
.77 A.
-009
.85 A.
-010
1.80 A.
-011
965/518
420/184
638.09
SURVEY BY
LAUNDON · SIMON · CAHL & ASSOC.
CL 1:00
Pt. -058
Pt. 55.87 A.
Pt. -063
Pt. 50.76 A.
Pt. -065
Pt. 49.06 A.
-064
1.70 A.
#15960
#16107
Pt. 11-00-071-000-044
Pt. 63.93 AC.
4-11-86
#16352
APPROVED
LORAIN CO.
MAP DEPT.
DATE 9.16.85
PAGE 11-00-071-A
BY T. McNair
VOID