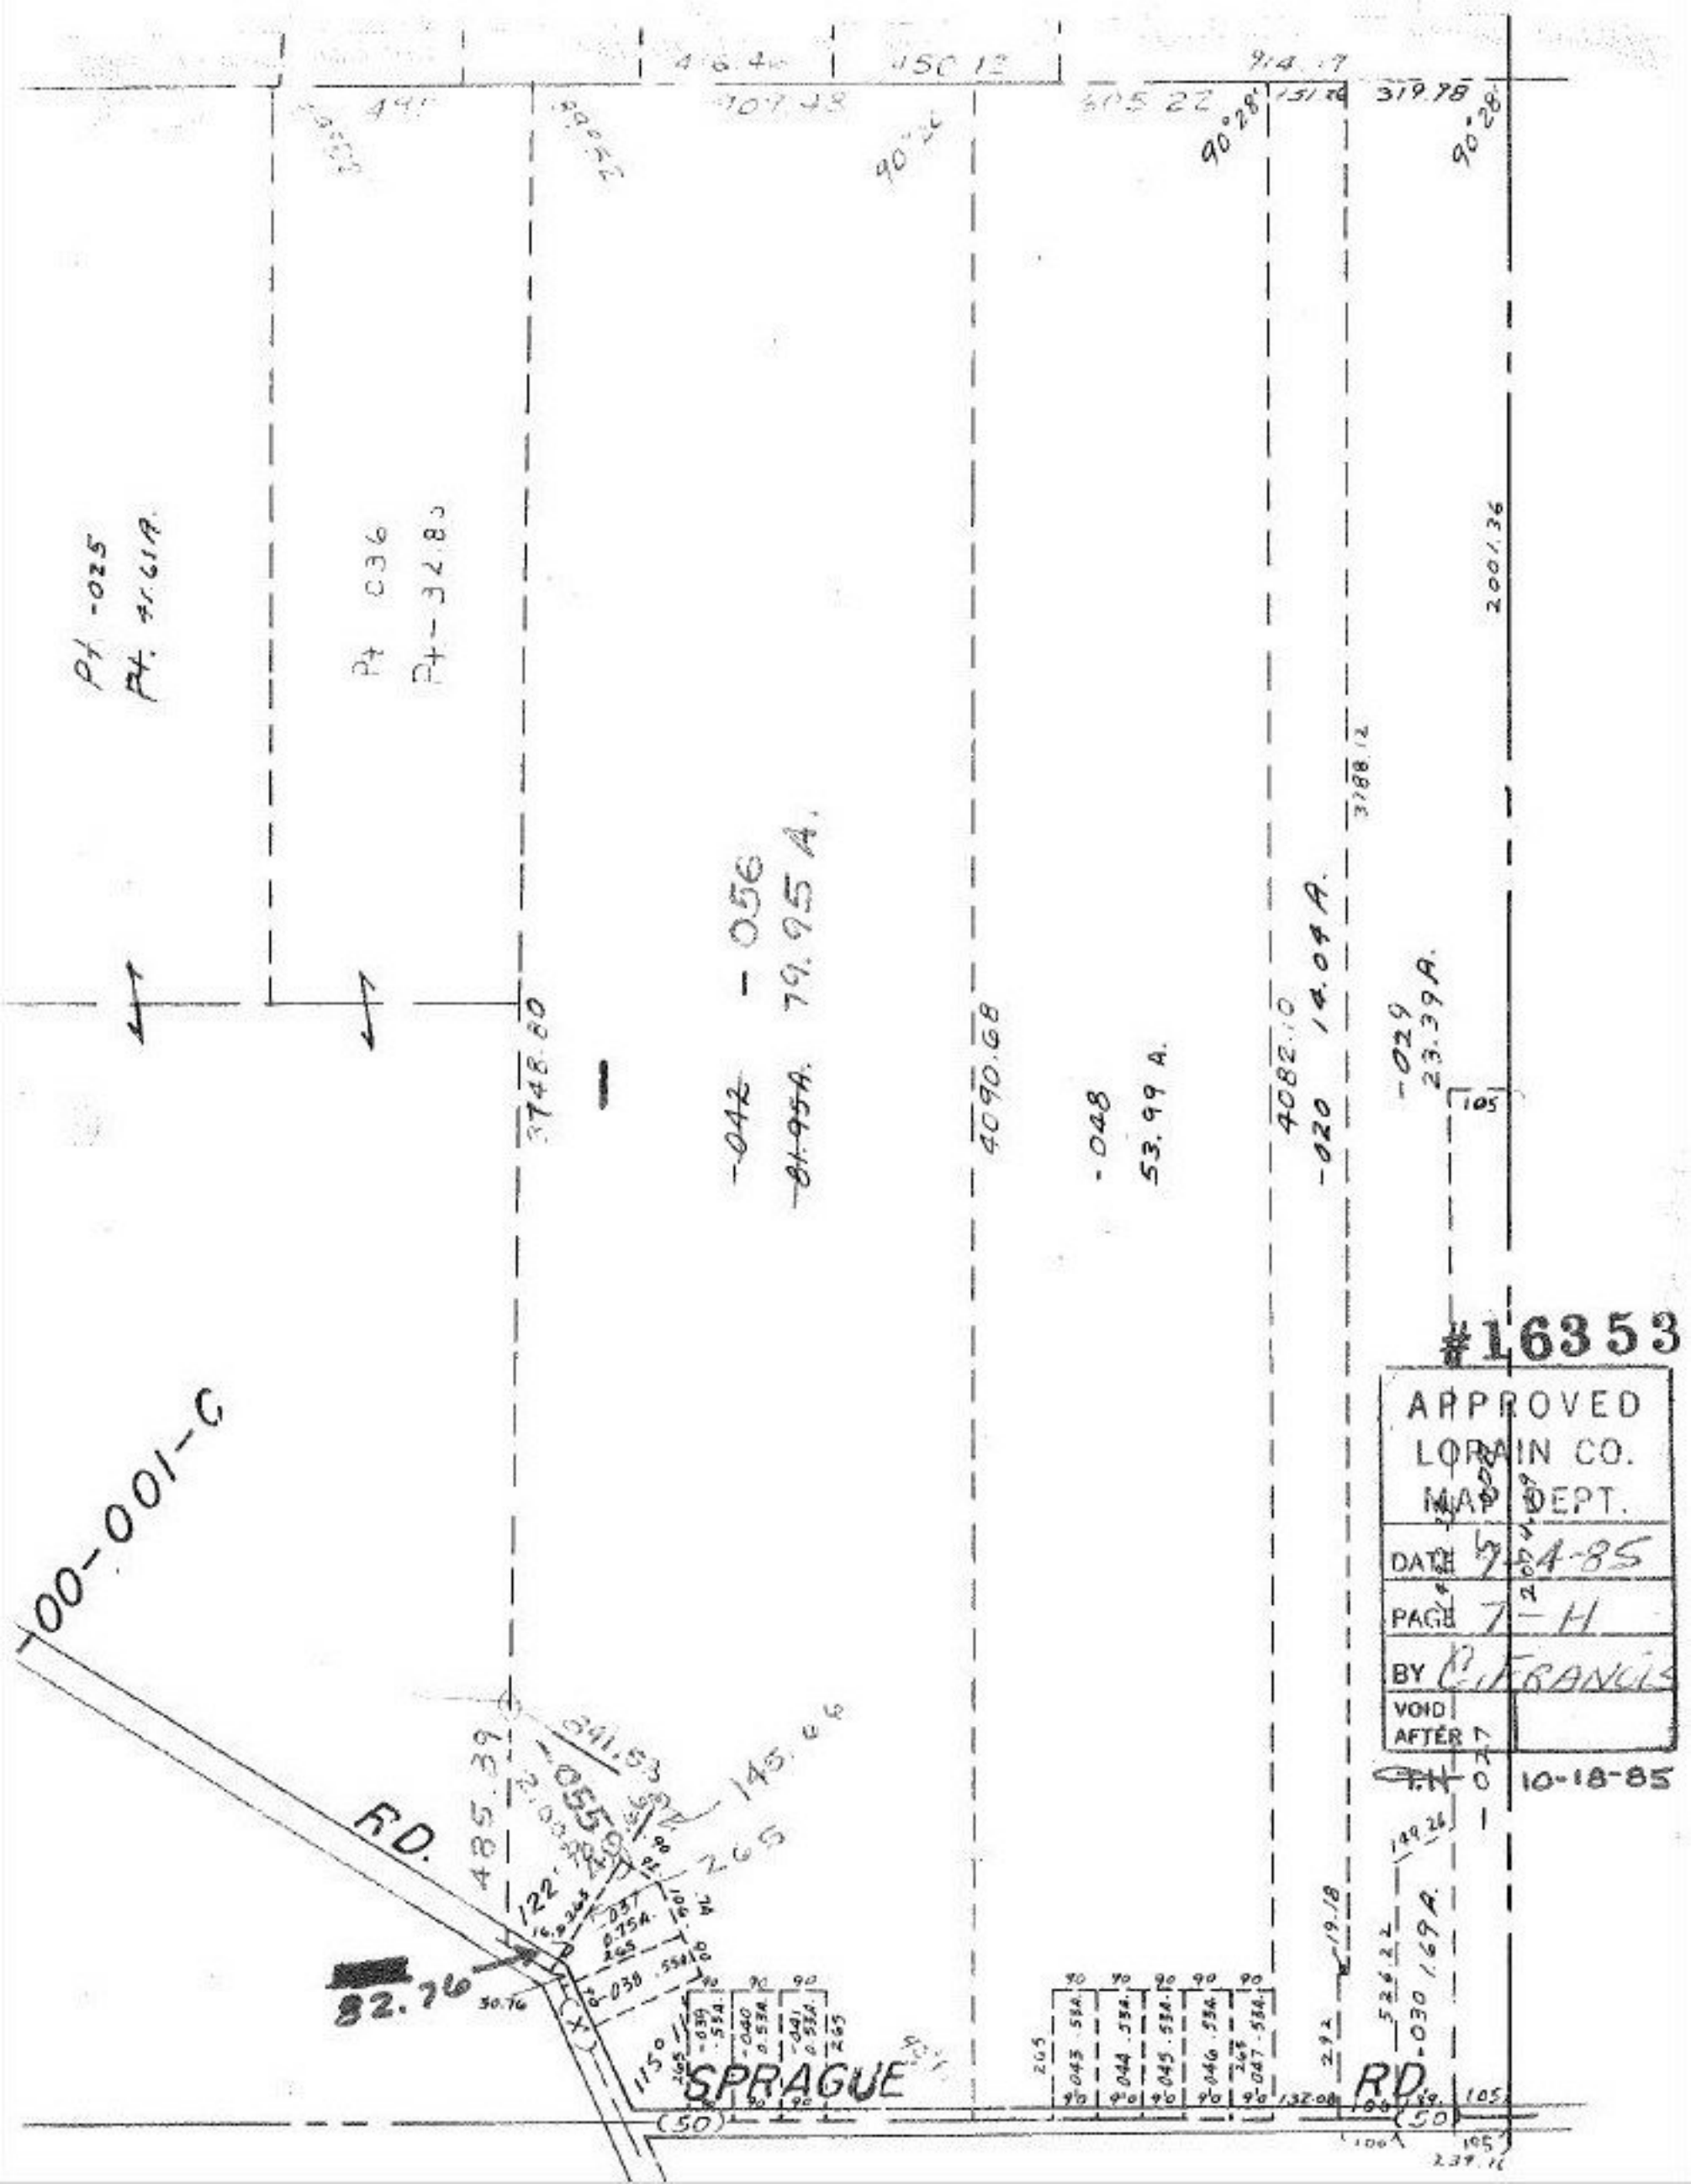

#16353
APPROVED
LORAIN CO.
MAP DEPT.
DATE 7-4-85
PAGE 7-H
BY C. FRANCIS
VOID
AFTER
10-18-85
SPRAGUE RD.
RD.
-00-001-C
82.76
3748.80
4090.68
4082.10
3188.12
2001.36
319.78
90°28'
90°26'
-056
79.95 A.
-042
81.95A.
-048
53.99 A.
-020
14.04 A.
-029
23.39 A.
-030
1.69 A.
485.39
145.66
265