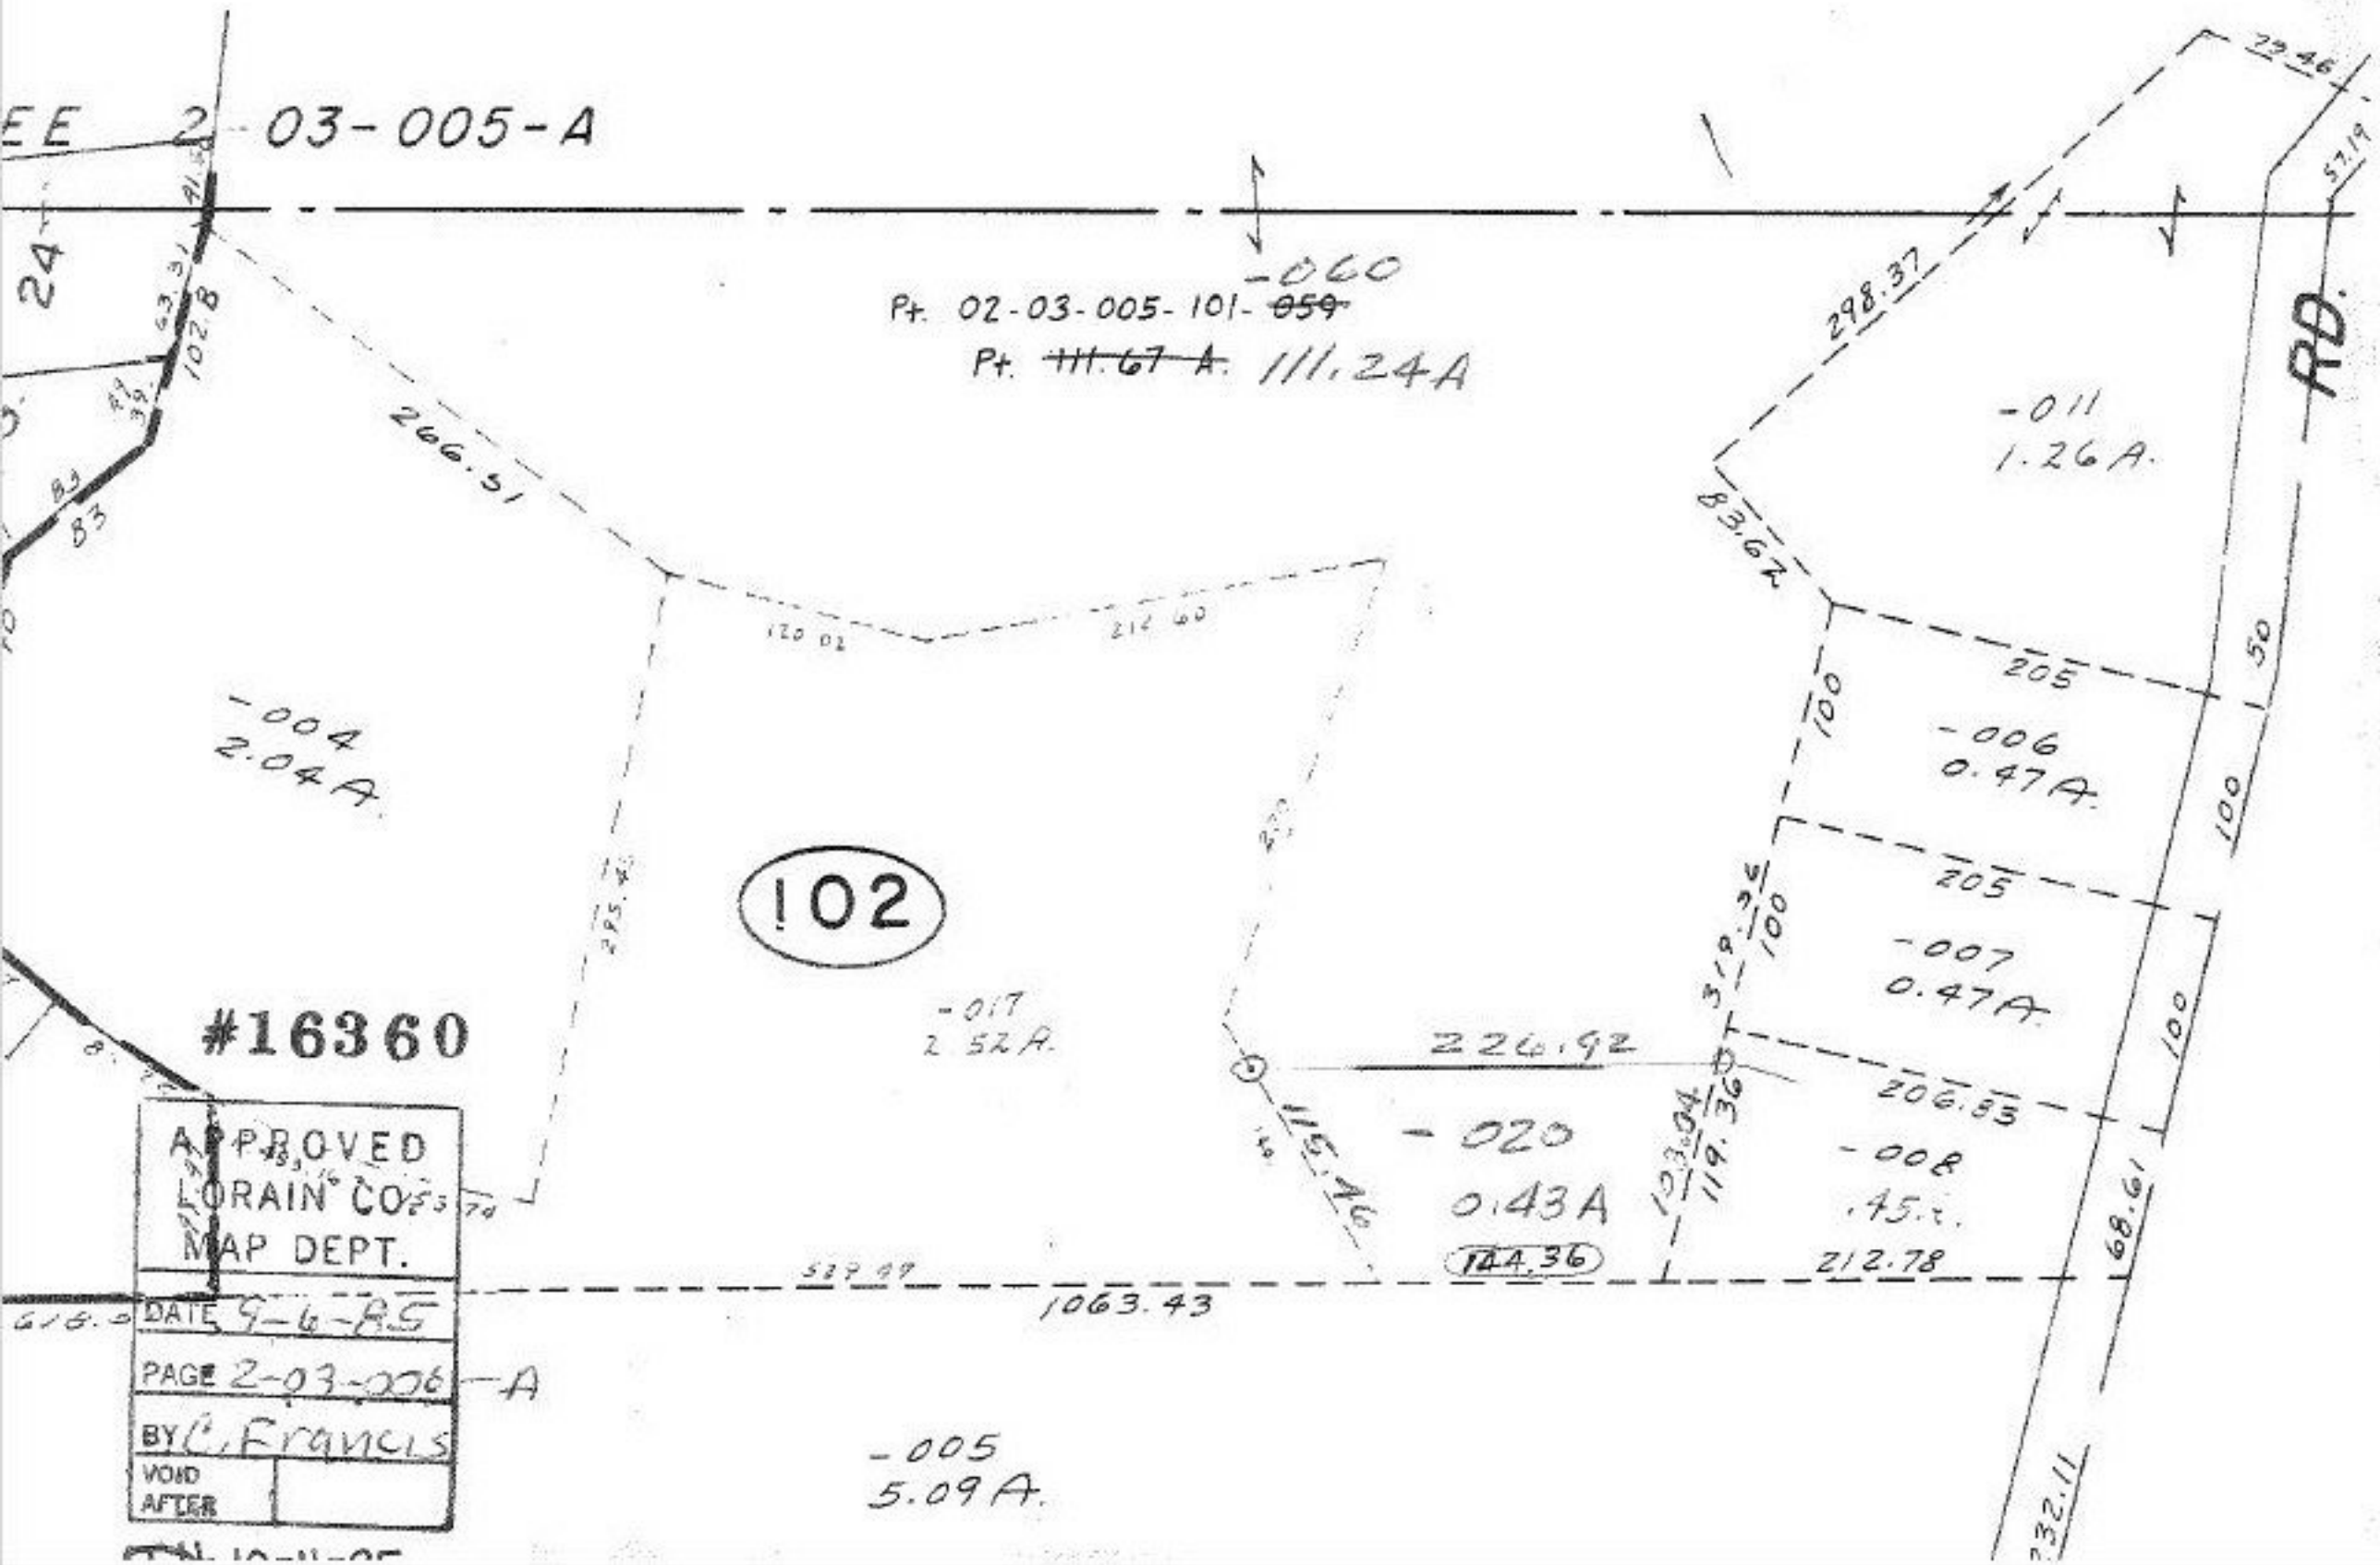

EE 2-03-005-A
24
102.8
83
266.51
120.02
212.60
-004
2.04A.
102
-017
2.52A.
#16360
APPROVED
LORAIN CO.
MAP DEPT.
DATE 9-6-85
PAGE 2-03-006-A
BY C. Francis
VOID AFTER
Pt. 02-03-005-101-~~059~~ -060
Pt. ~~111.67 A.~~ 111.24A
298.37
83.62
-011
1.26A.
RD.
57.19
73.46
205
-006
0.47A.
100
50
205
-007
0.47A.
100
319.36
226.92
206.83
-020
0.43A
144.36
115.46
103.04
119.36
-008
.45A.
212.78
68.61
1063.43
-005
5.09A.
232.11