MAP CORR.

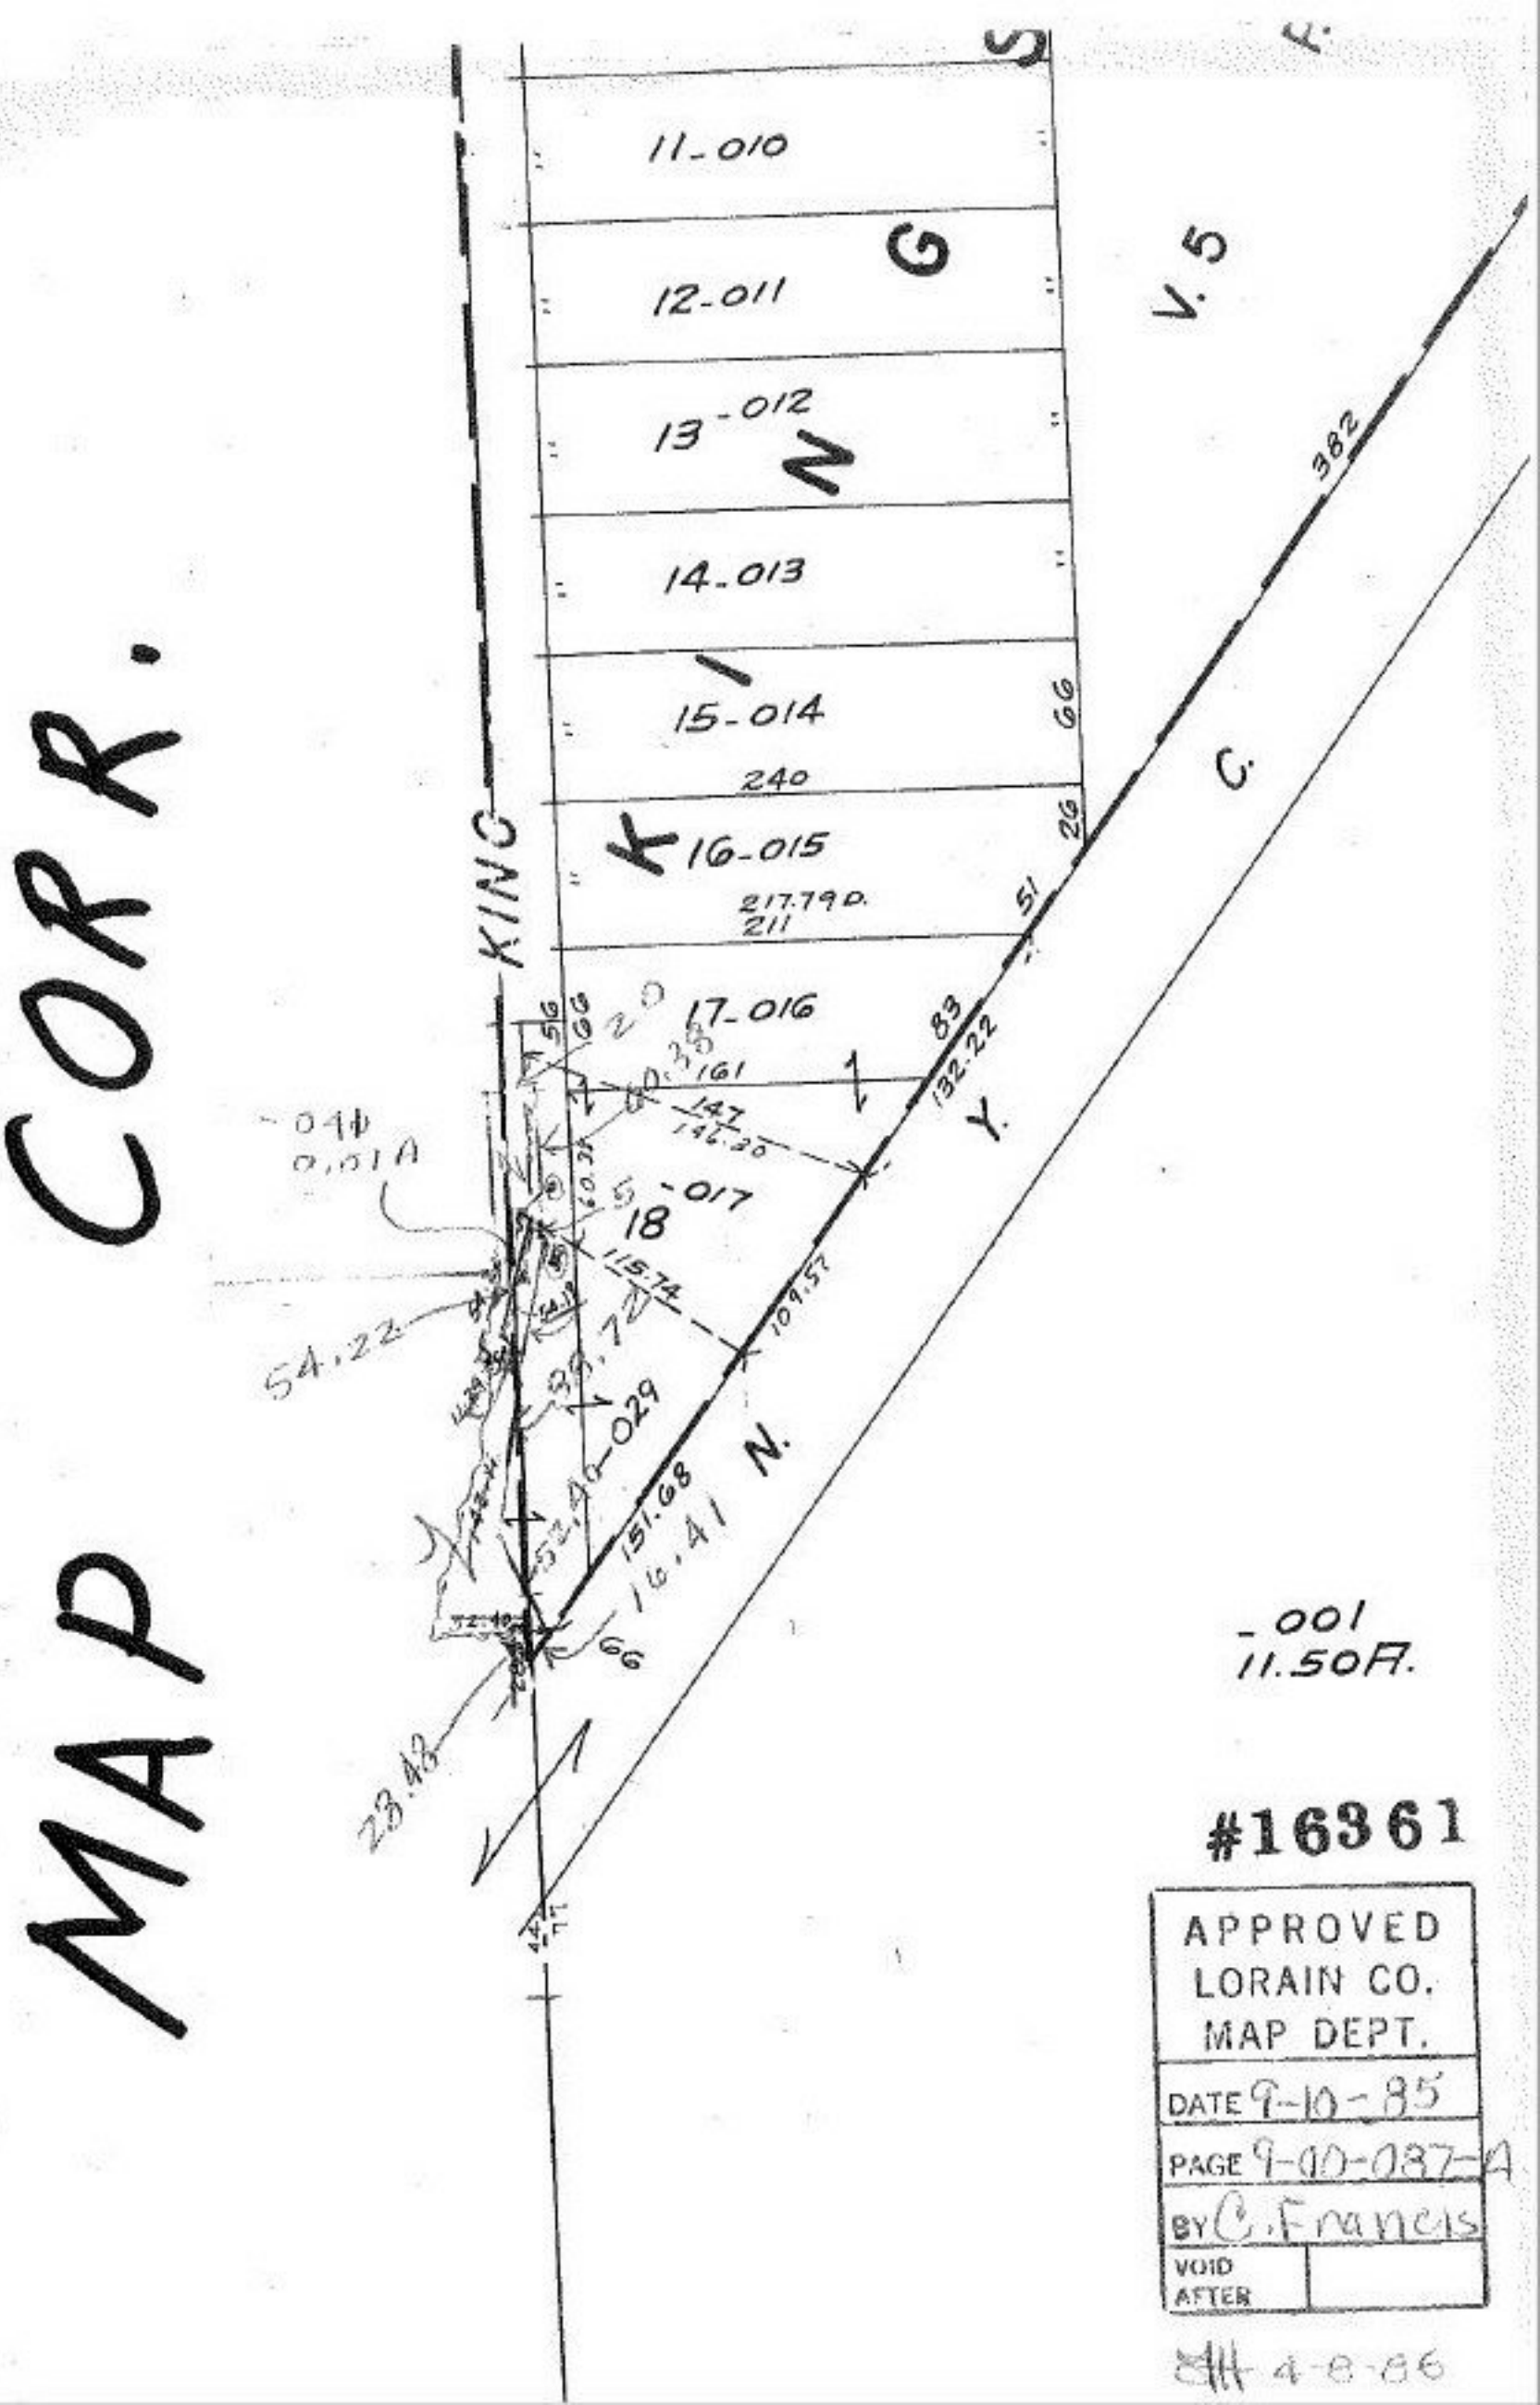

#16361

APPROVED
LORAIN CO.
MAP DEPT.

DATE 9-10-85

PAGE 9-10-087-A

BY C. Francis

VOID AFTER

4-8-86