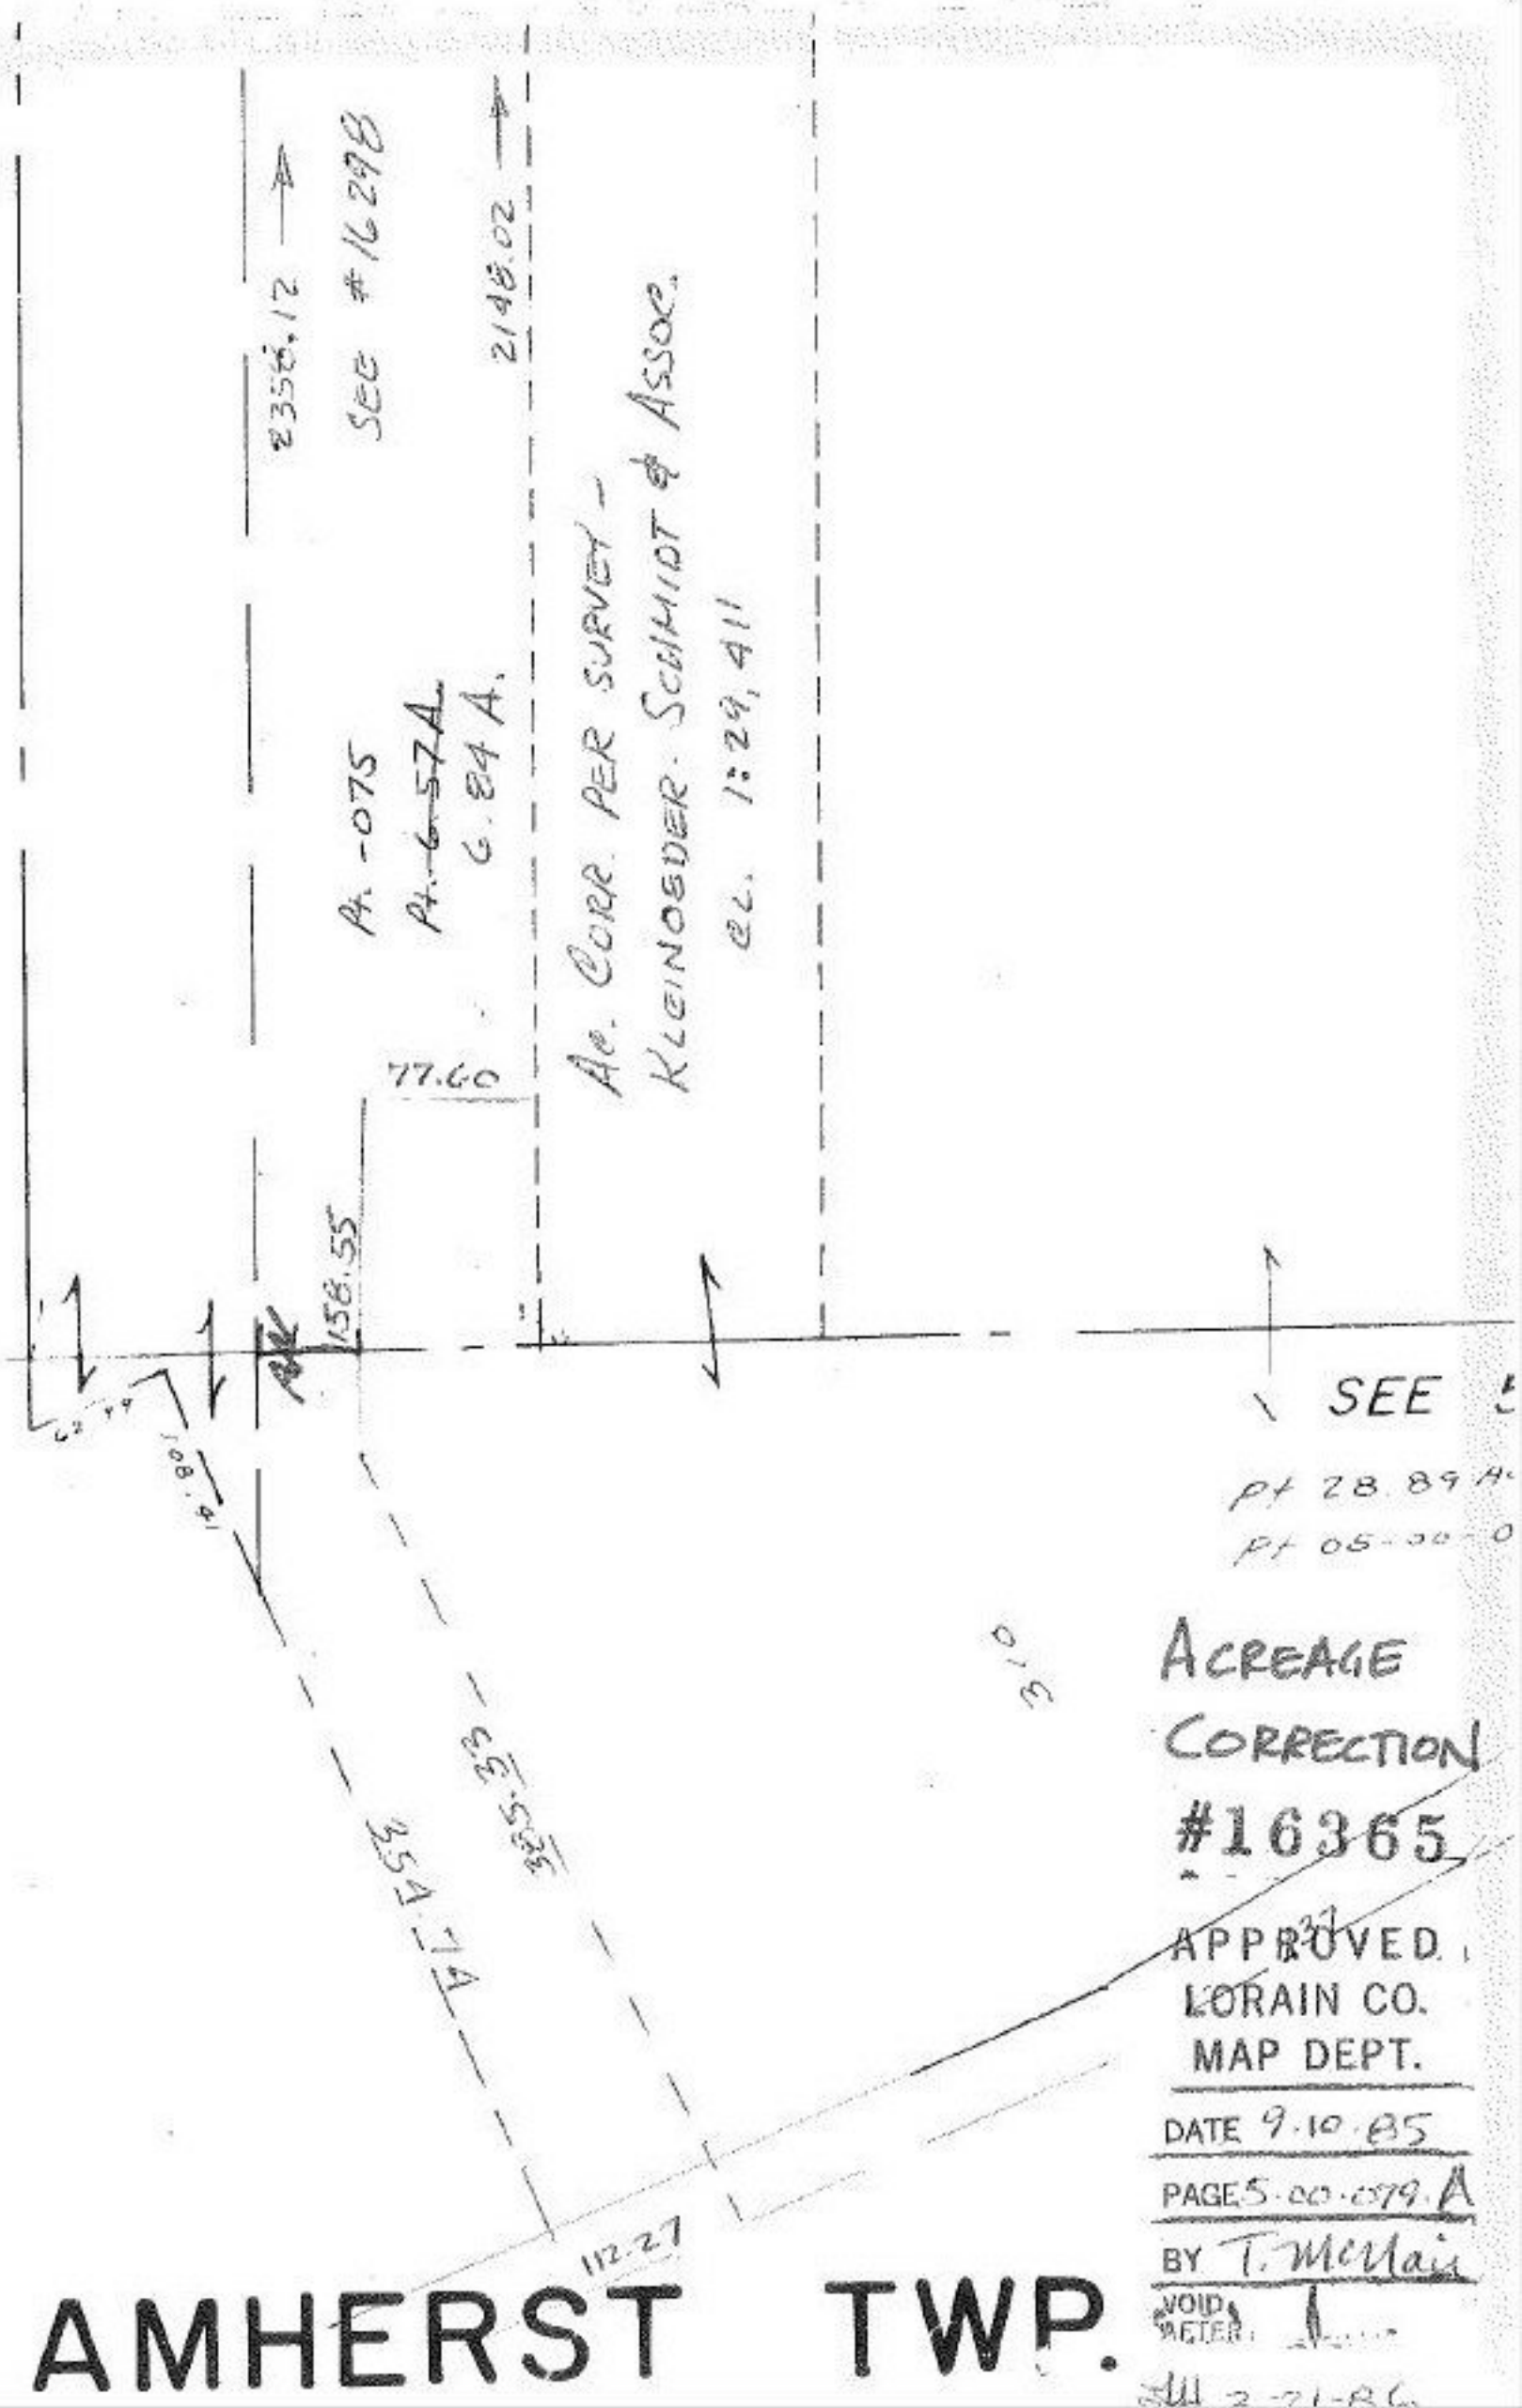

ACREAGE CORRECTION
#16365

APPROVED
LORAIN CO.
MAP DEPT.

DATE 9.10.85
PAGE 5.00.079.A
BY T. McNair
VOID AFTER

AMHERST TWP.