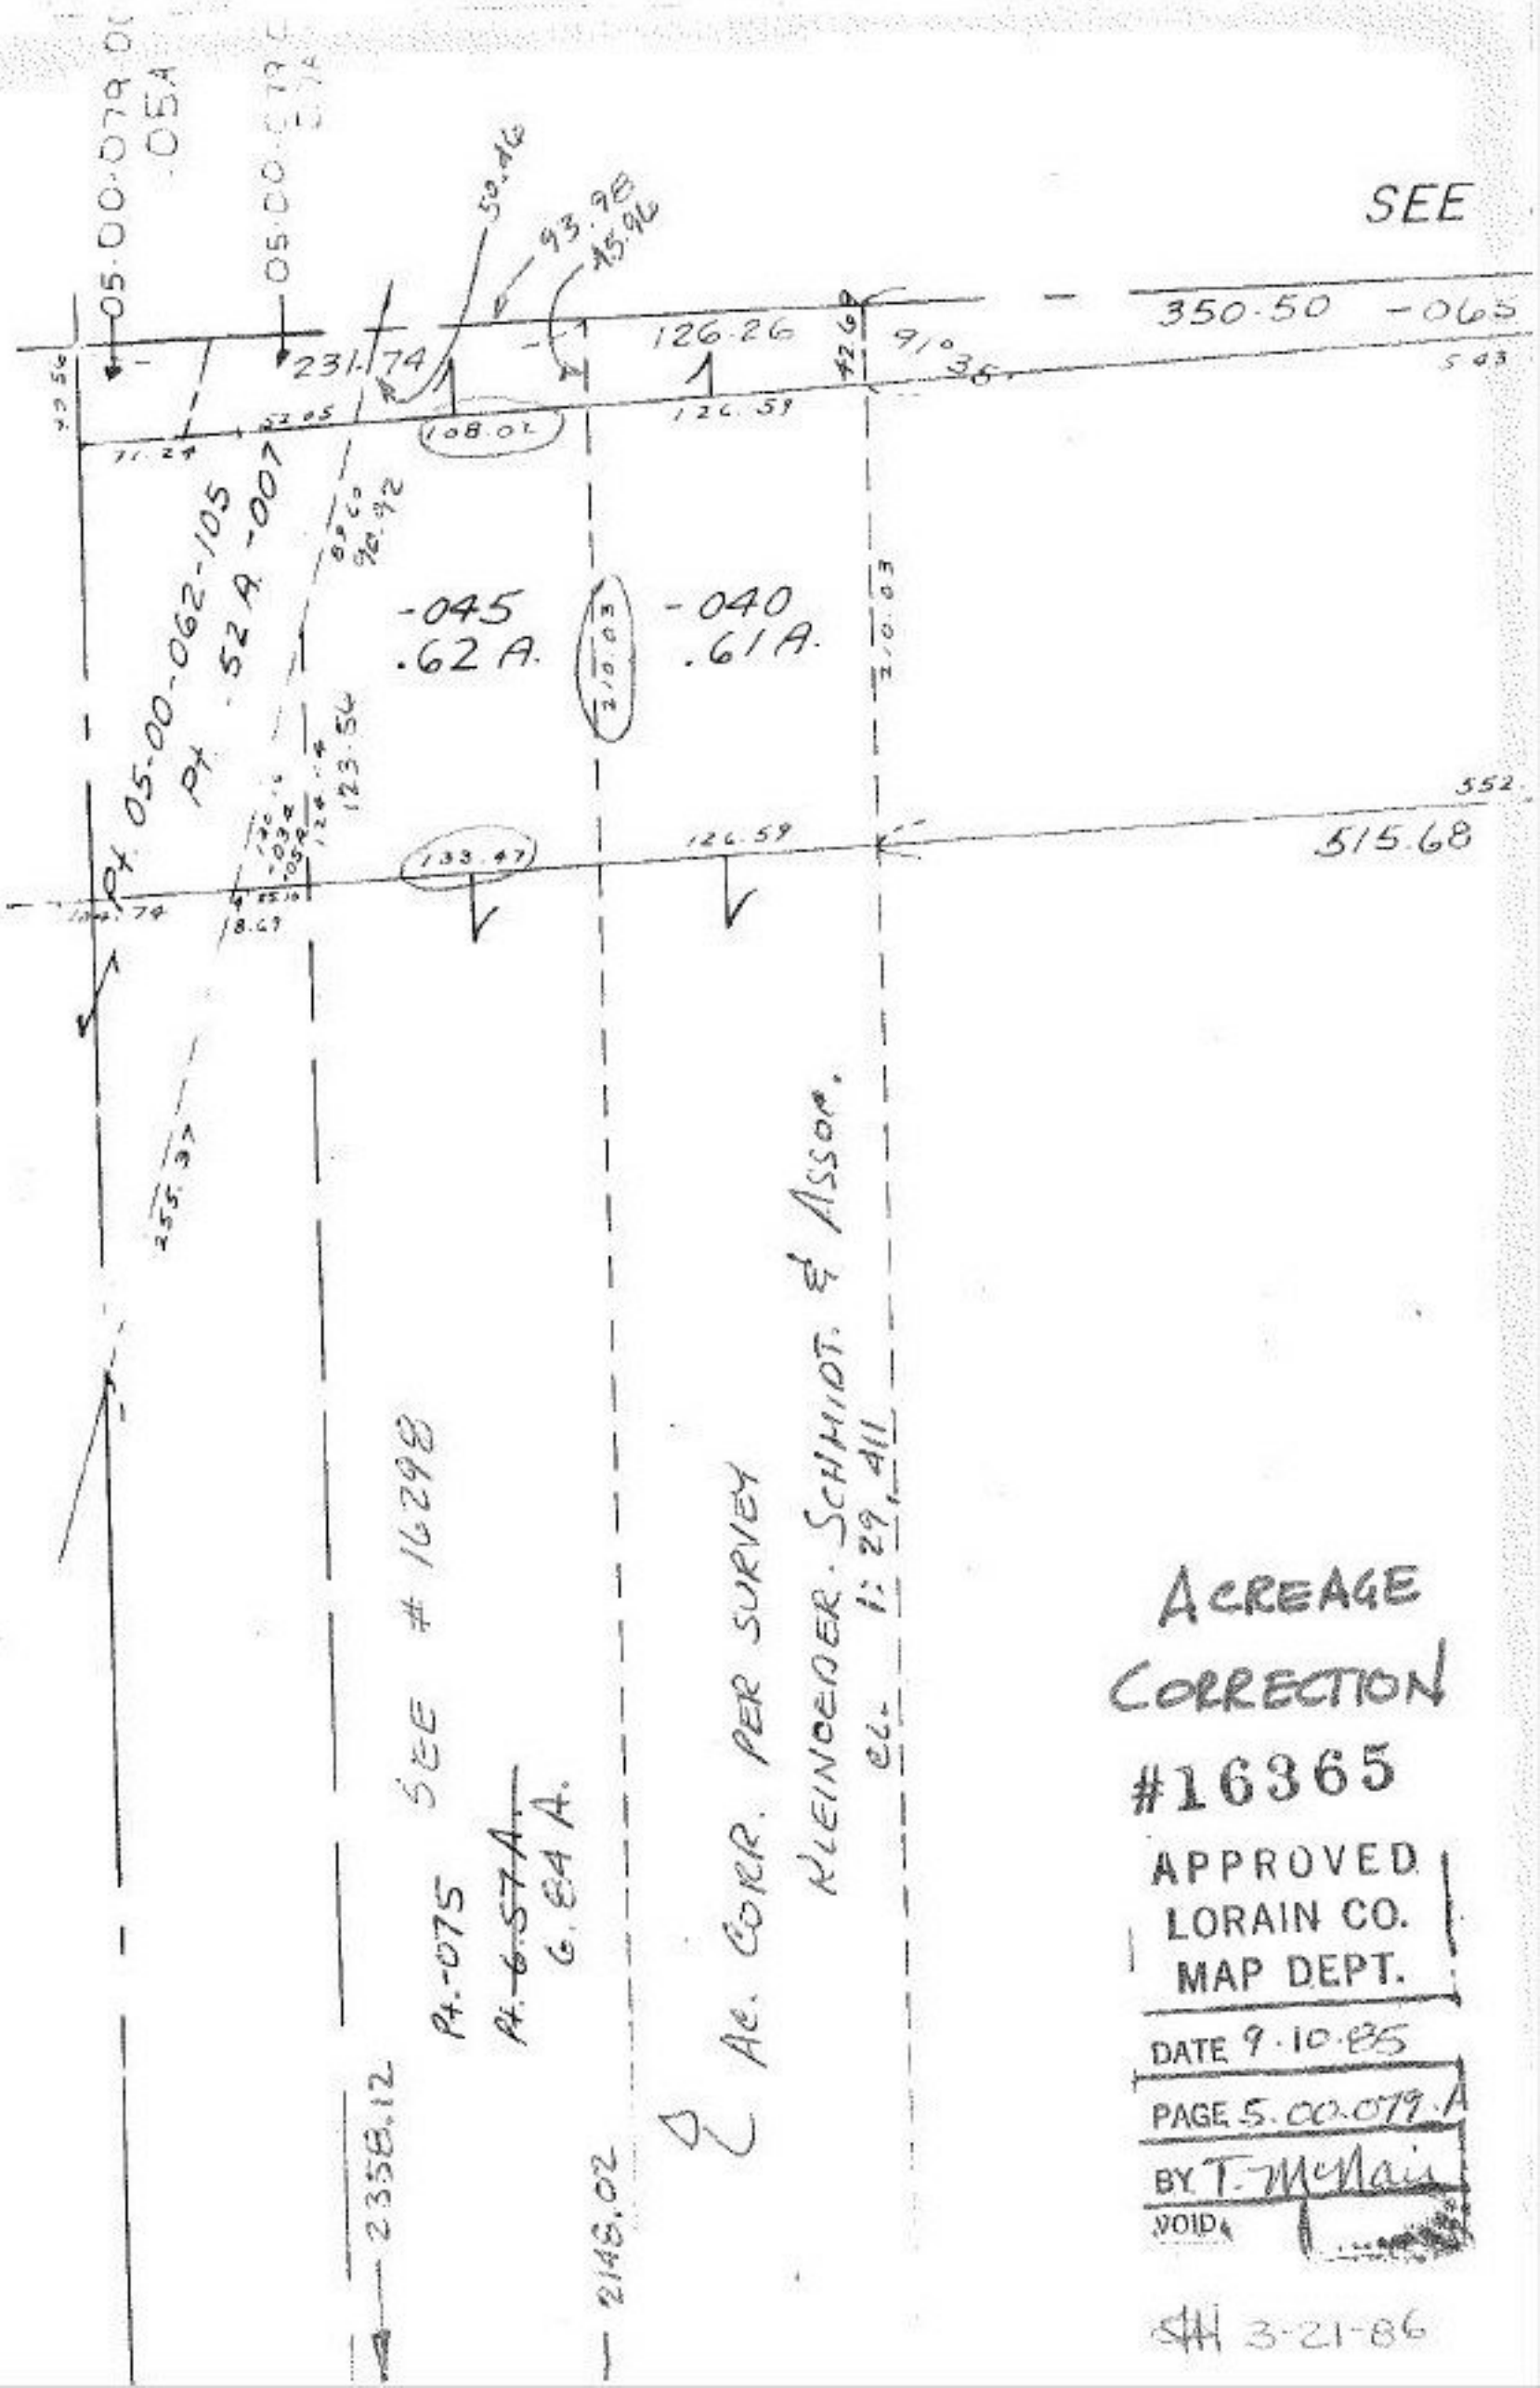

ACREAGE CORRECTION

#16365

APPROVED
LORAIN CO.
MAP DEPT.

DATE 9.10.85

PAGE 5.00.079.A

BY T. McNair

VOID

SH 3-21-86