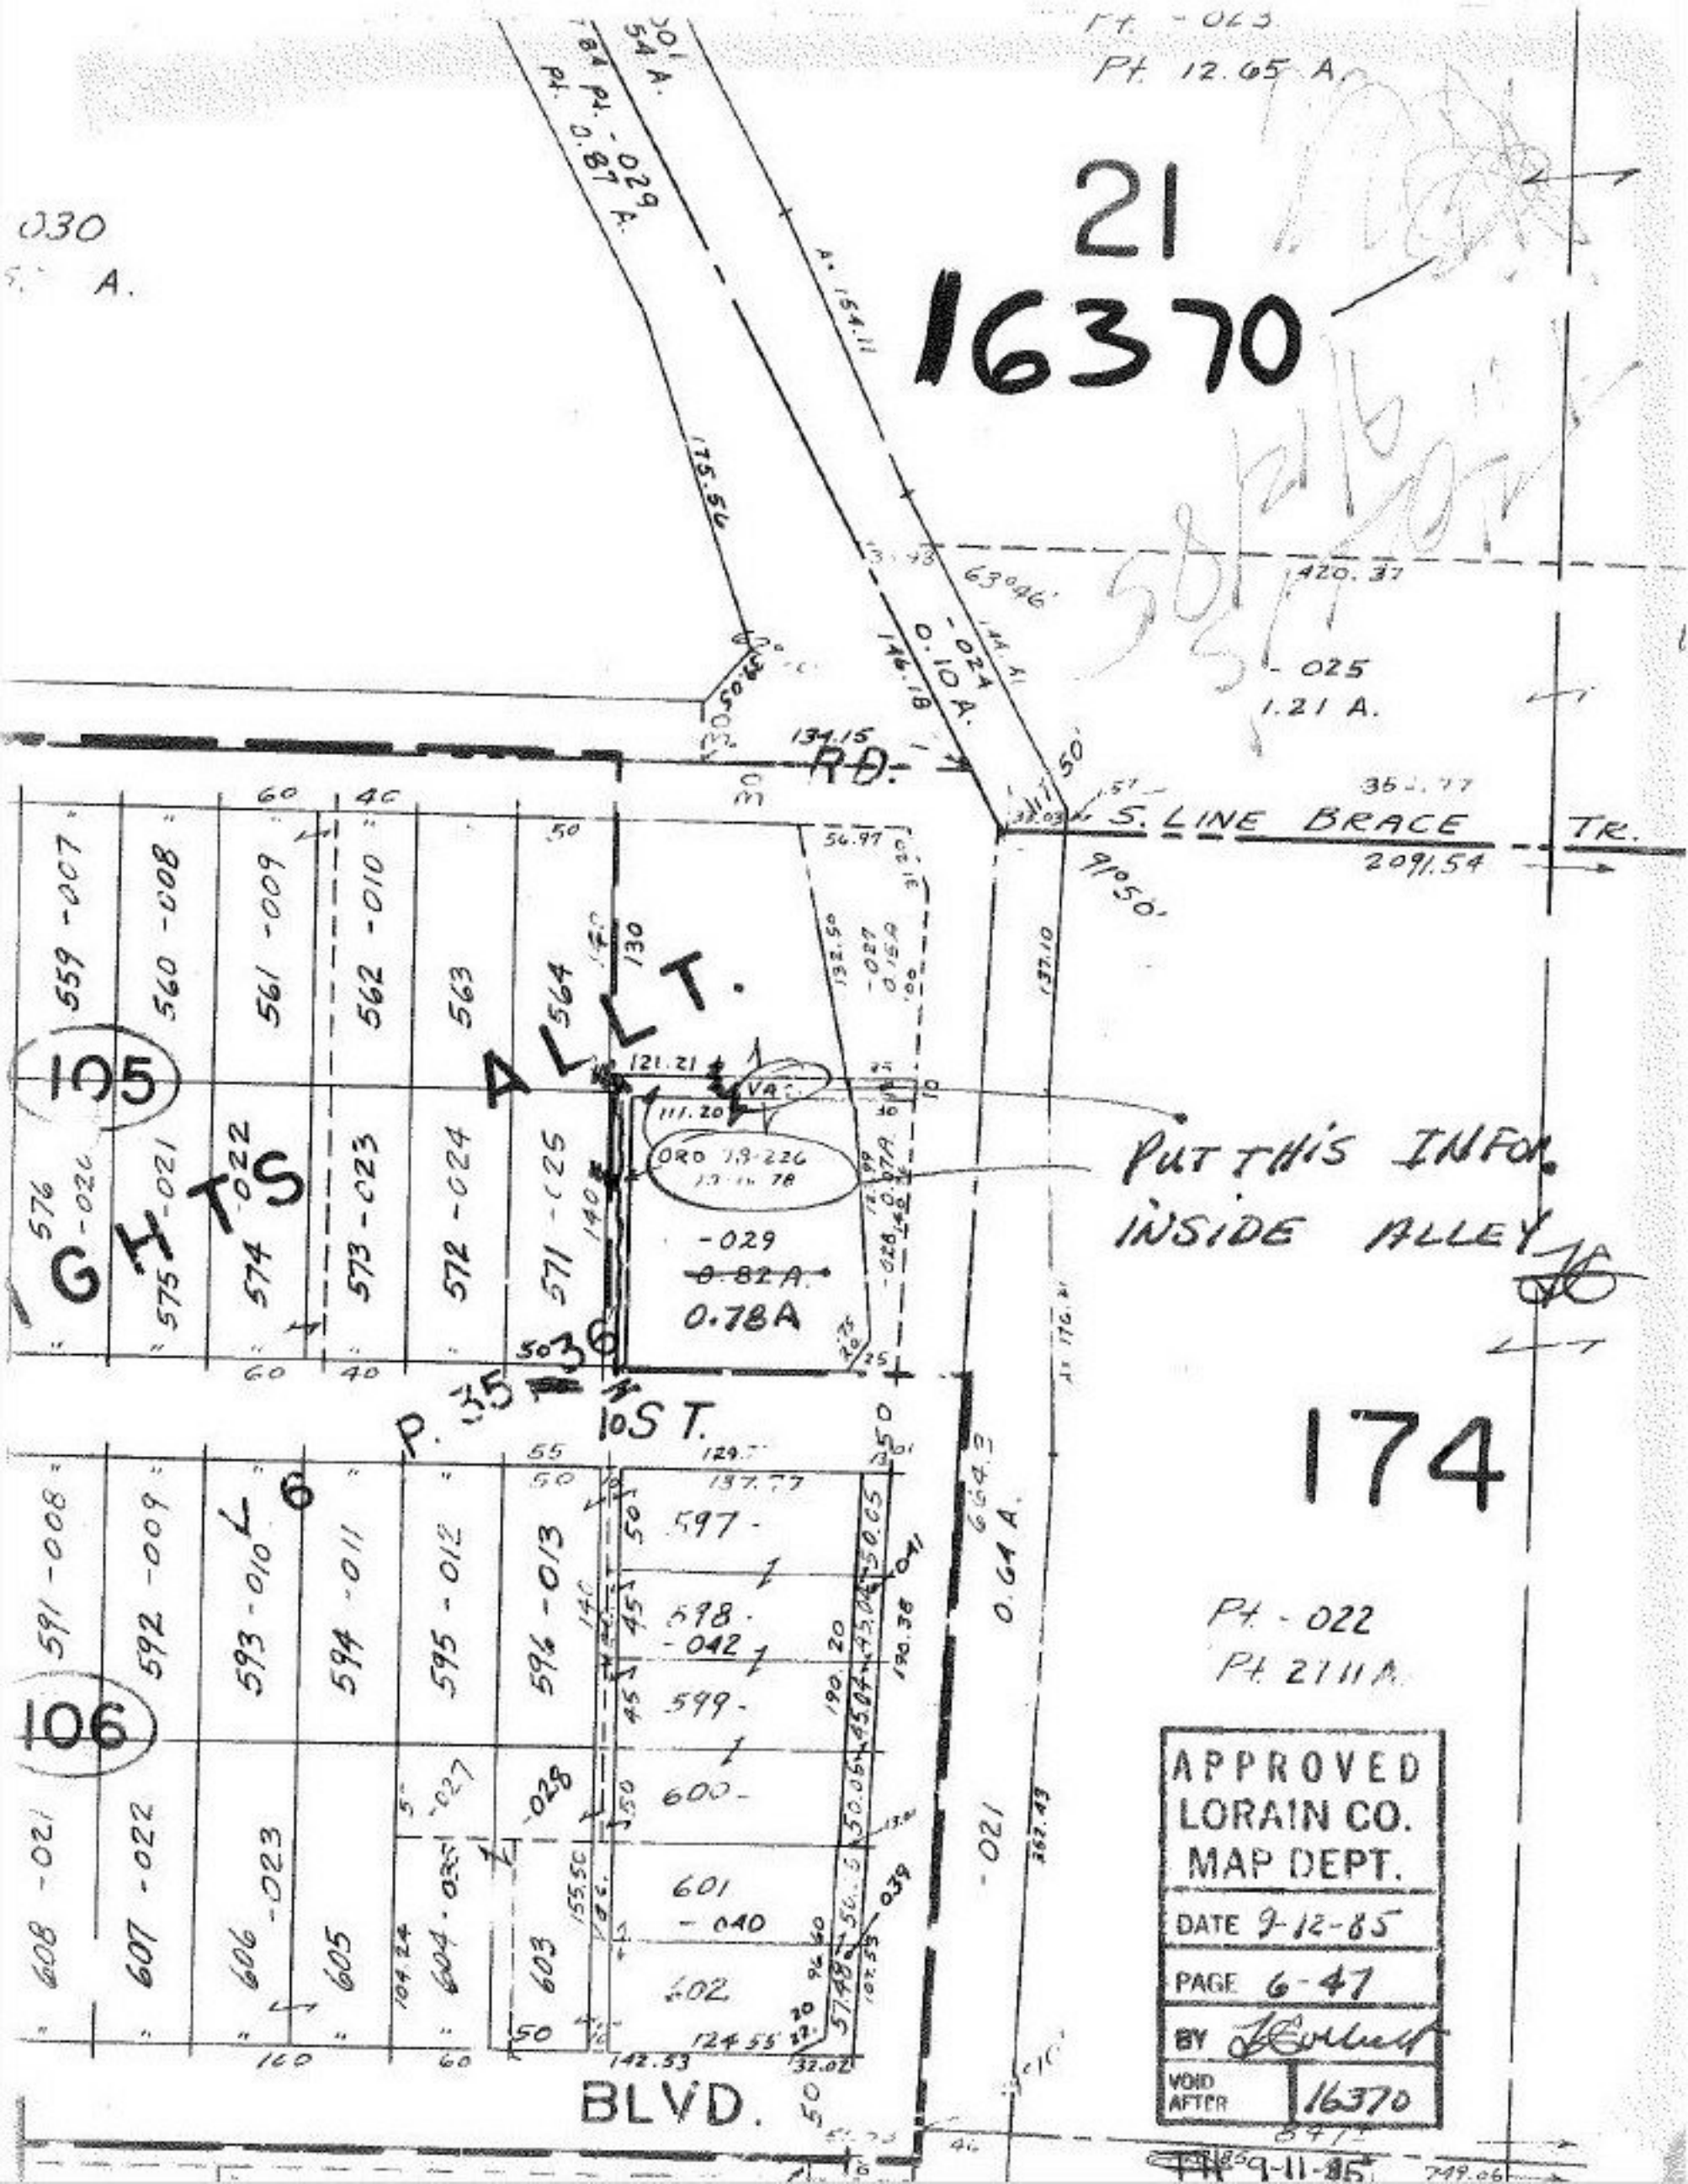

21
16370
Pt. 12.65 A.
030
A.
-025
1.21 A.
-024
0.10 A.
RD.
S. LINE BRACE TR.
2091.54
ALLT.
105
GHTS
-029
0.78A
PUT THIS INFO. INSIDE ALLEY
174
P. 35
10 ST.
106
597
598
599
600
601
602
BLVD.
Pt. -022
Pt. 2.11 A.
APPROVED
LORAIN CO.
MAP DEPT.
DATE 9-12-85
PAGE 6-47
BY
VOID AFTER 16370
9-11-85