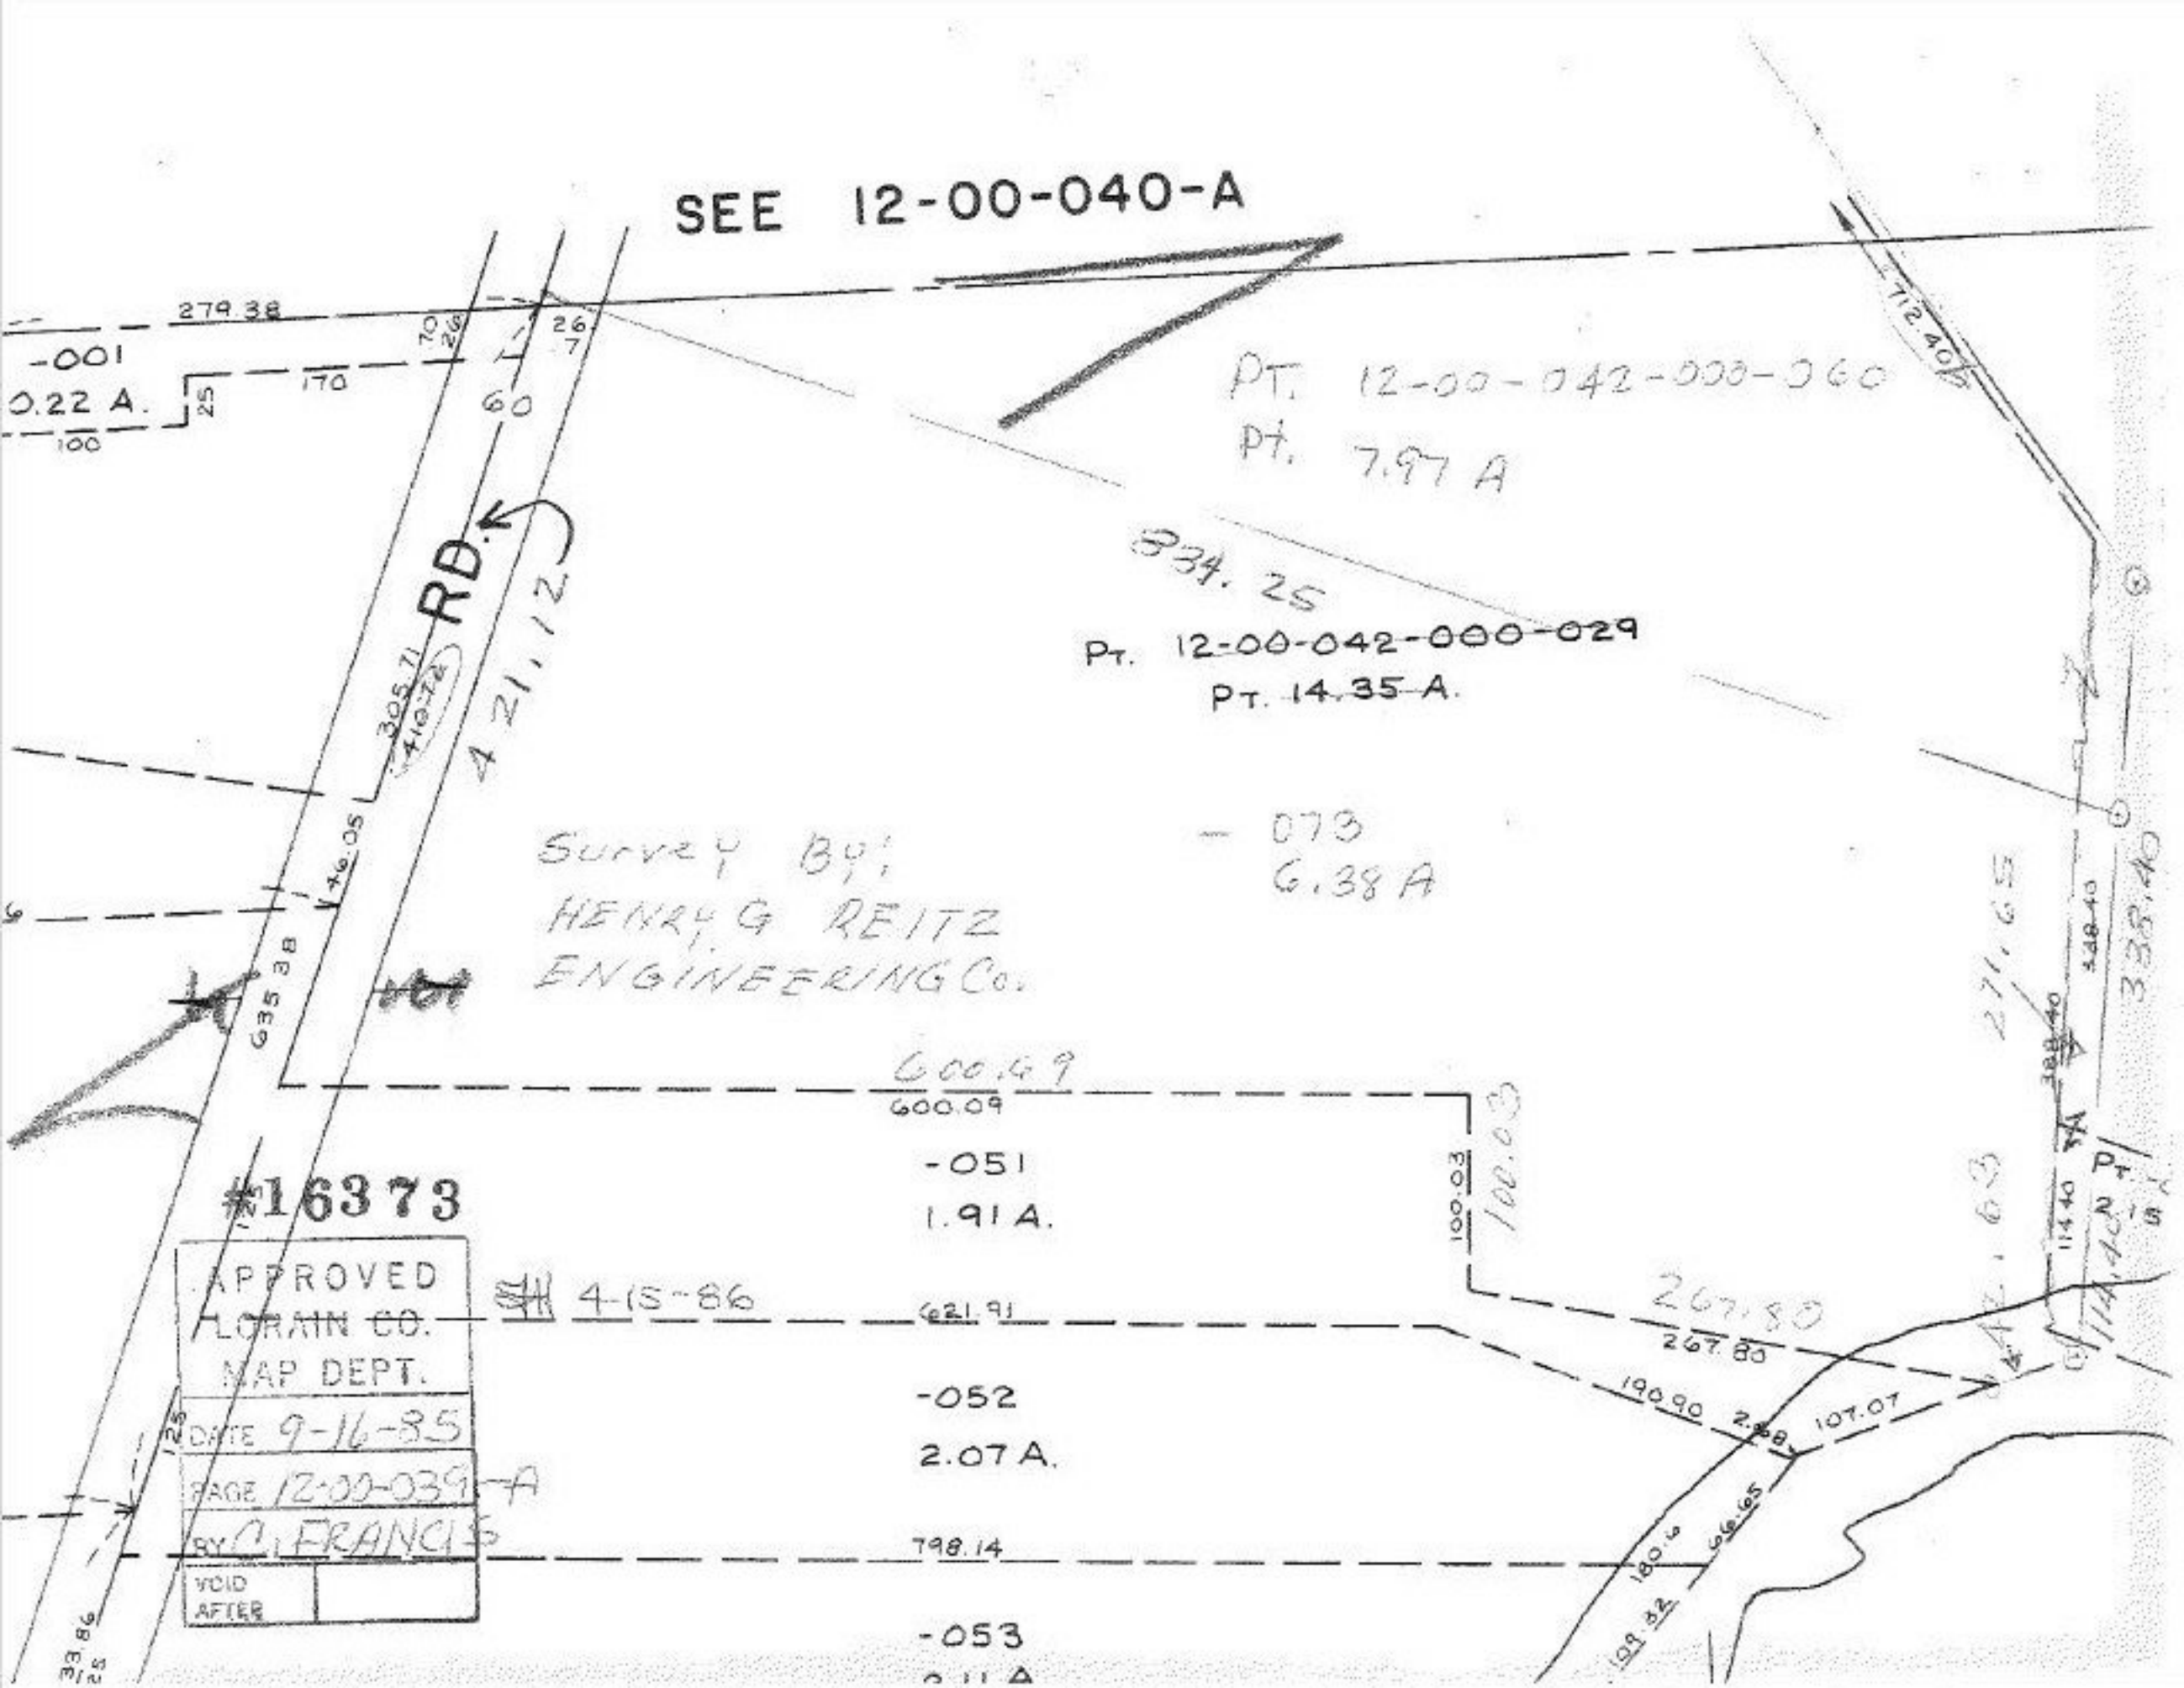
SEE 12-00-040-A
279.38
-001
0.22 A.
170
100
25
70
26
26
7
60
RD.
305.71
410.72
421.12
46.05
635.38
PT. 12-00-042-000-060
Pt. 7.97 A
834.25
PT. 12-00-042-000-029
PT. 14.35 A.
712.40
- 073
6.38 A
Survey By:
HENRY G REITZ
ENGINEERING Co.
600.69
600.09
-051
1.91 A.
100.03
100.03
#16373
APPROVED
LORAIN CO.
MAP DEPT.
DATE 9-16-85
PAGE 12-00-039-A
BY C. FRANCIS
VOID
AFTER
4-15-86
621.91
267.80
267.80
-052
2.07 A.
190.90
2.68
107.07
798.14
180.6
66.65
109.32
-053
271.65
338.40
348.40
388.40
114.40
114.40
PT.
2.15
33.86
25