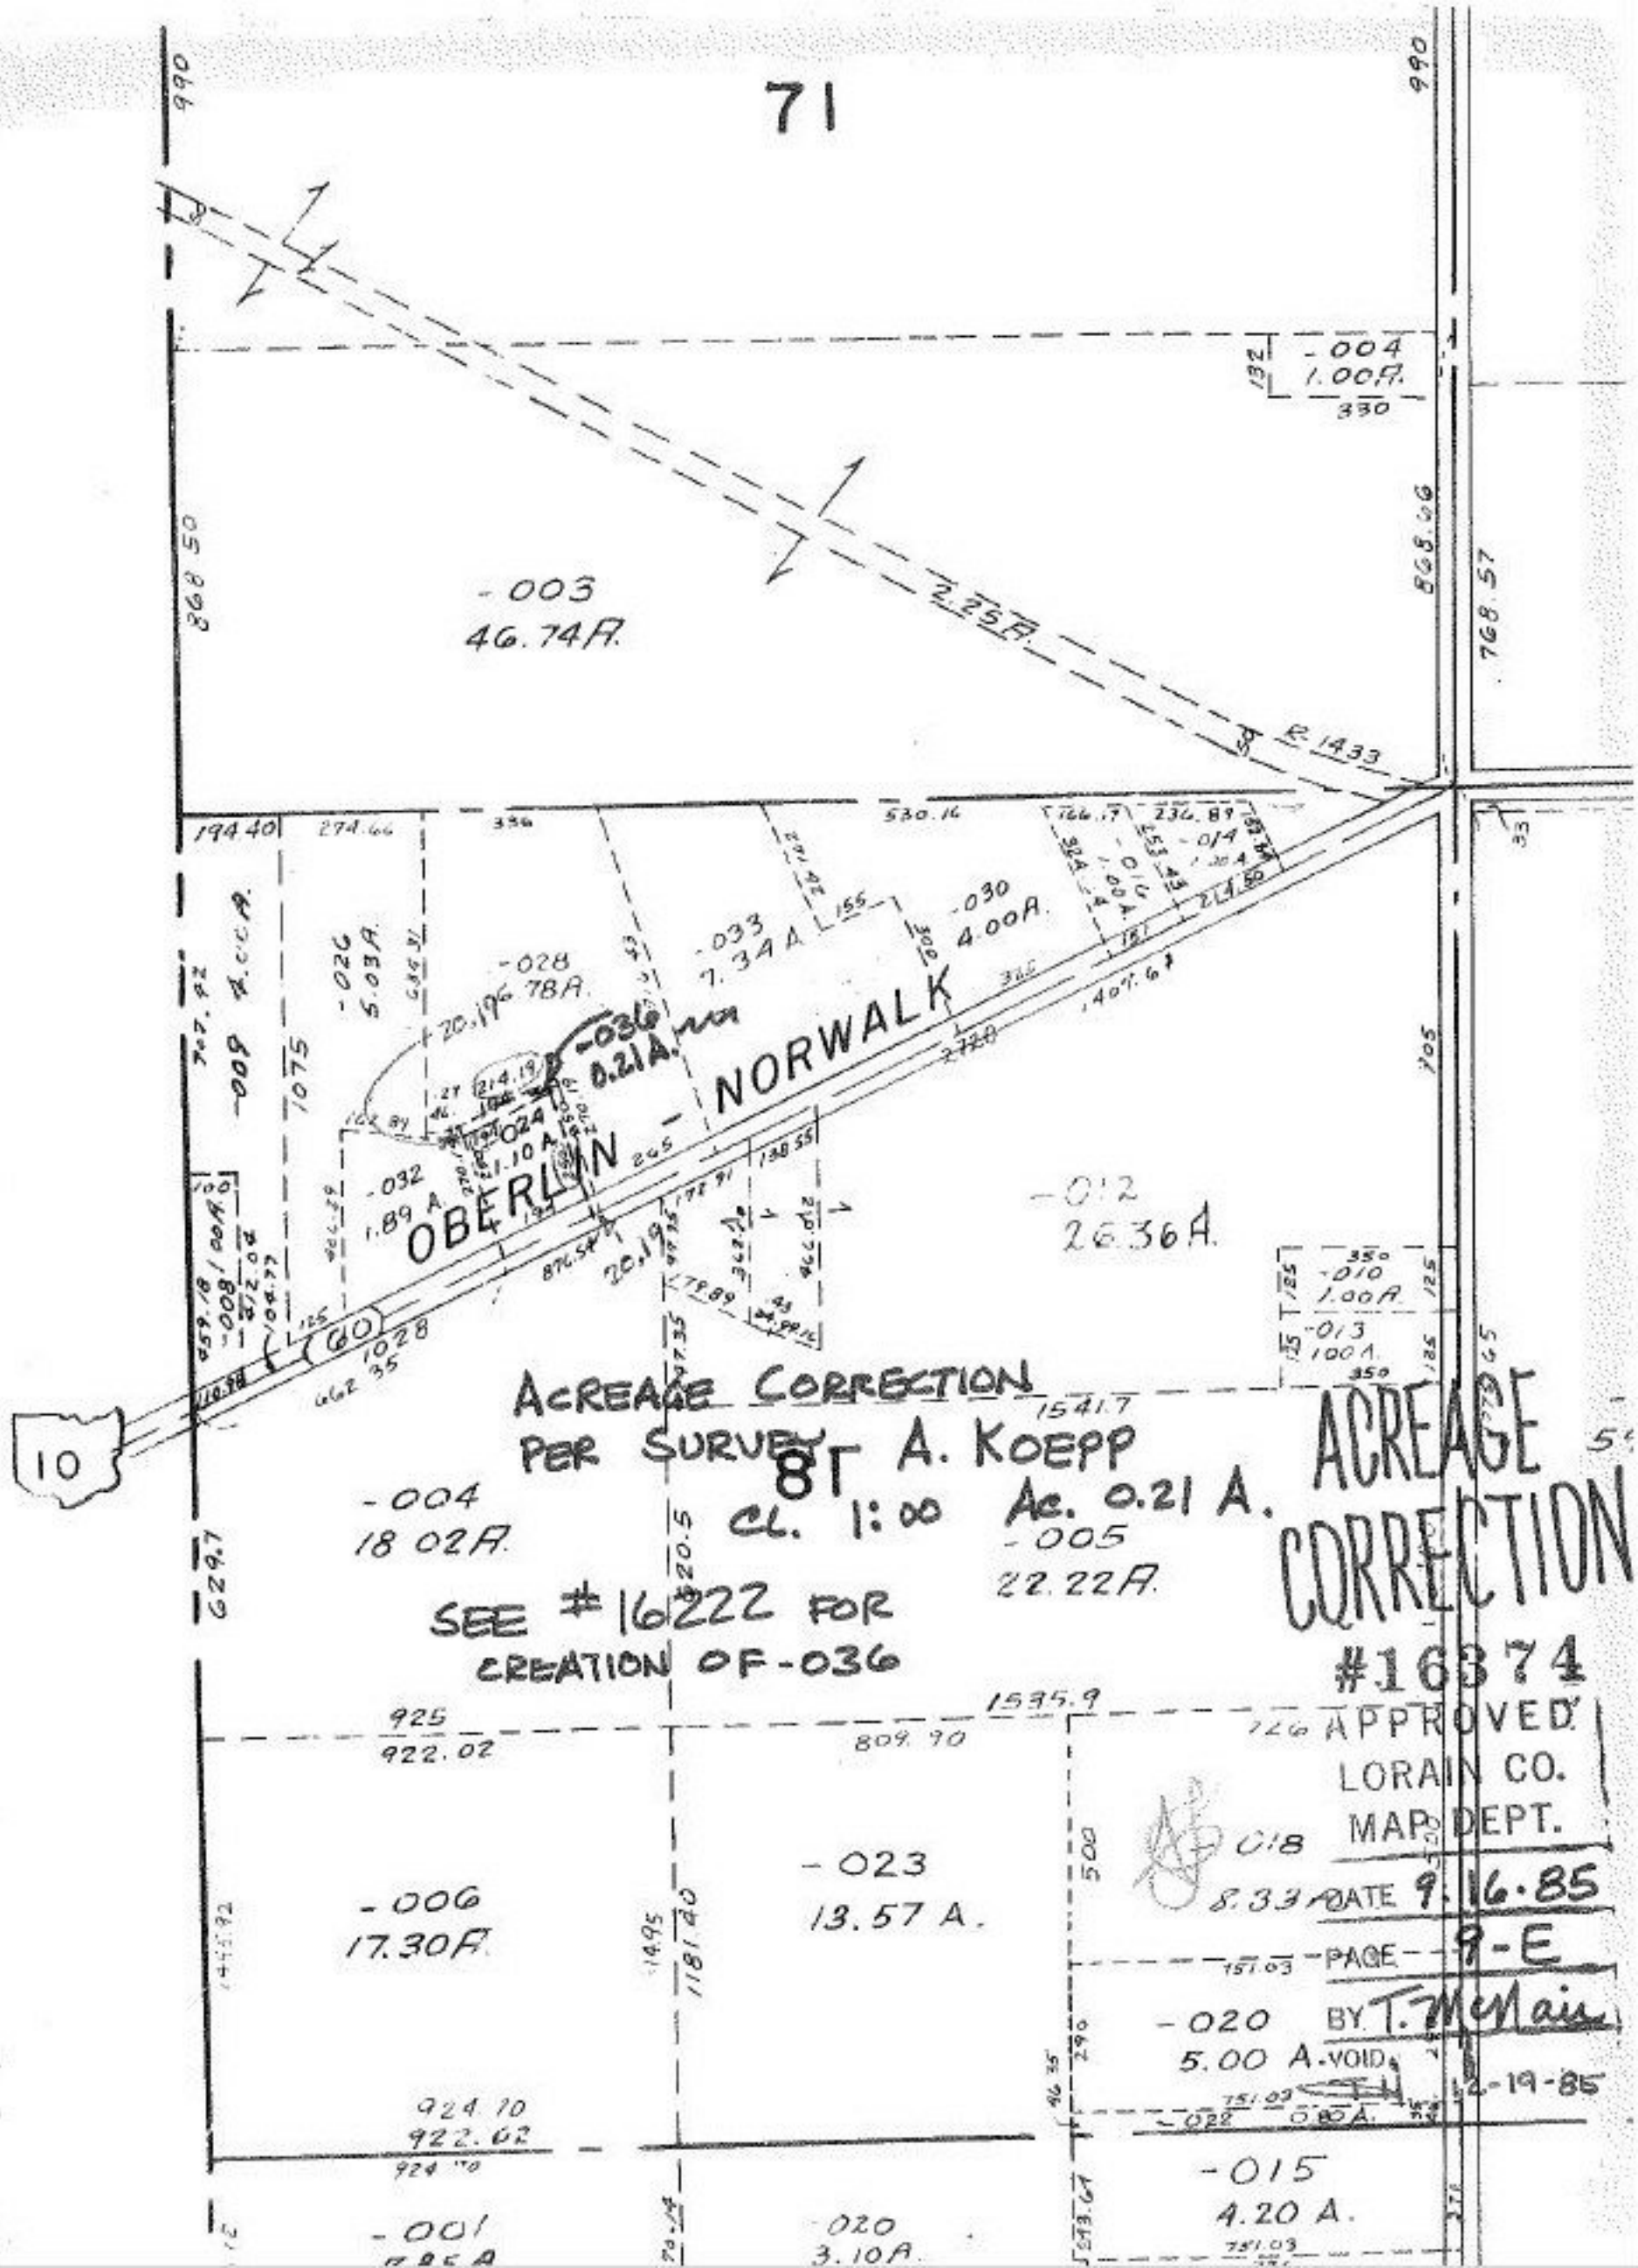
71
-003
46.74A.
2.25A.
R 1433
-004
1.00A.
-028
-033
7.34 A
-030
4.00A.
-036
0.21A.
OBERLIN - NORWALK
-032
1.89 A.
-012
26.36A.
-010
1.00A.
-013
1.00A.
10
ACREAGE CORRECTION
PER SURVEY 81 A. KOEPP
CL. 1:00 Ac. 0.21 A.
SEE #16222 FOR
CREATION OF -036
-004
18.02A.
-005
22.22A.
-006
17.30A.
-023
13.57 A.
-018
8.33A.
-020
5.00 A.
-015
4.20 A.
-001
-020
3.10A.
ACREAGE
CORRECTION
#16374
APPROVED
LORAIN CO.
MAP DEPT.
DATE 9.16.85
PAGE 9-E
BY T. McNair
VOID
12-19-85