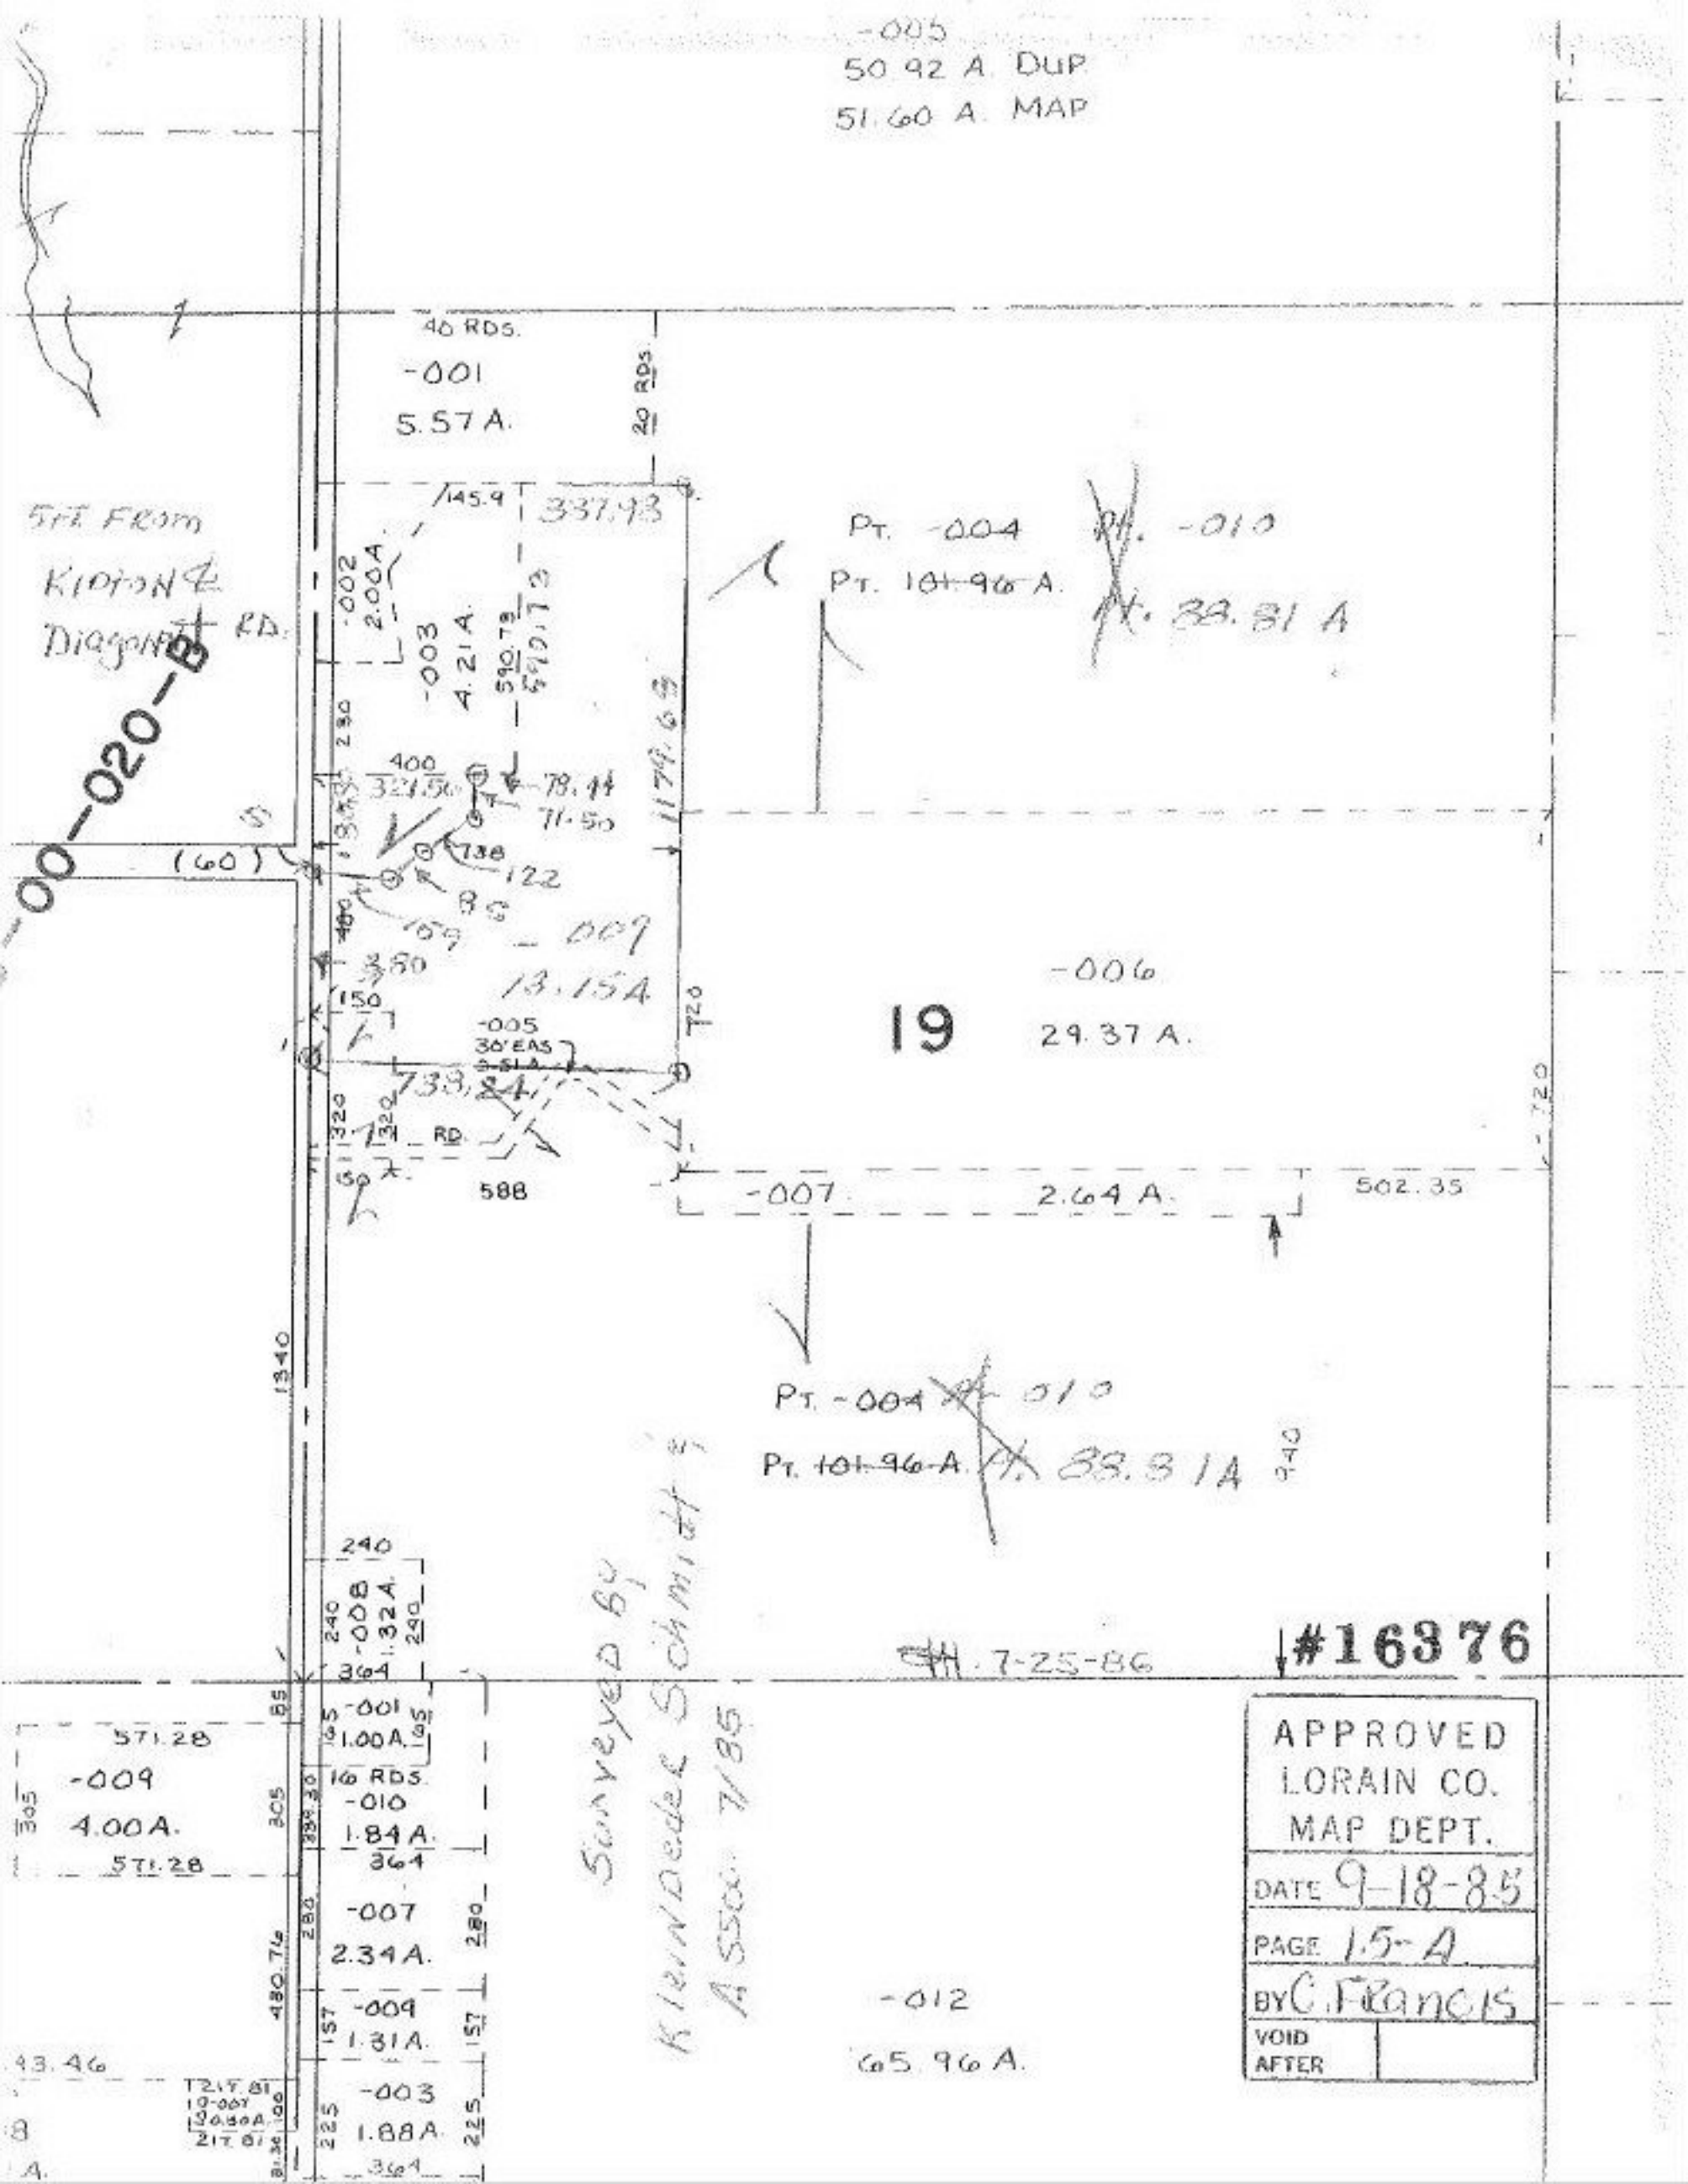
-005
50.92 A. DUP
51.60 A. MAP
40 RDS.
-001
5.57 A.
20 RDS
145.9
337.93
5 FT. FROM
KIPTON ℄
Diagonal RD.
-002
2.00 A.
-003
4.21 A.
590.73
590.73
PT. -004
PT. 101.96 A.
PT. -010
PT. 88.81 A
-00-020-B
400
321.56
78.44
71.50
738
122
85
159
-009
13.15 A
(60)
380
150
-005
30' EAS
738.24
RD.
588
-006
19
29.37 A.
-007
2.64 A.
502.35
720
1340
PT. -004
PT. 101.96 A.
PT. -010
PT. 88.81 A
940
240
-008
1.32 A.
364
-001
1.00 A.
16 RDS.
-010
1.84 A.
364
571.28
-009
4.00 A.
571.28
305
-007
2.34 A.
280
480.76
-009
1.31 A.
157
-003
1.88 A.
225
364
43.46
217.81
-012
65.96 A.
Surveyed by
Kleinfeder Schmitt &
Assoc. 7/85
7-25-86
#16376
APPROVED
LORAIN CO.
MAP DEPT.
DATE 9-18-85
PAGE 15-A
BY C. Francis
VOID
AFTER