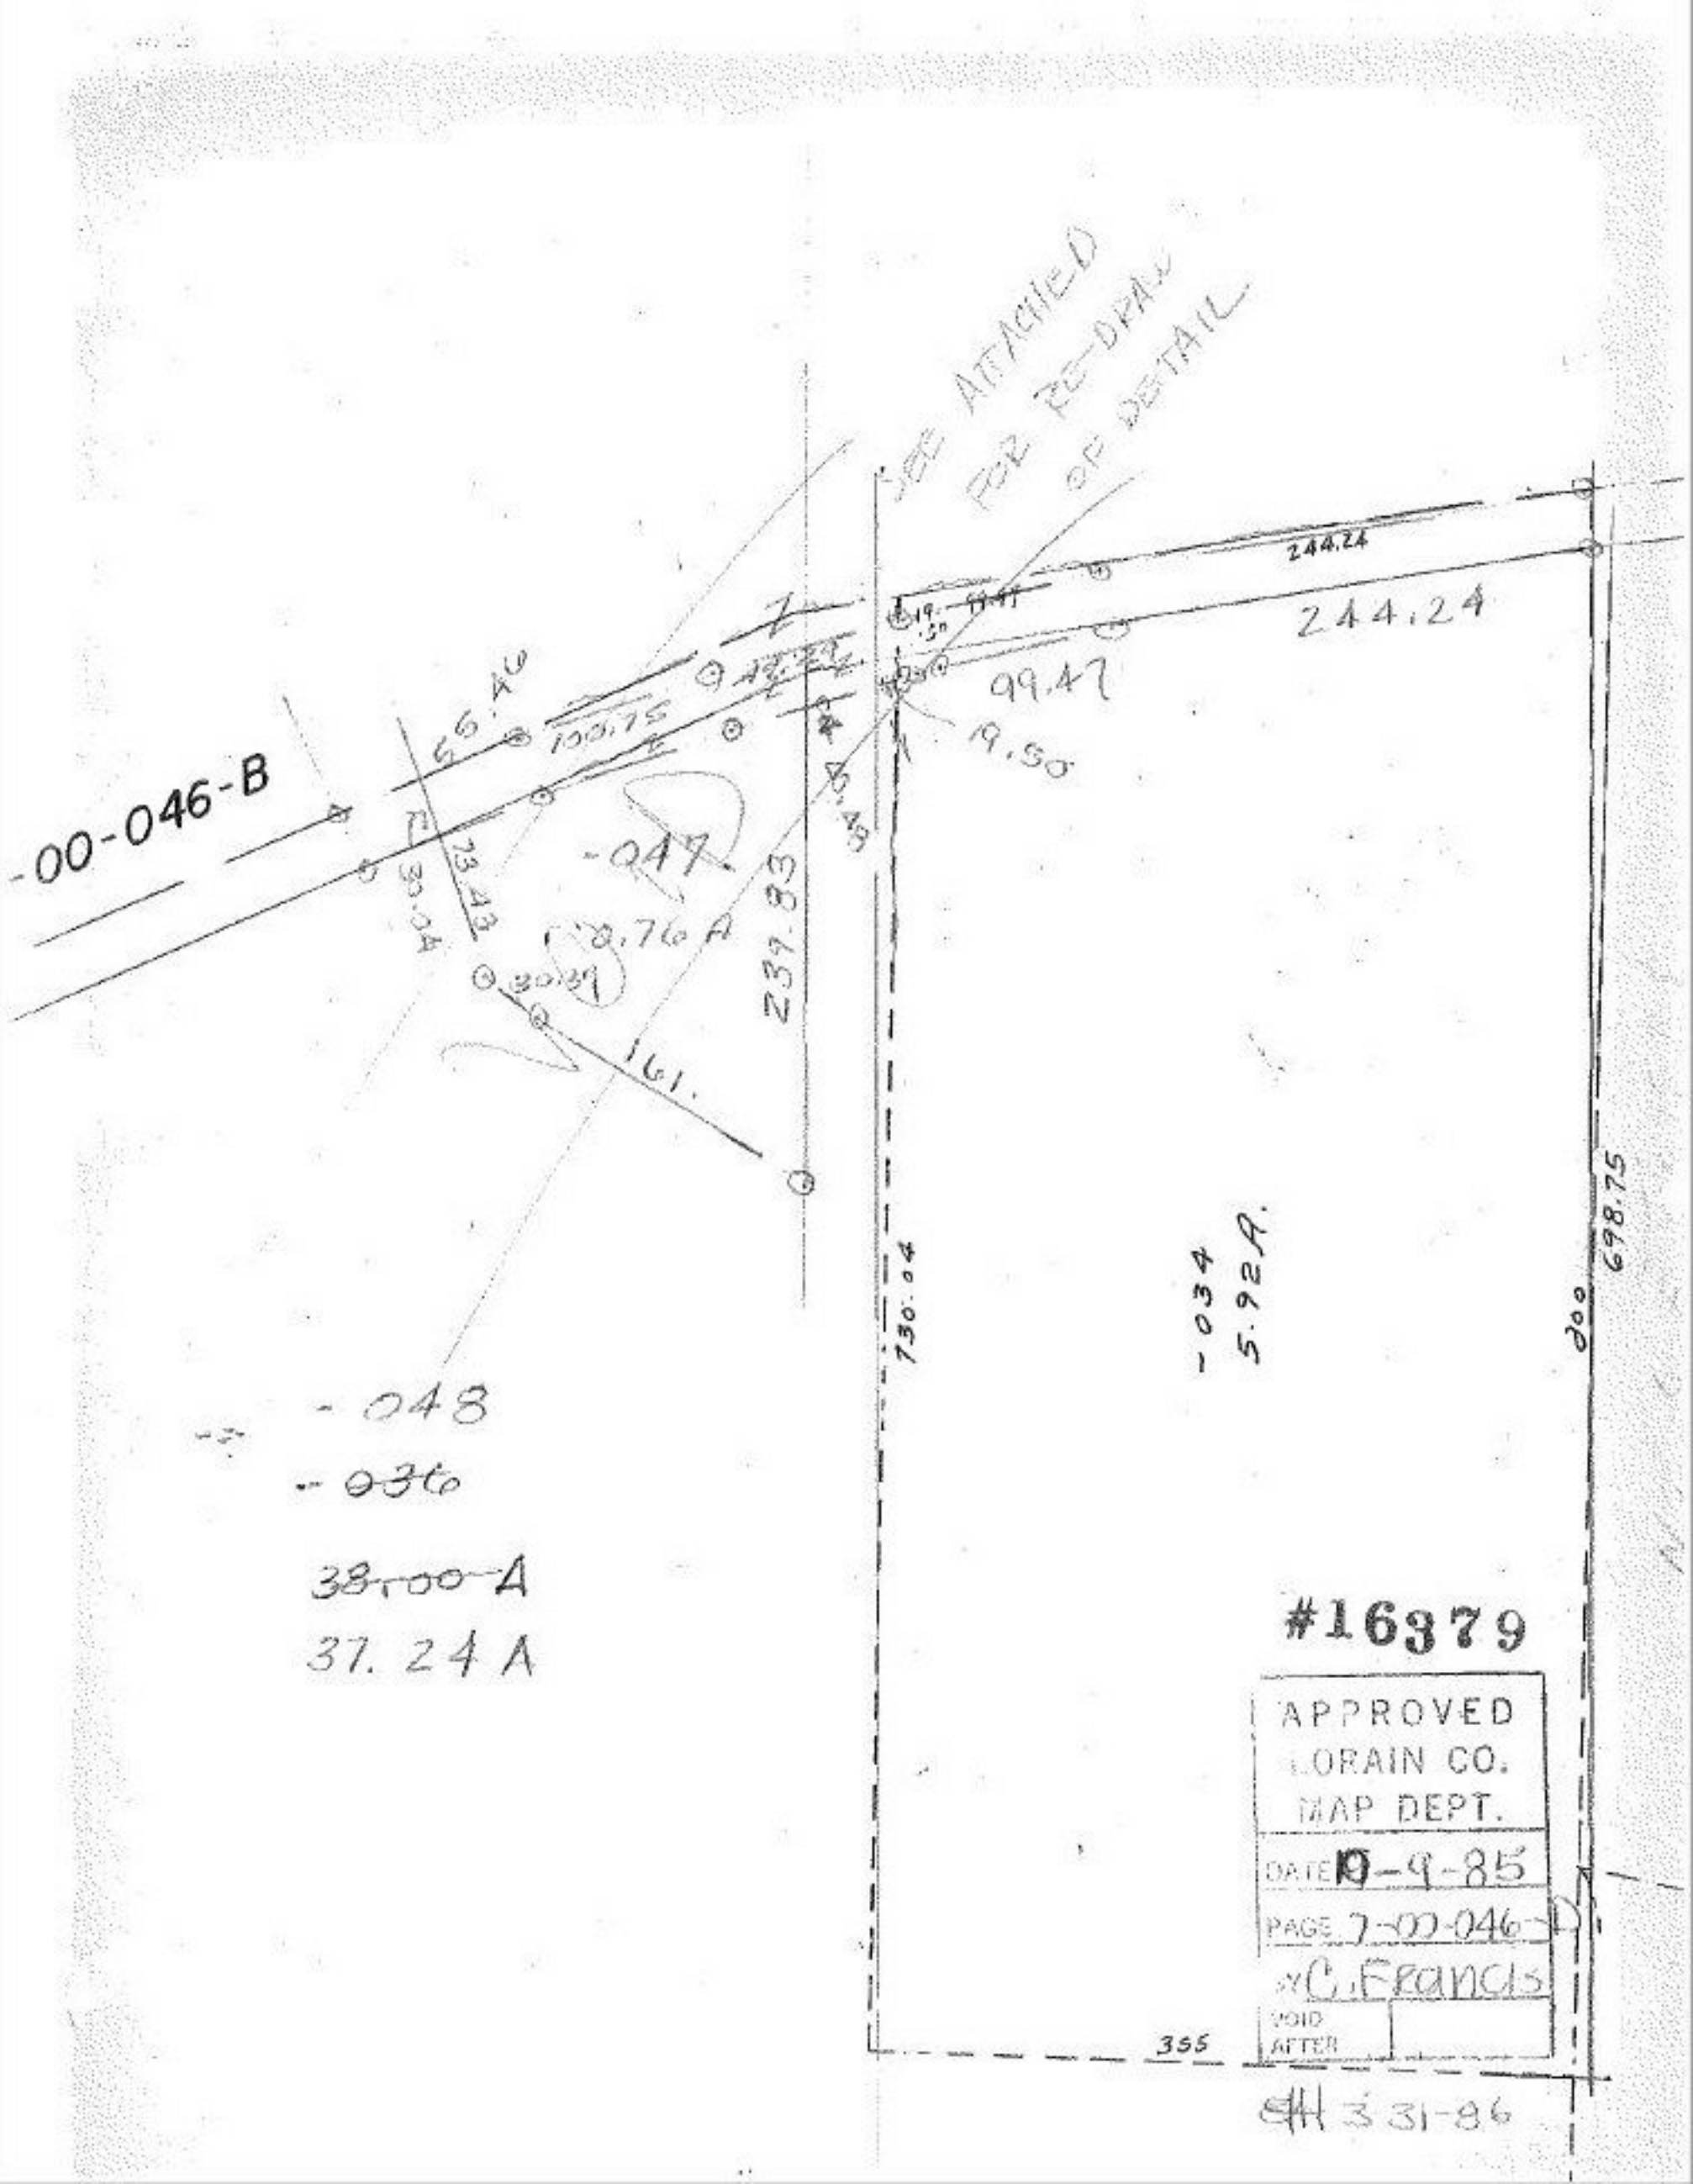
SEE ATTACHED FOR RE-DRAW OF DETAIL
-00-046-B
55.46
100.75
23.43
30.04
-047
0.76 A
30.39
161.
239.83
244.24
244.24
99.47
19.50
730.04
-034
5.92 A.
698.75
300
355
-048
-036
38.00 A
37.24 A
#16379
APPROVED
LORAIN CO.
MAP DEPT.
DATE 10-9-85
PAGE 7-00-046-D
BY C. Francis
VOID AFTER
3-31-86