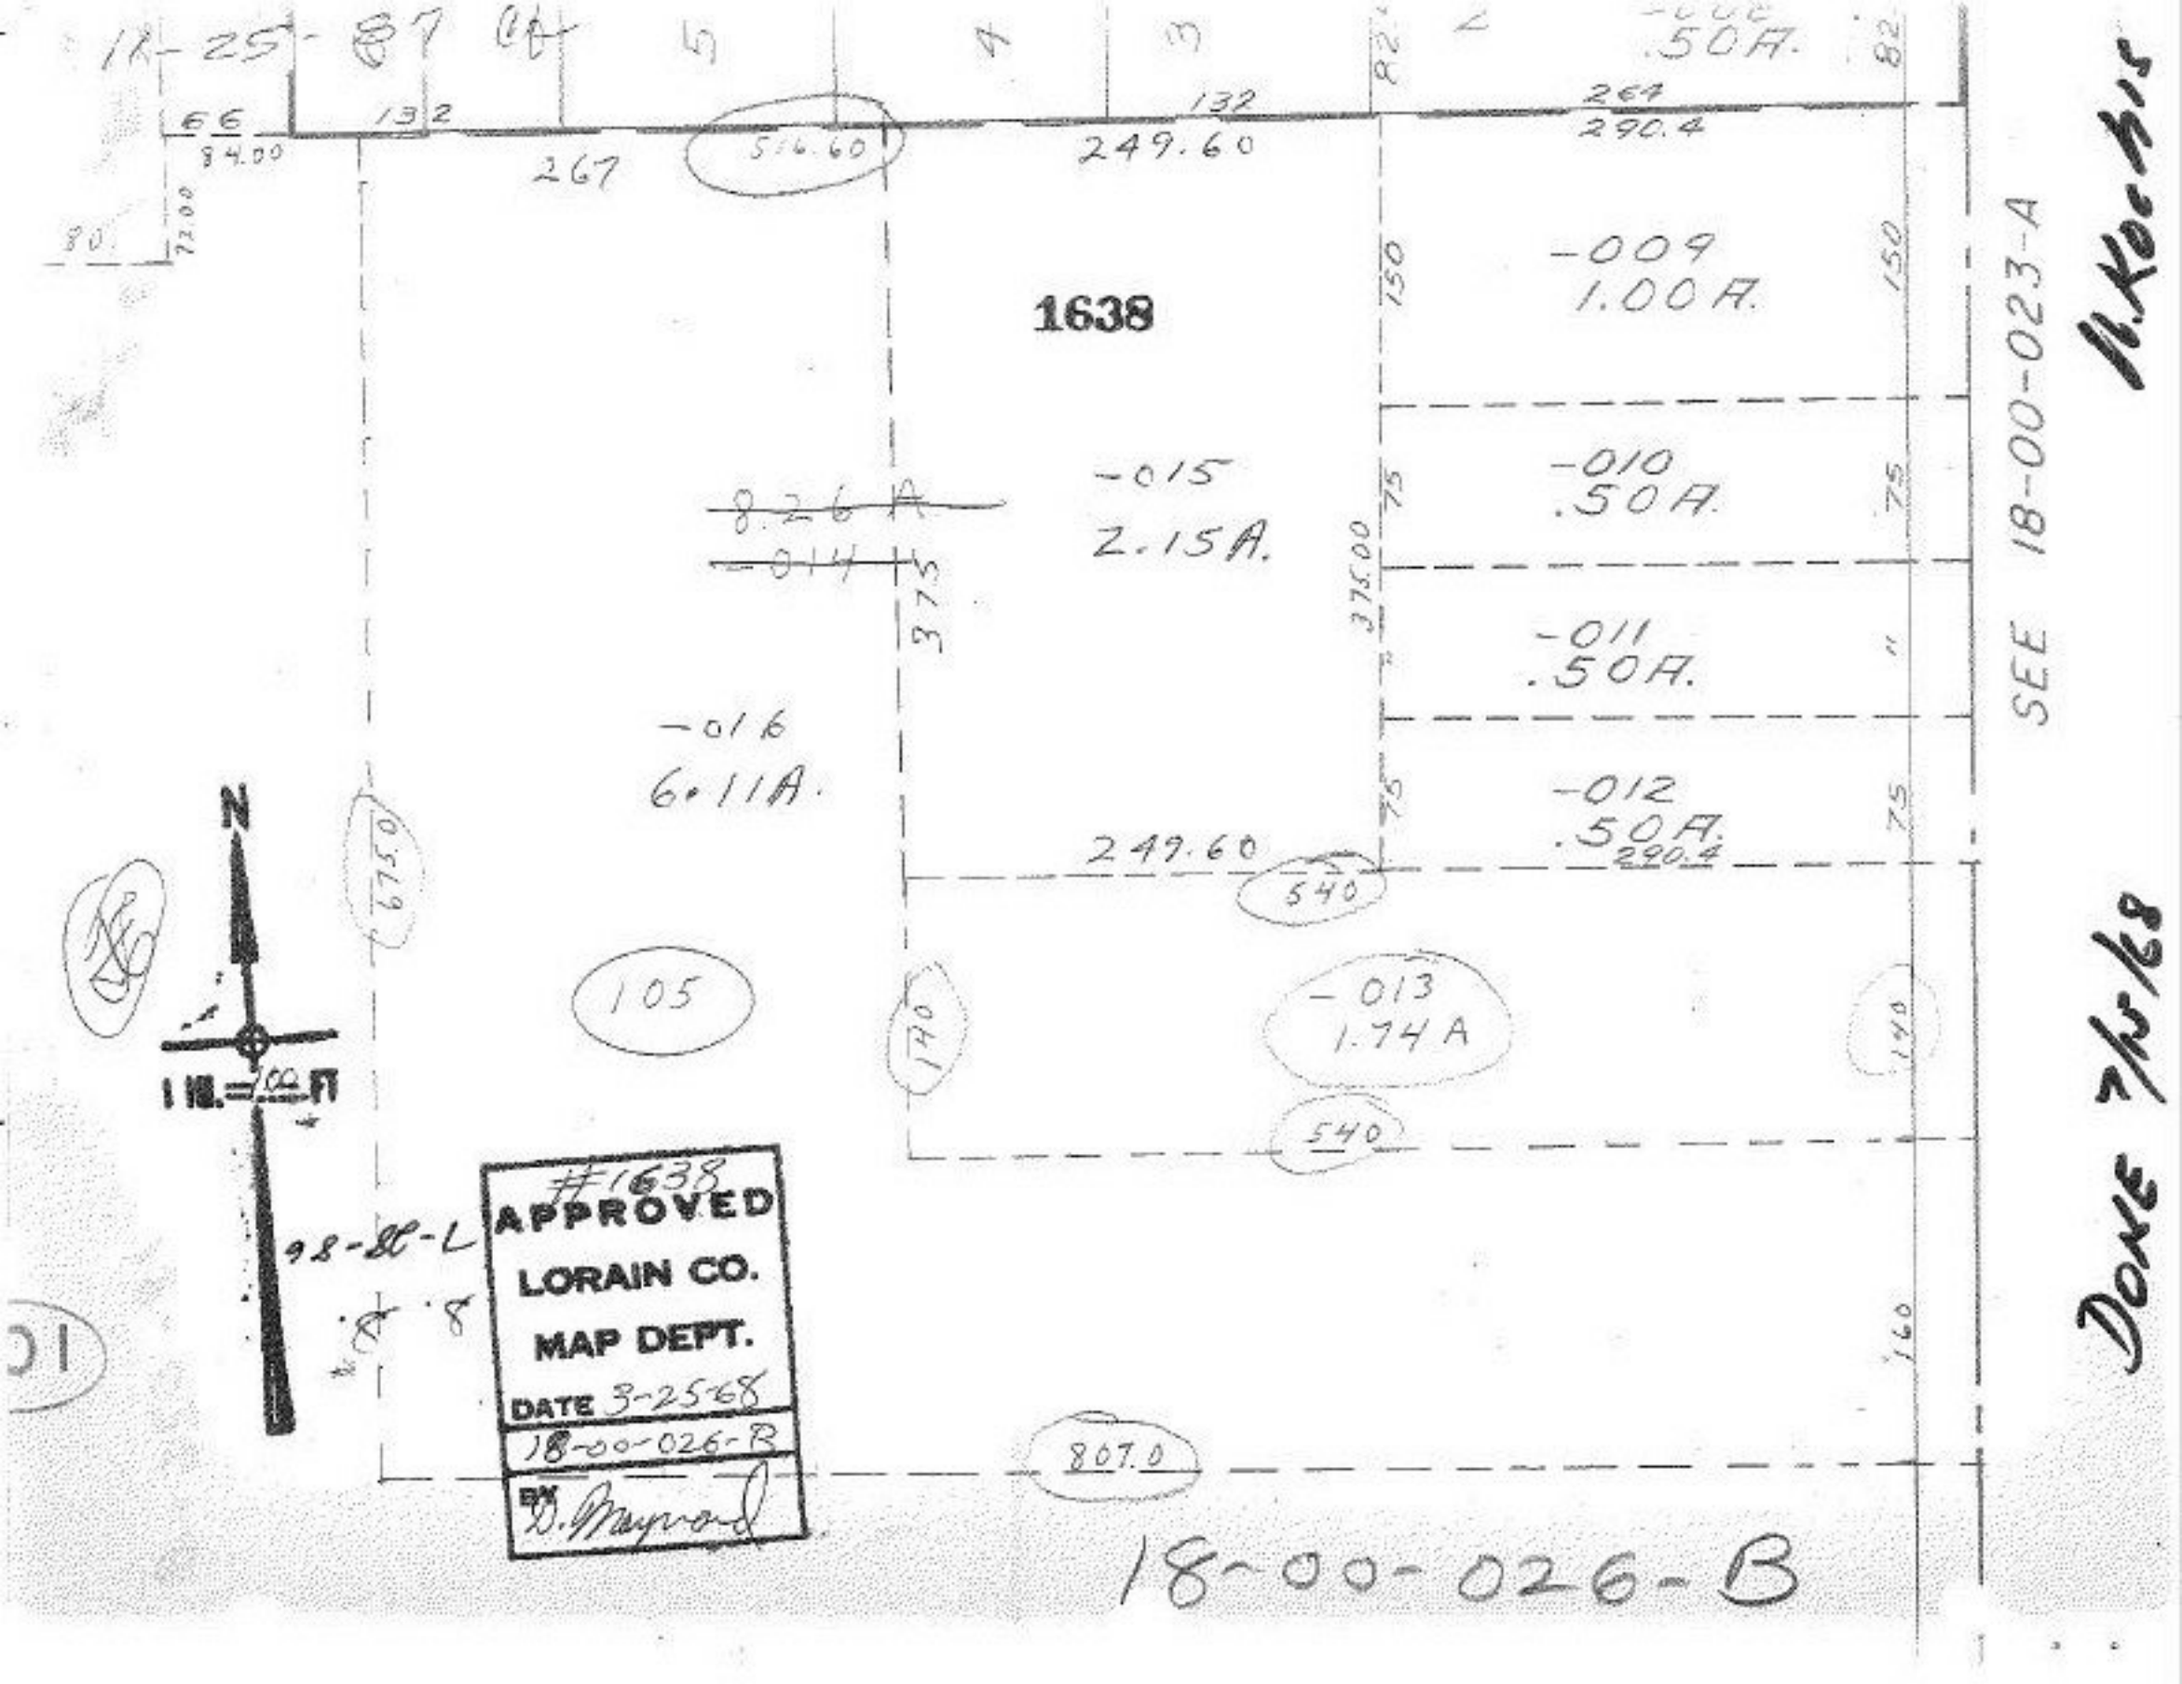
1638
-009
1.00 A.
-010
.50 A.
-011
.50 A.
-012
.50 A.
-013
1.74 A
-014
-015
2.15 A.
-016
6.11 A.
8.26 A
SEE 18-00-023-A
N. Kobasic
Done 7/5/68
1 IN. = 100 FT
N
#1638
APPROVED
LORAIN CO.
MAP DEPT.
DATE 3-25-68
18-00-026-B
BY D. Maynard
18-00-026-B