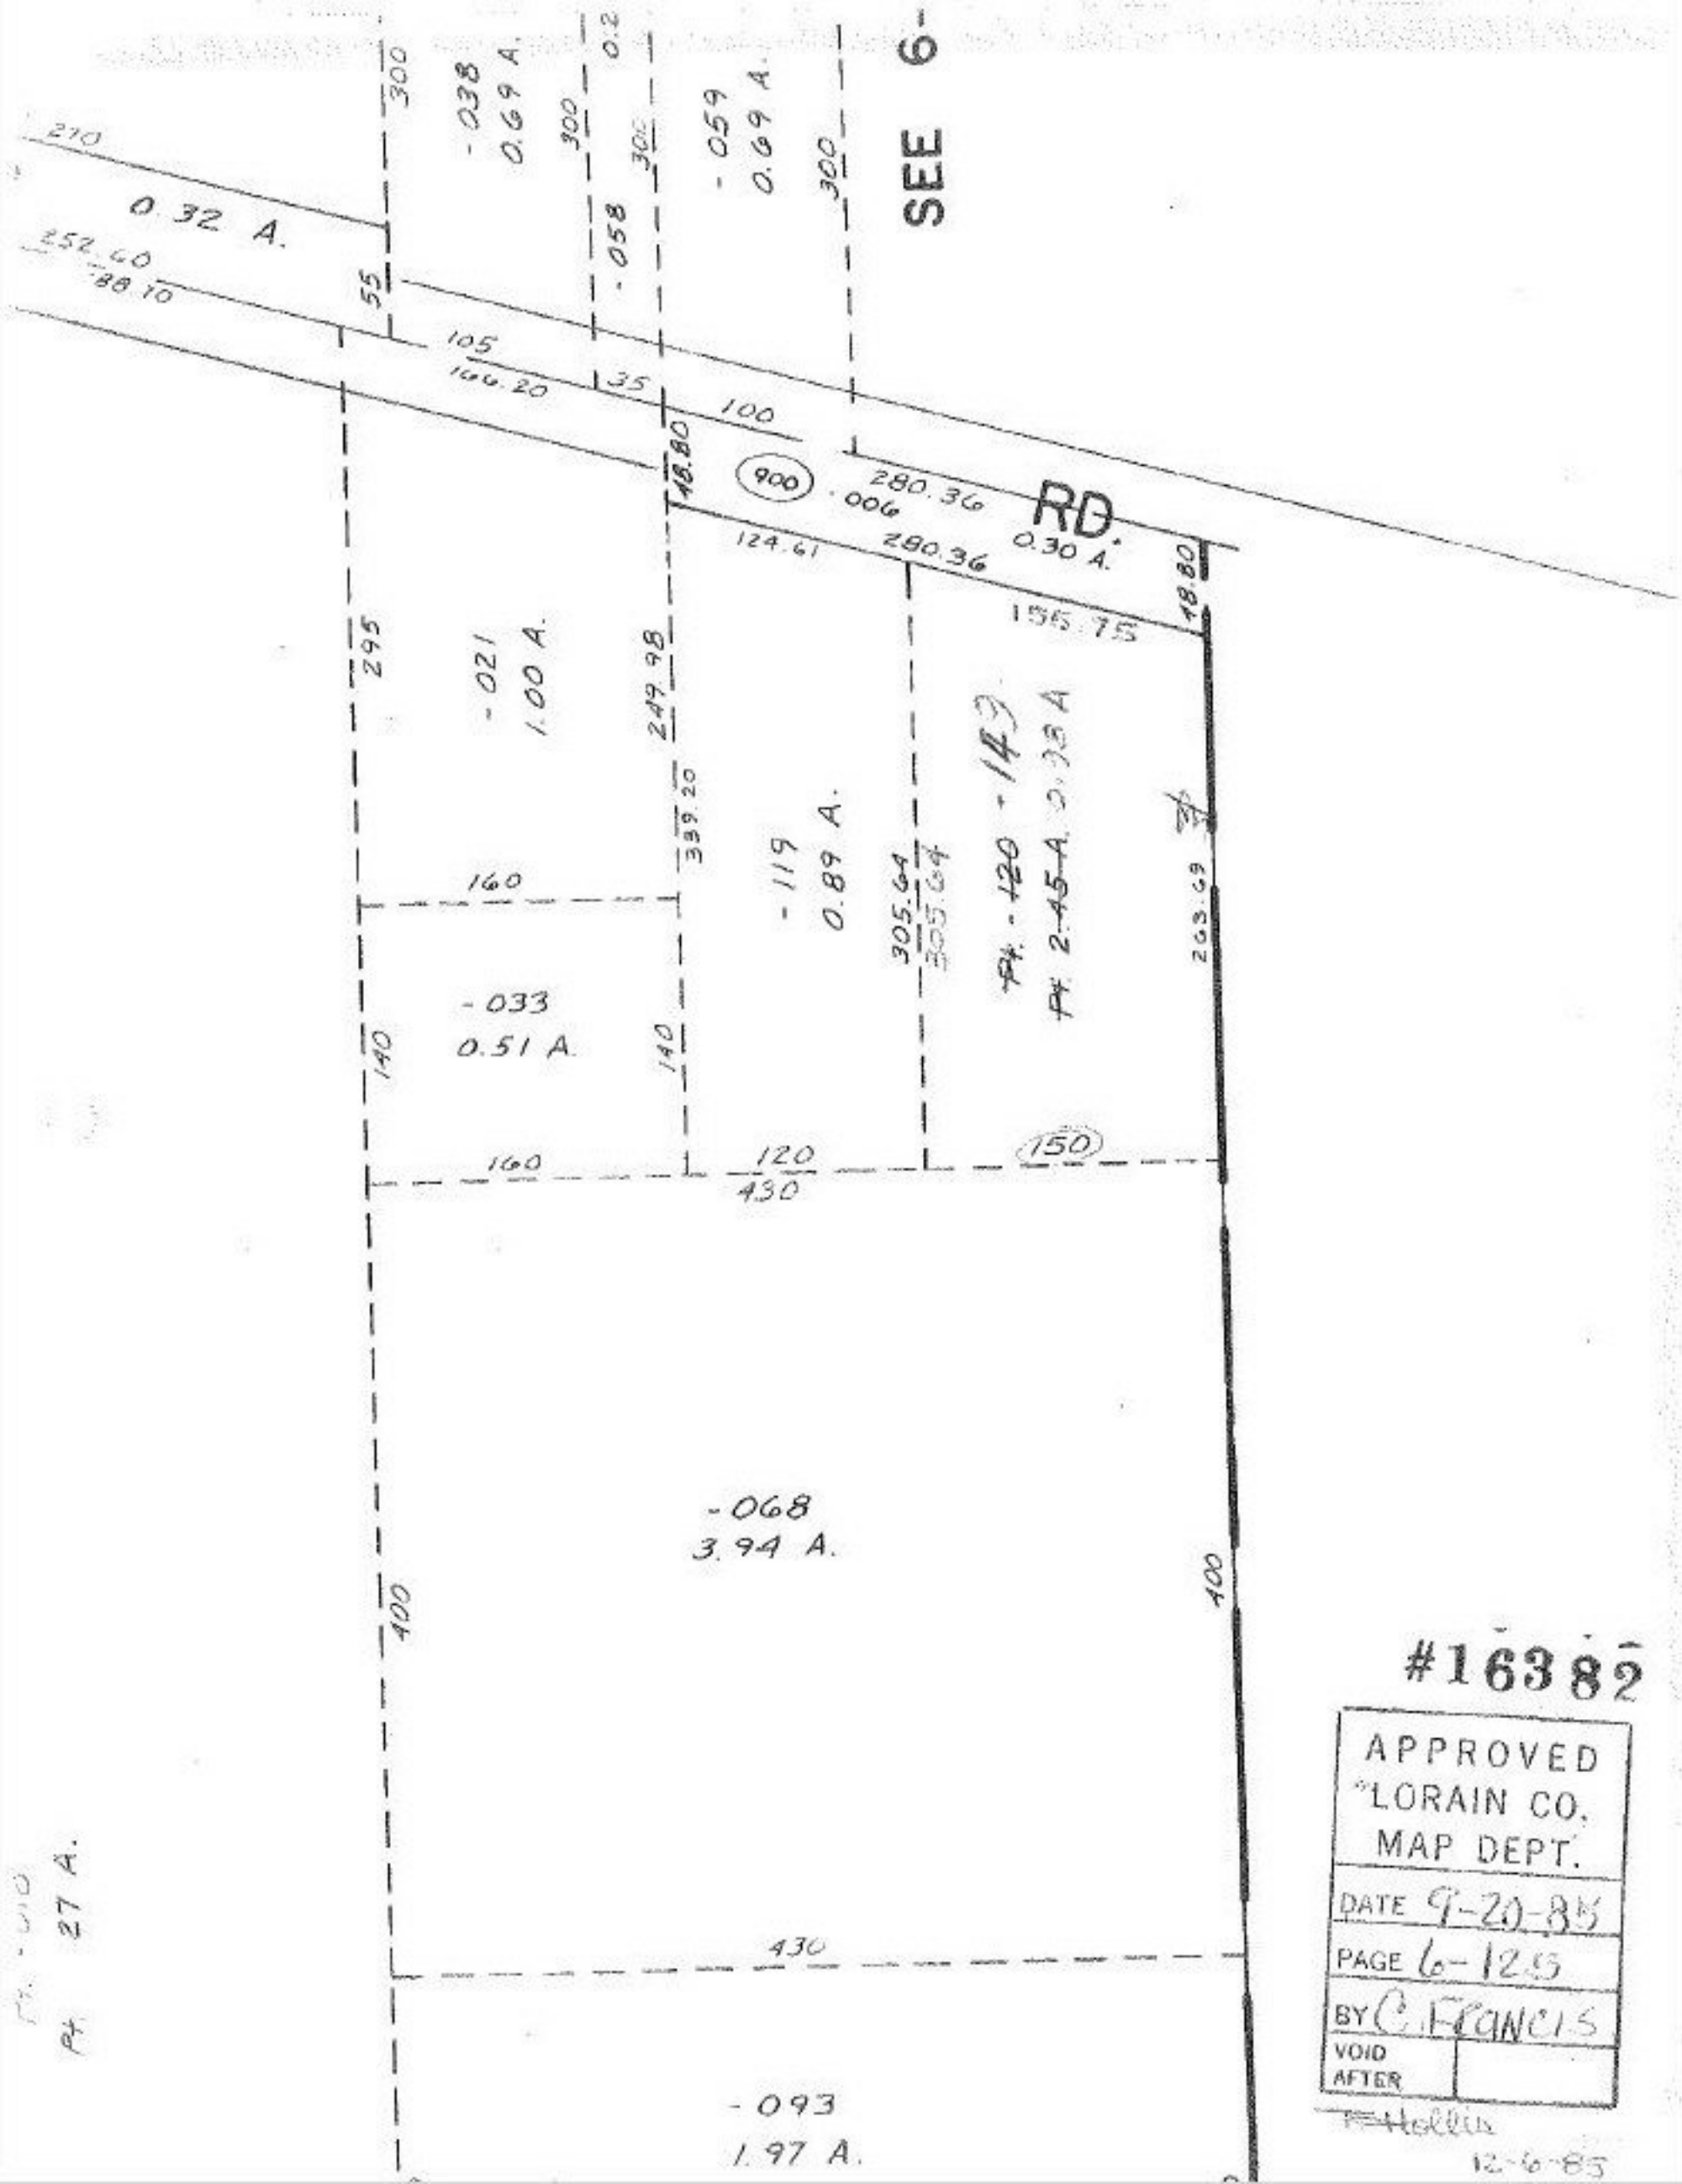

#16382

APPROVED
LORAIN CO.
MAP DEPT.

DATE 9-20-85
PAGE 6-125
BY C. Francis
VOID AFTER

F. Hollis
12-6-85