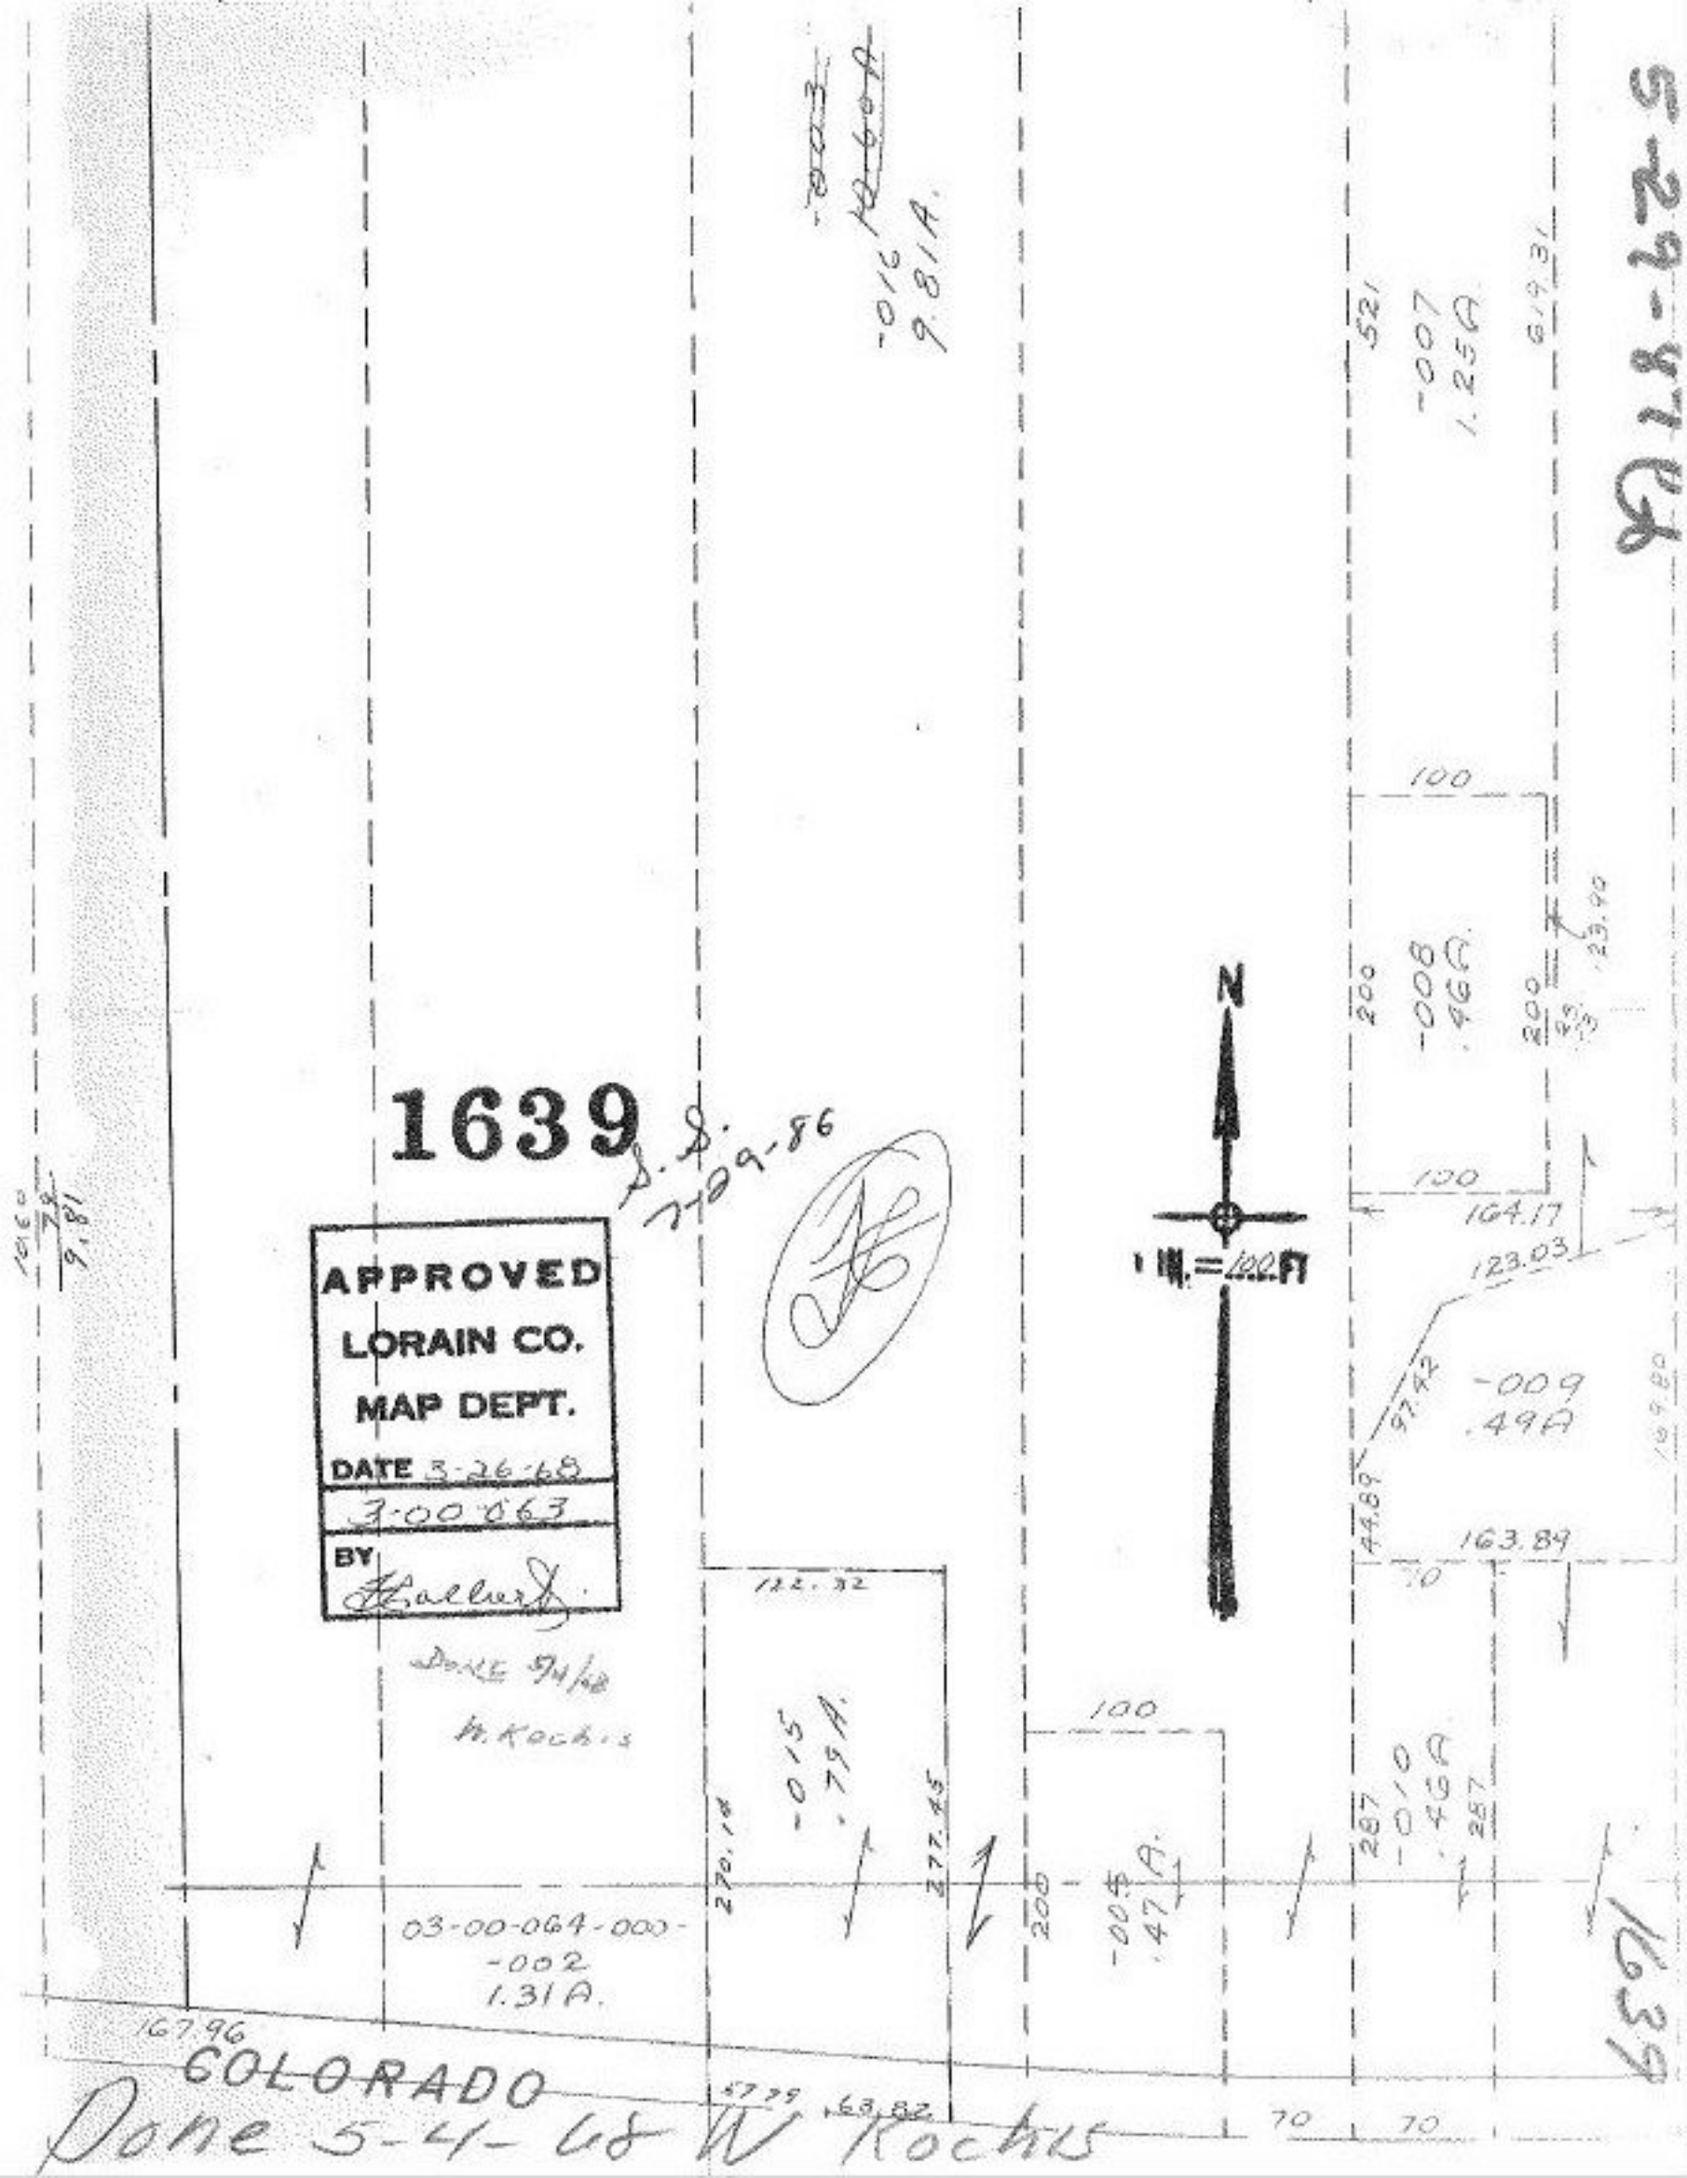
1639
APPROVED
LORAIN CO.
MAP DEPT.
DATE 5-26-68
3-00-063
BY
DOLLE 5/4/68
M. KOCHIS
N
1" = 100 FT
-003
-016
9.81A.
-007
1.25A.
-008
.46A.
-009
.49A
-015
.79A.
-005
.47A.
-010
.46A
03-00-064-000-
-002
1.31A.
COLORADO
Done 5-4-68 W Kochis
