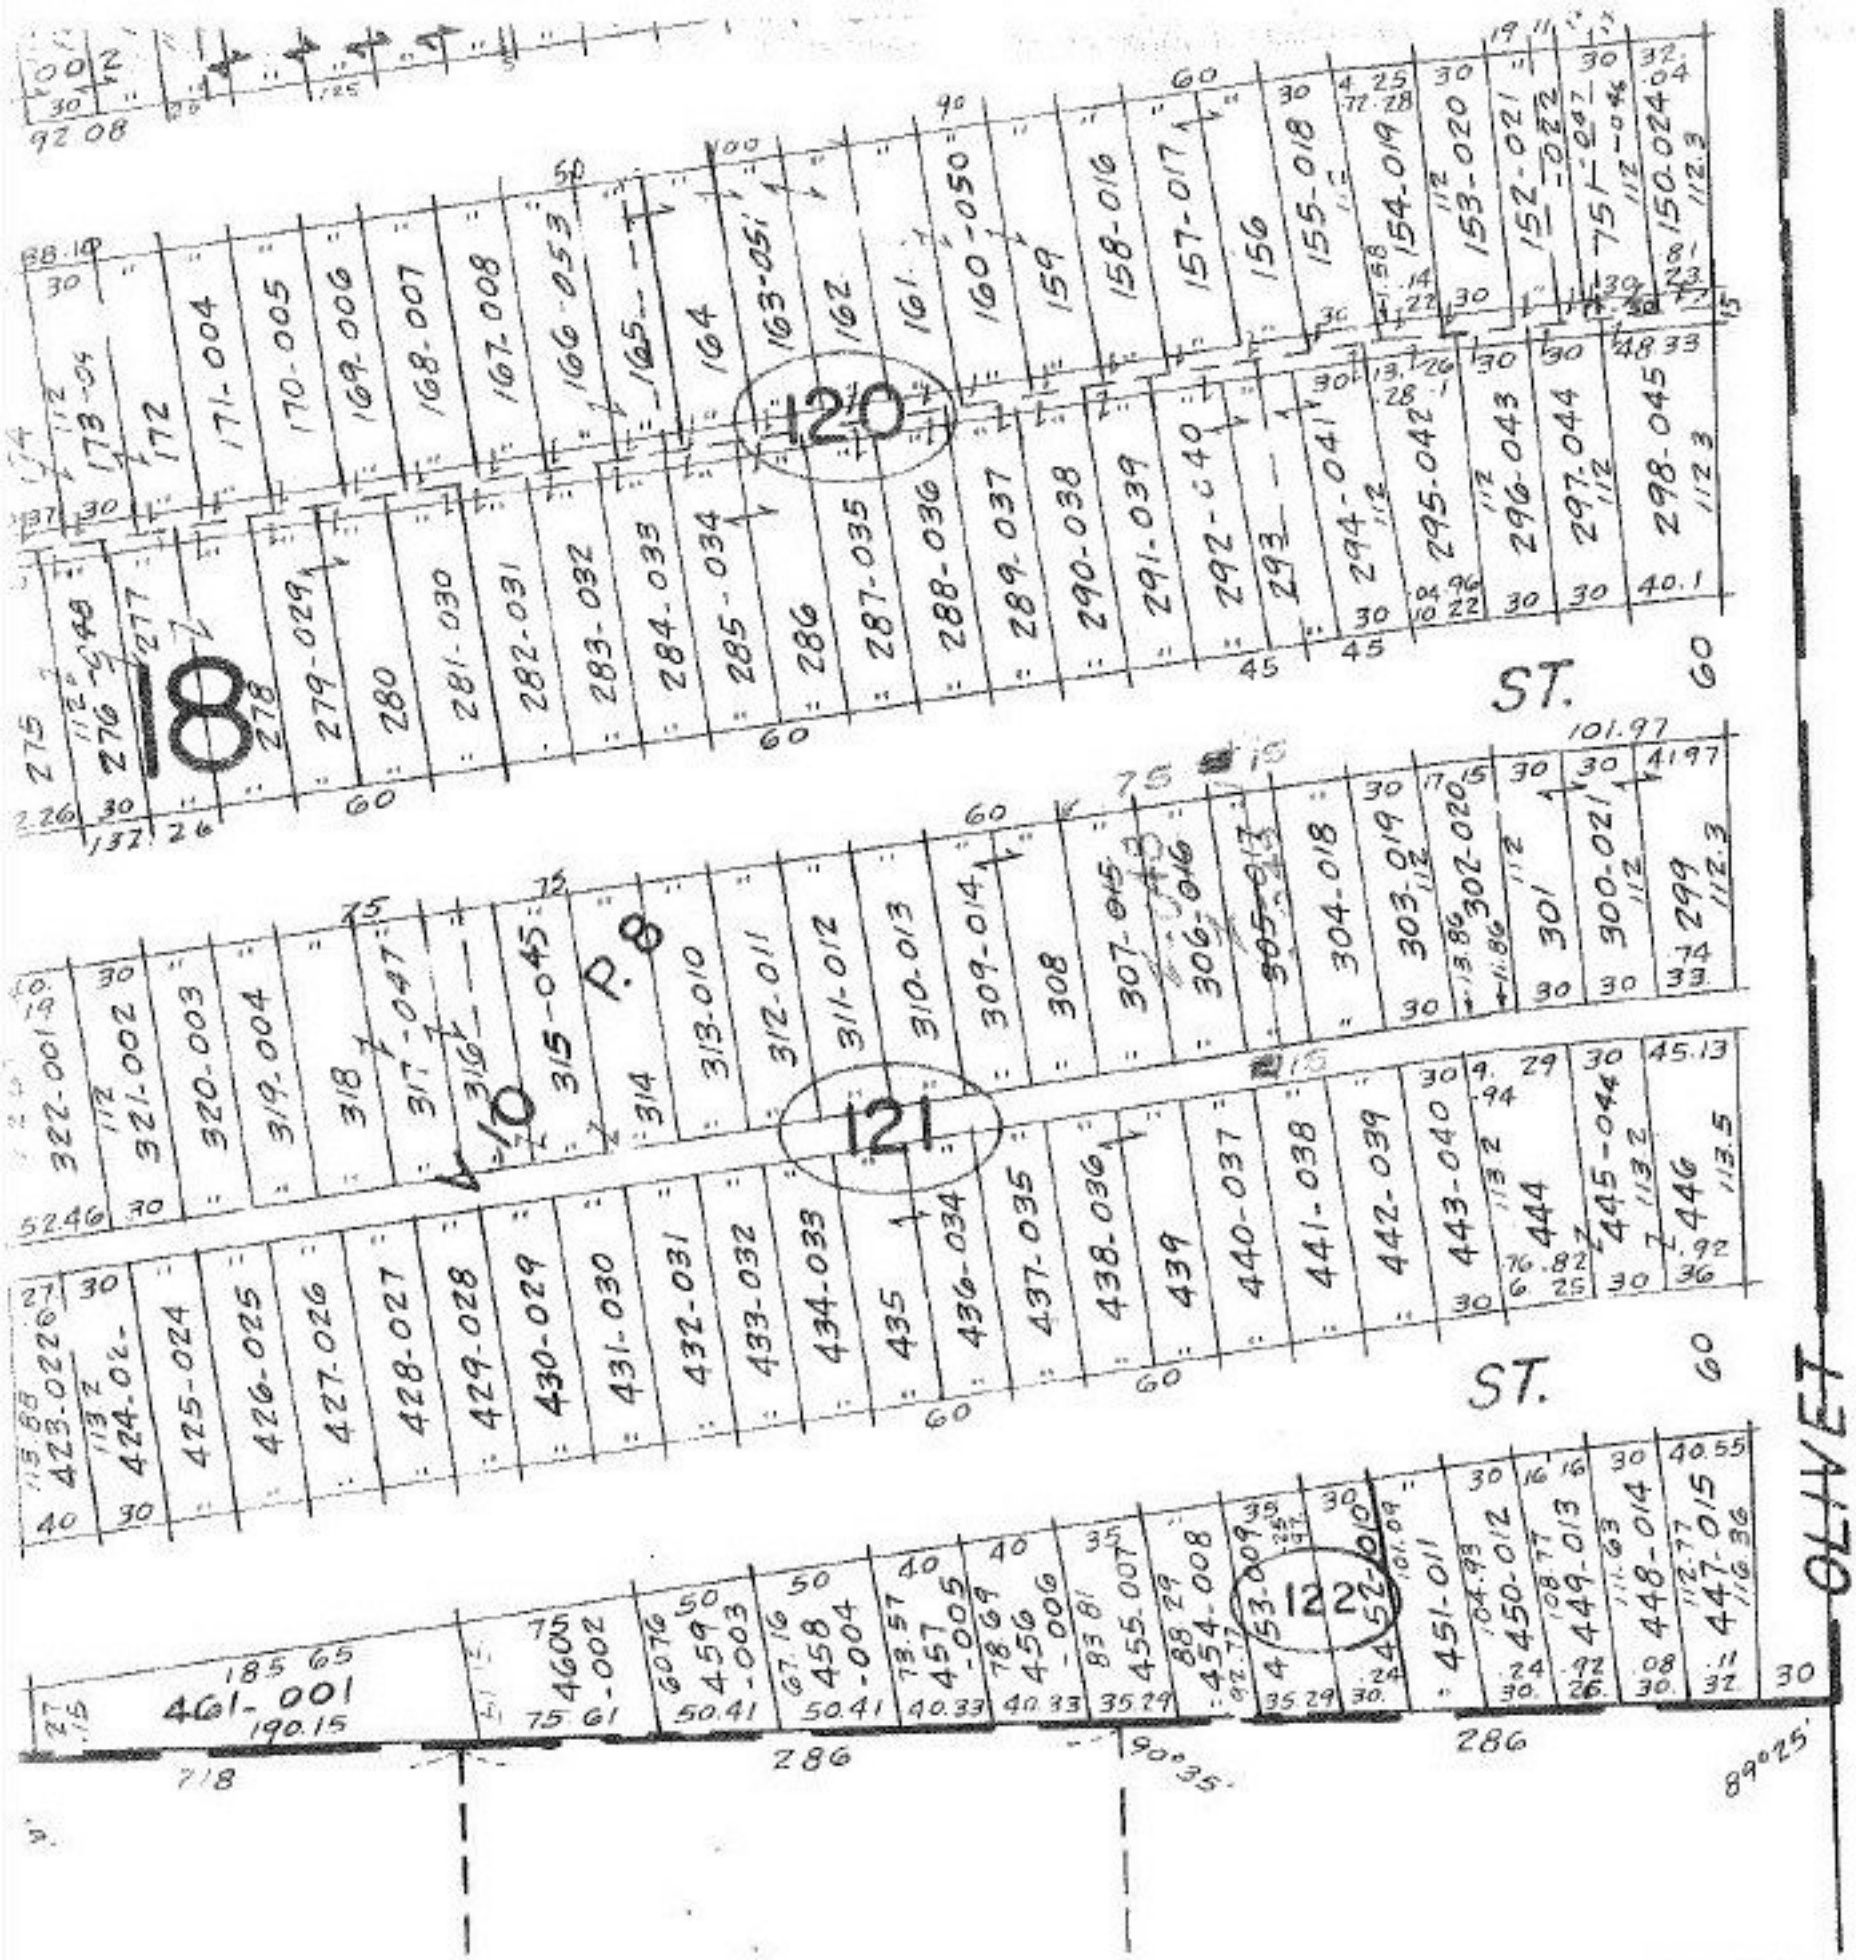


#16395

APPROVED
LORAIN CO.
MAP DEPT.

DATE 9-27-85

PAGE 6-8

BY C. Francis

VOID AFTER

T. Hollis
12-6-85