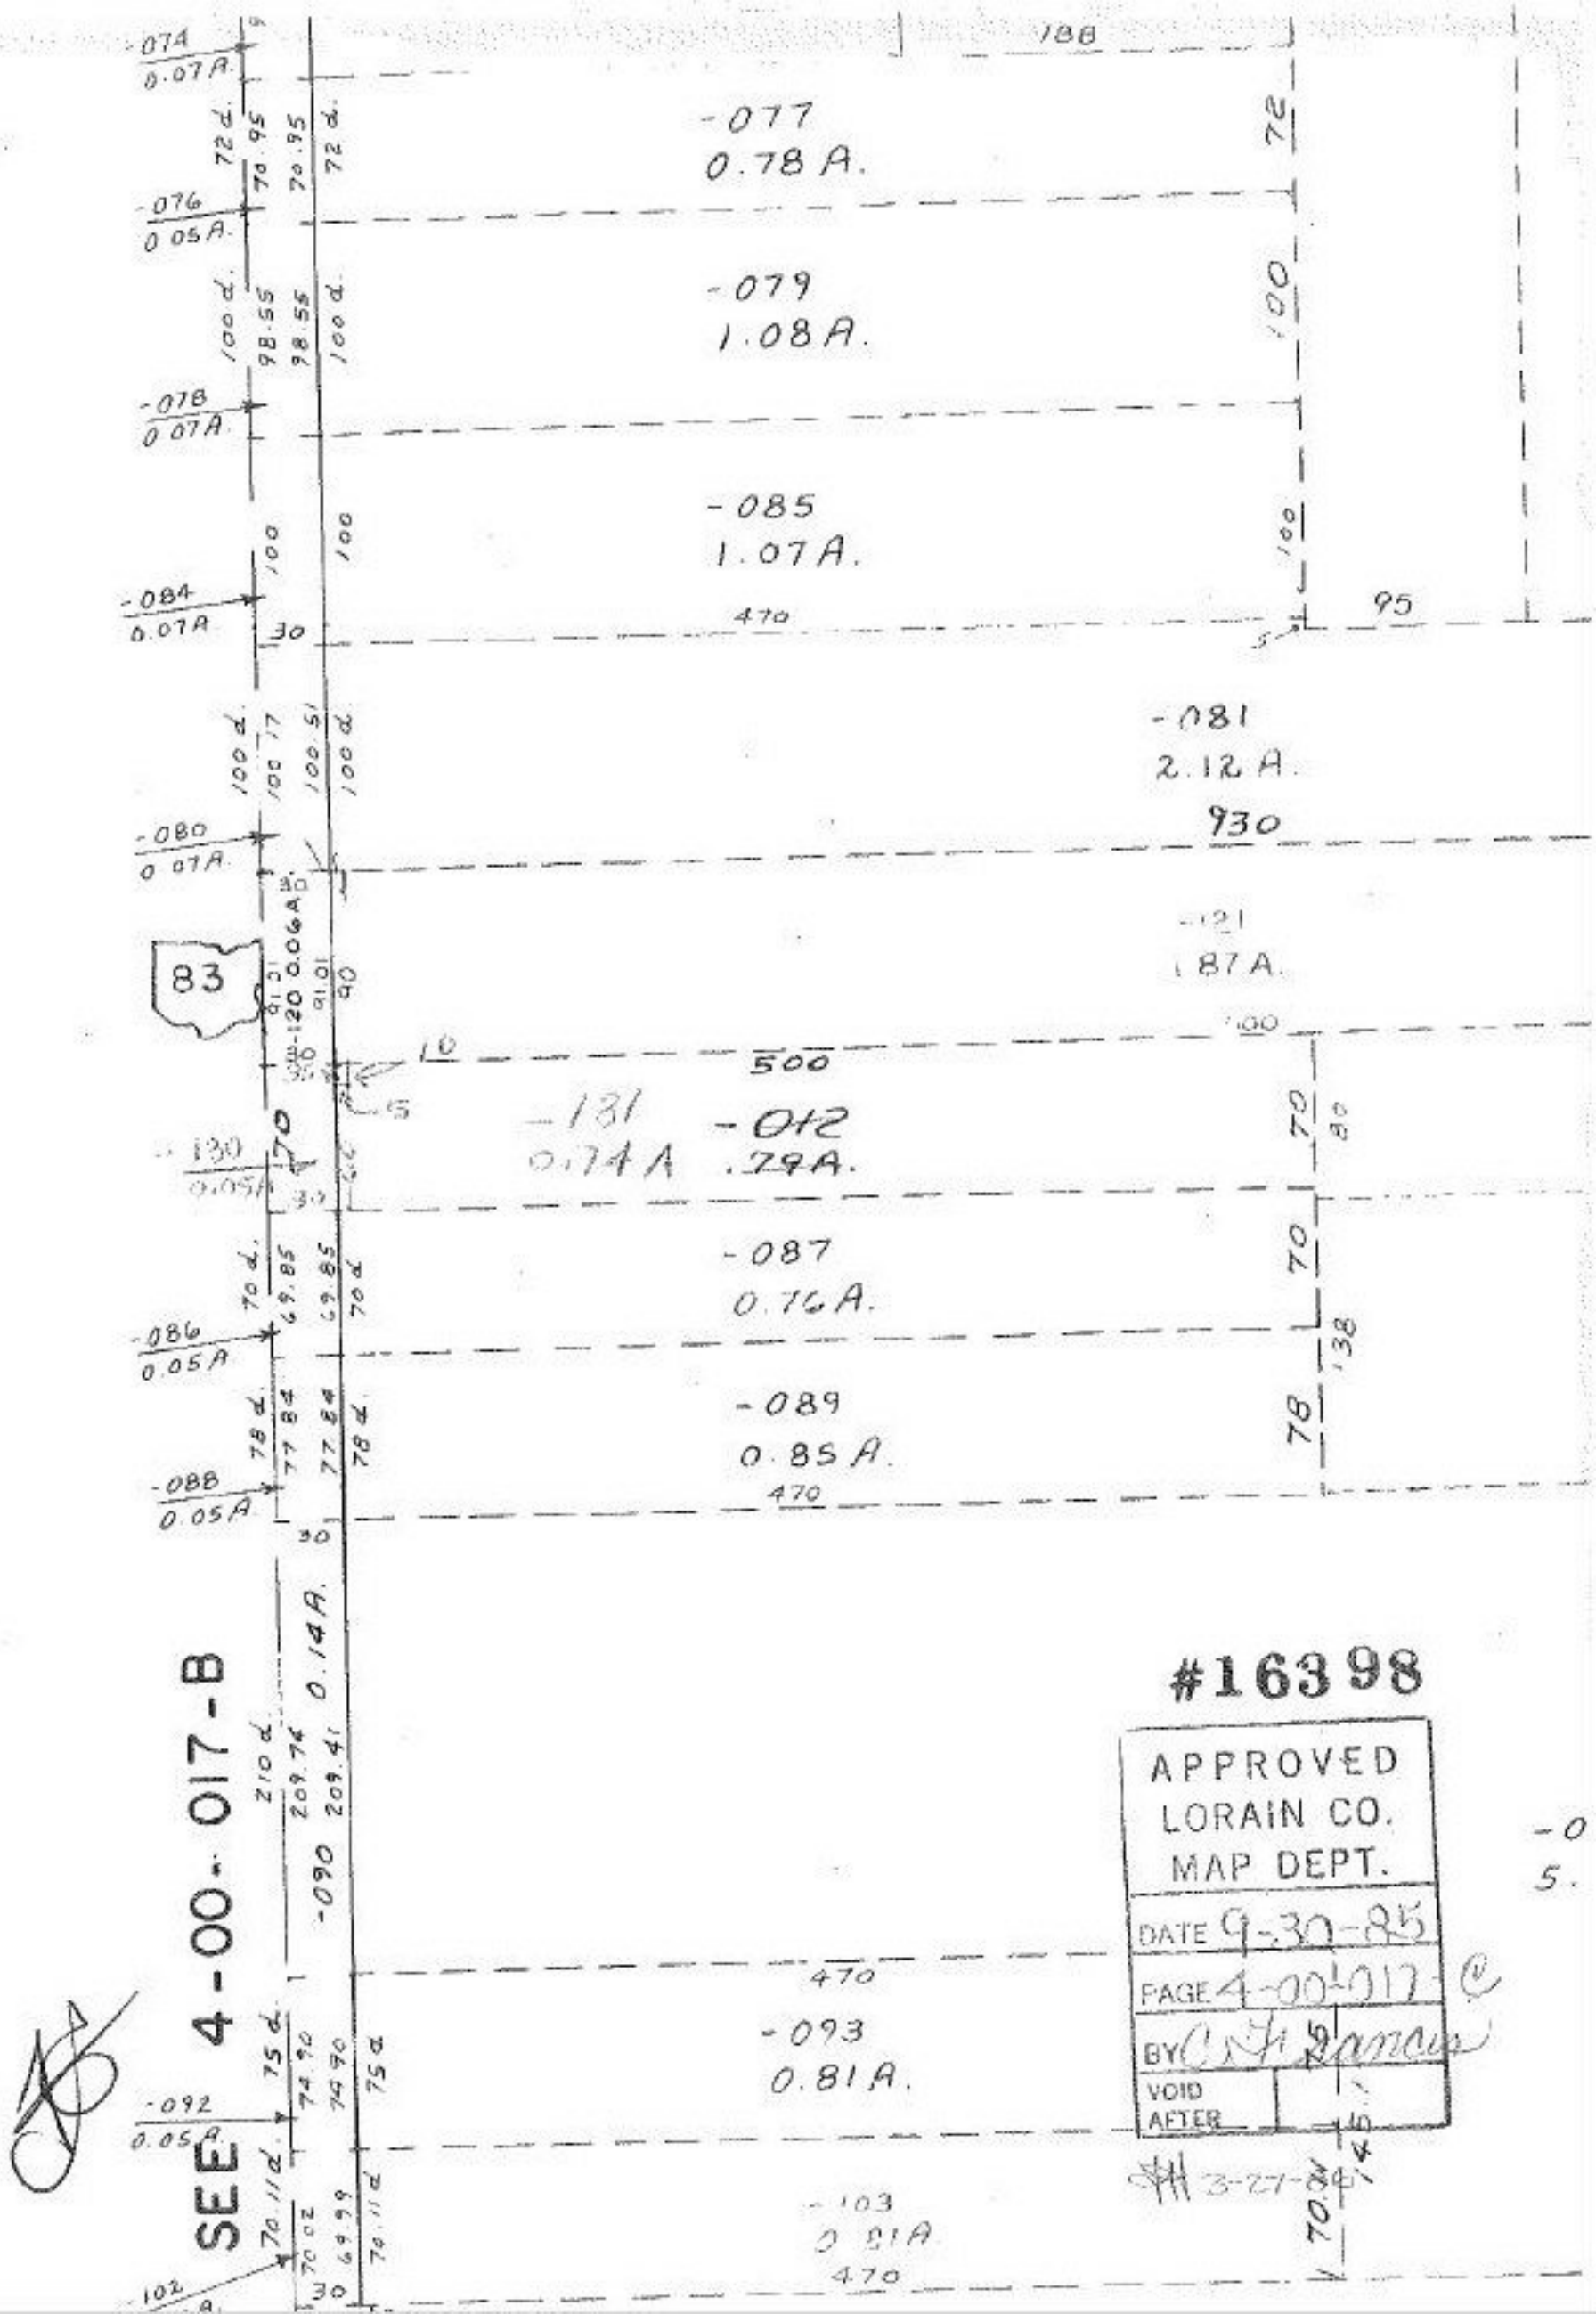

#16398

APPROVED
LORAIN CO.
MAP DEPT.
DATE 9-30-85
PAGE 4-00-017-C
BY C. F. Francis
VOID AFTER
3-27-86