#16402

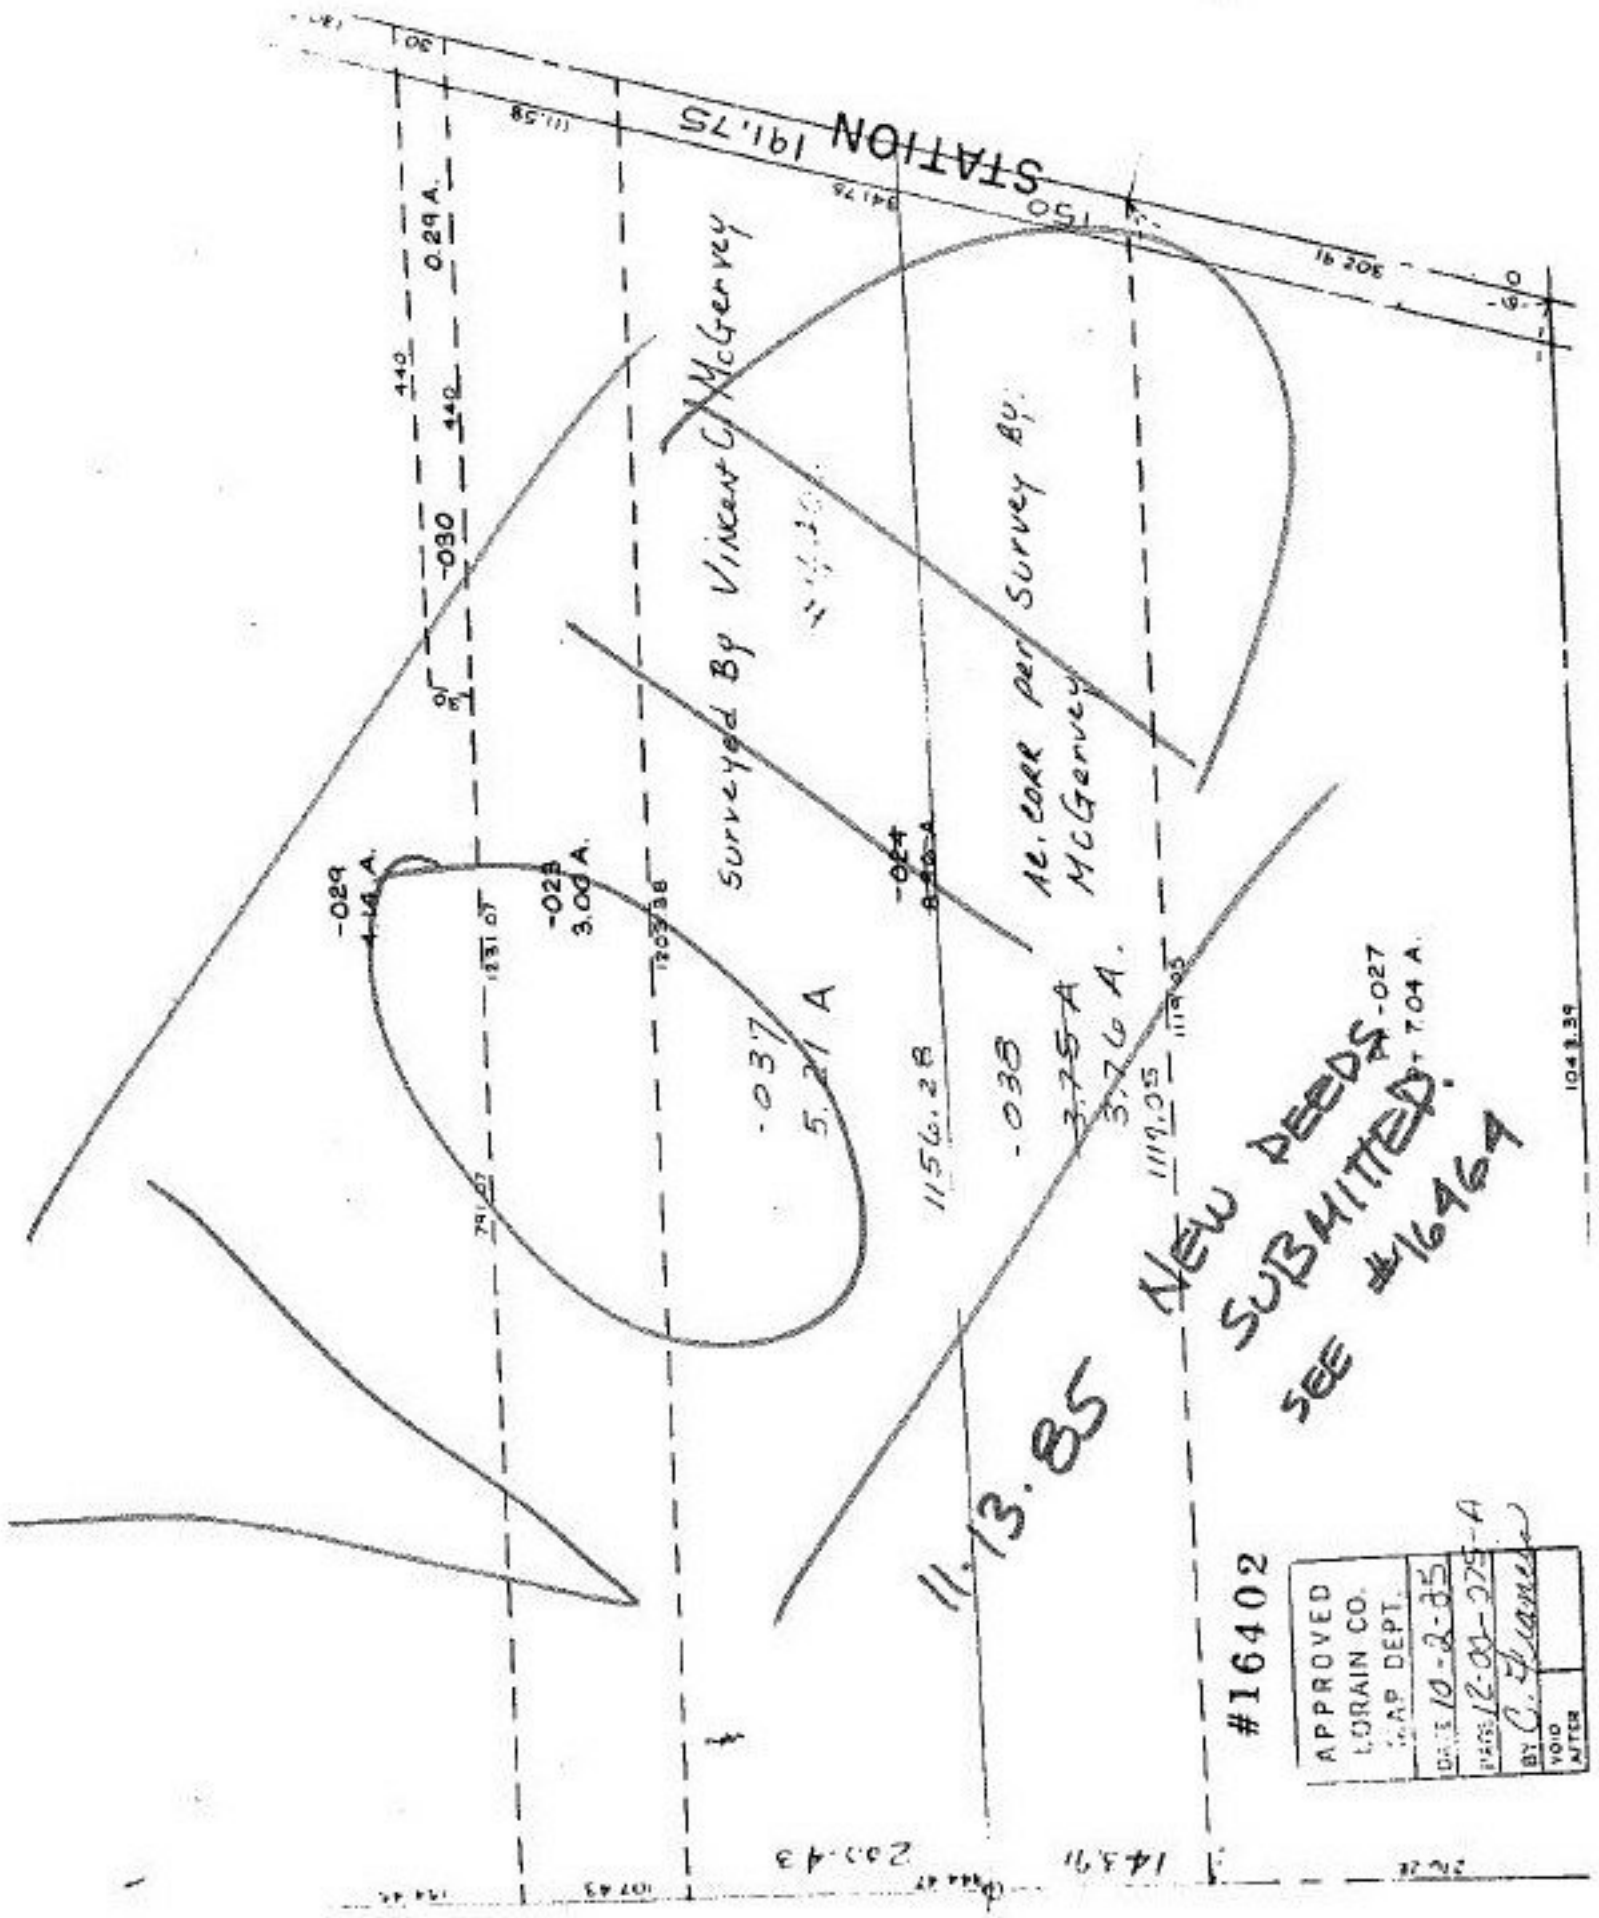
STATION 191.75
150
0.29 A.
-030
-029
-023
3.00 A.
-024
Surveyed By Vincent C. McGervey
Ac. Corr per Survey By McGervey
-037
5.21 A
-038
3.75 A
3.76 A.
1156.28
1119.05
-027
7.04 A.
11.13.85 NEW DEEDS SUBMITTED. SEE #16464
#16402
APPROVED
LORAIN CO.
MAP DEPT.
DATE 10-2-85
PAGE 12-00-075-A
BY C. Frames
VOID AFTER