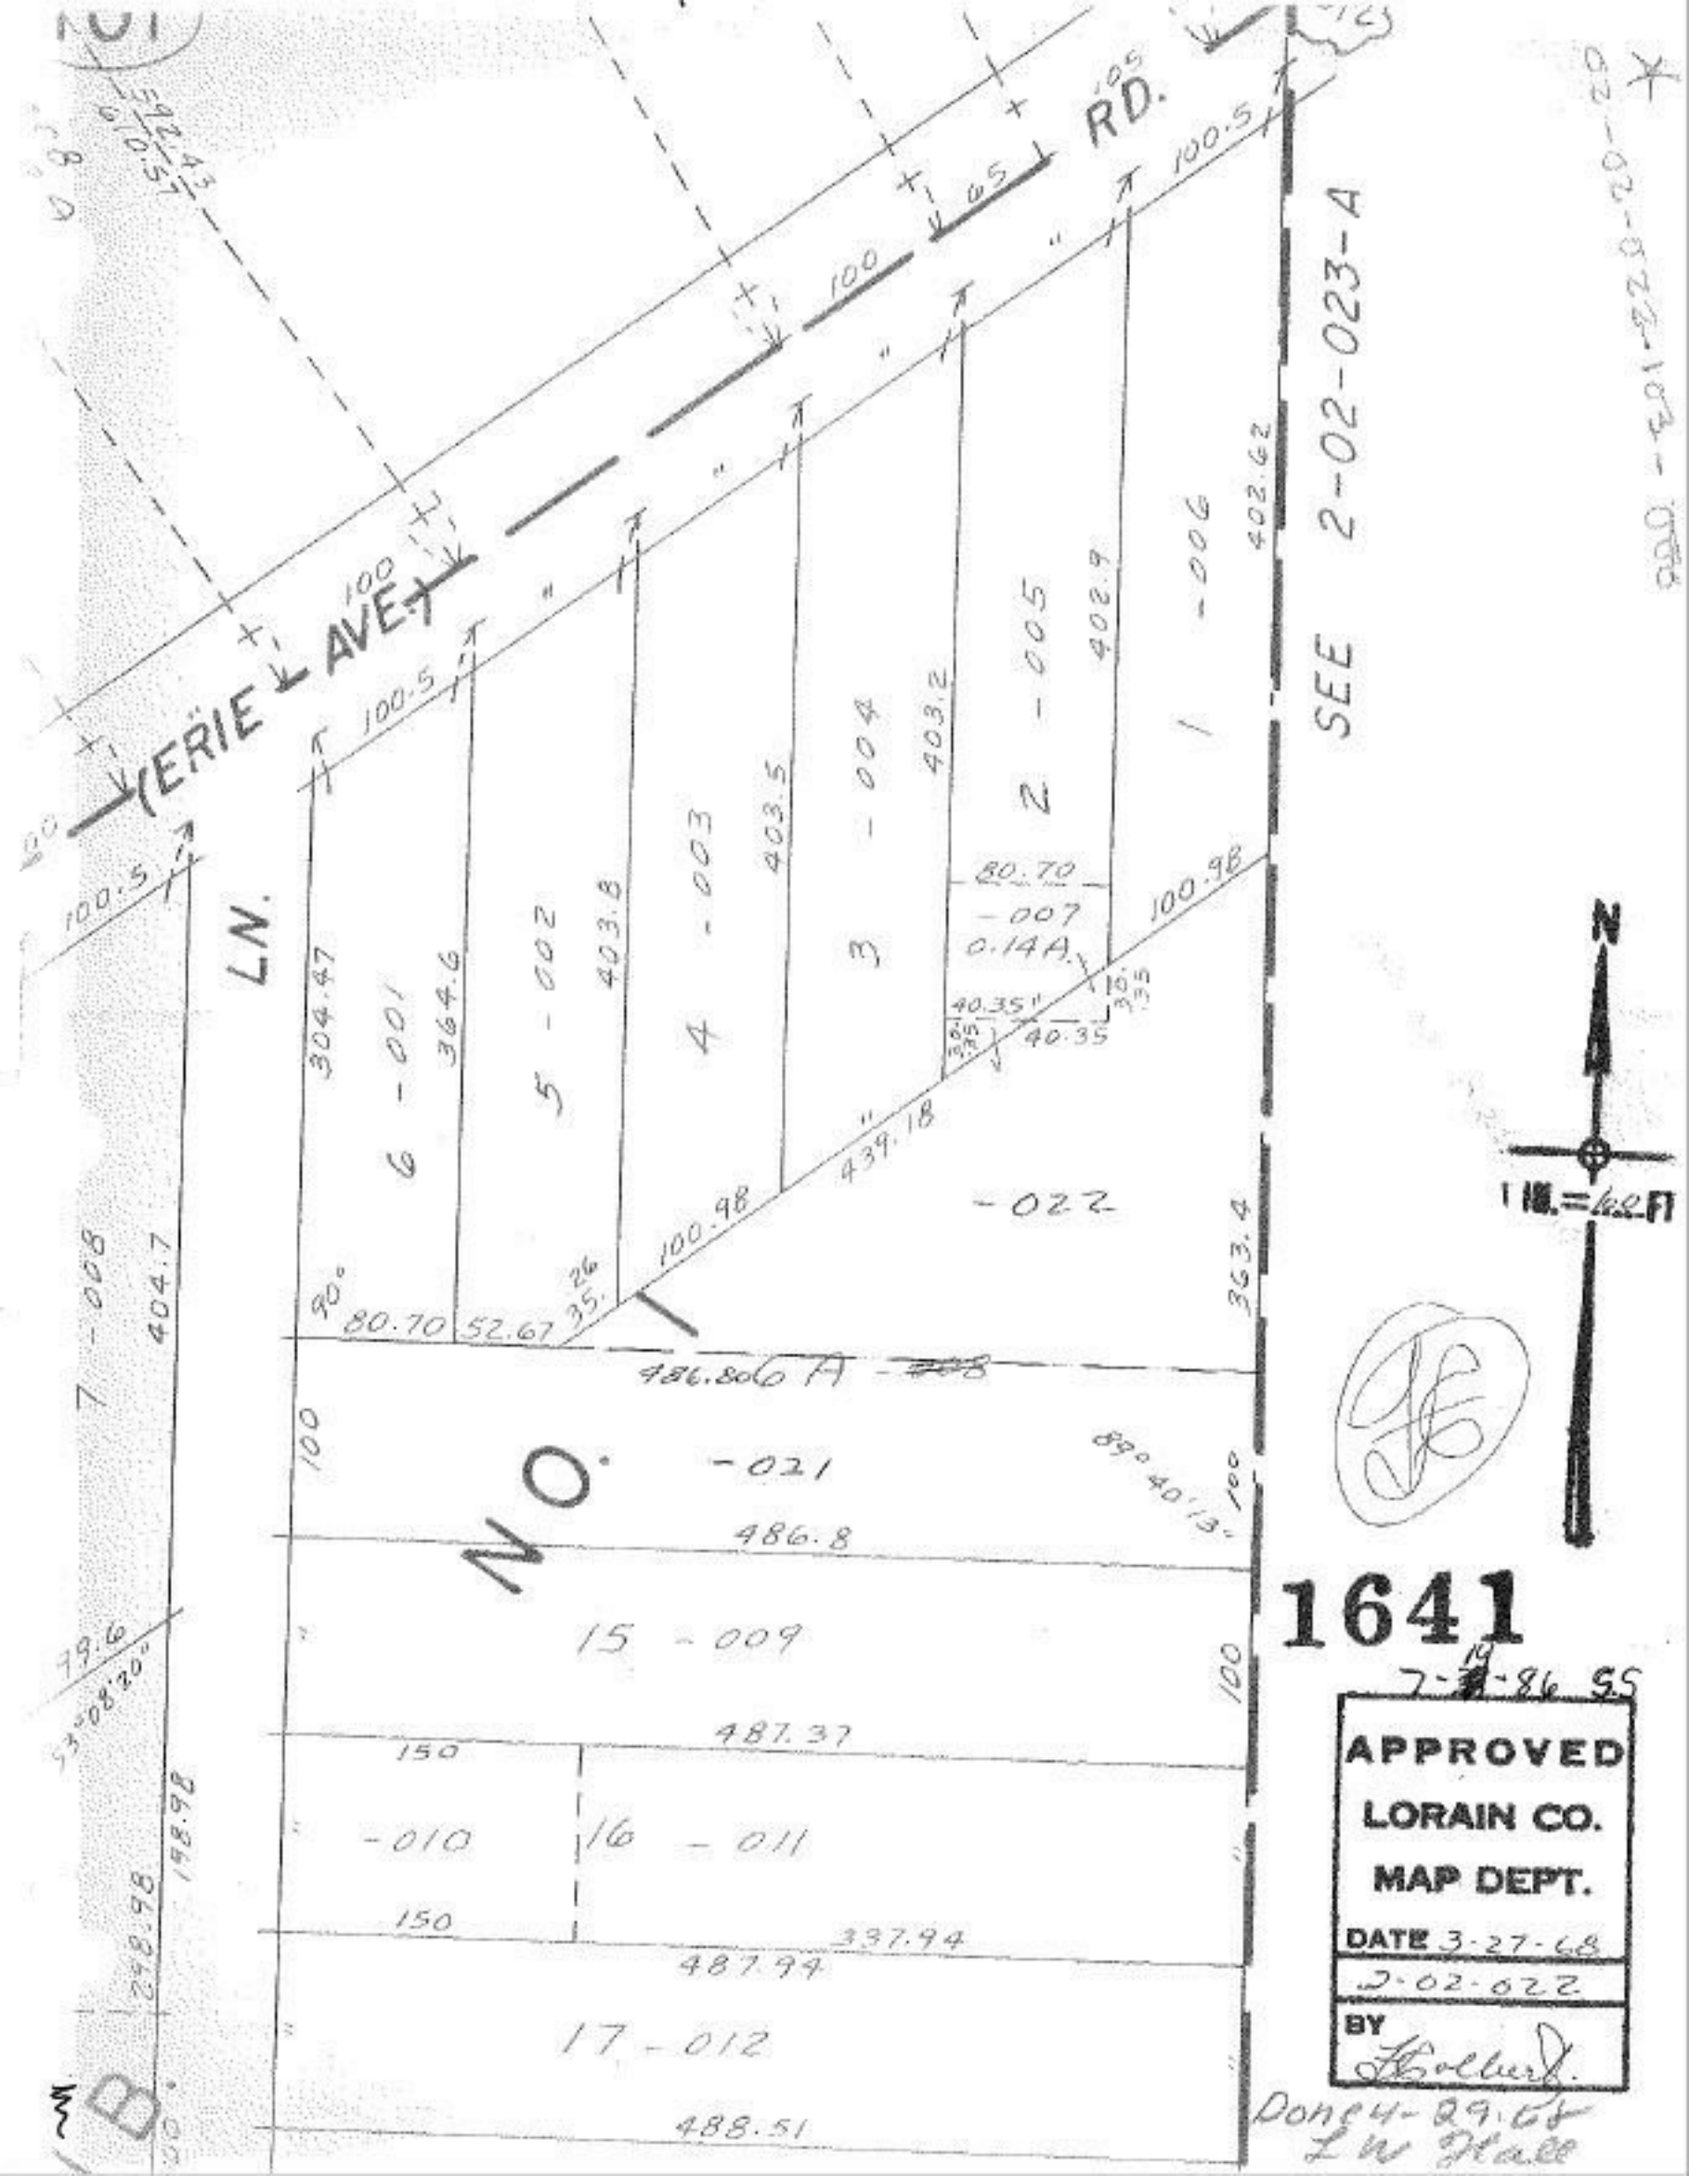

1641

7-14-86 SS

APPROVED
LORAIN CO.
MAP DEPT.
DATE 3-27-68
2-02-022
BY

Done 4-29-68
LW Hall