* SEE SURVEY - KLEINGEDER SCHMIDT & ASSOC.

① CL. 1:38461

② CL. 1:250000

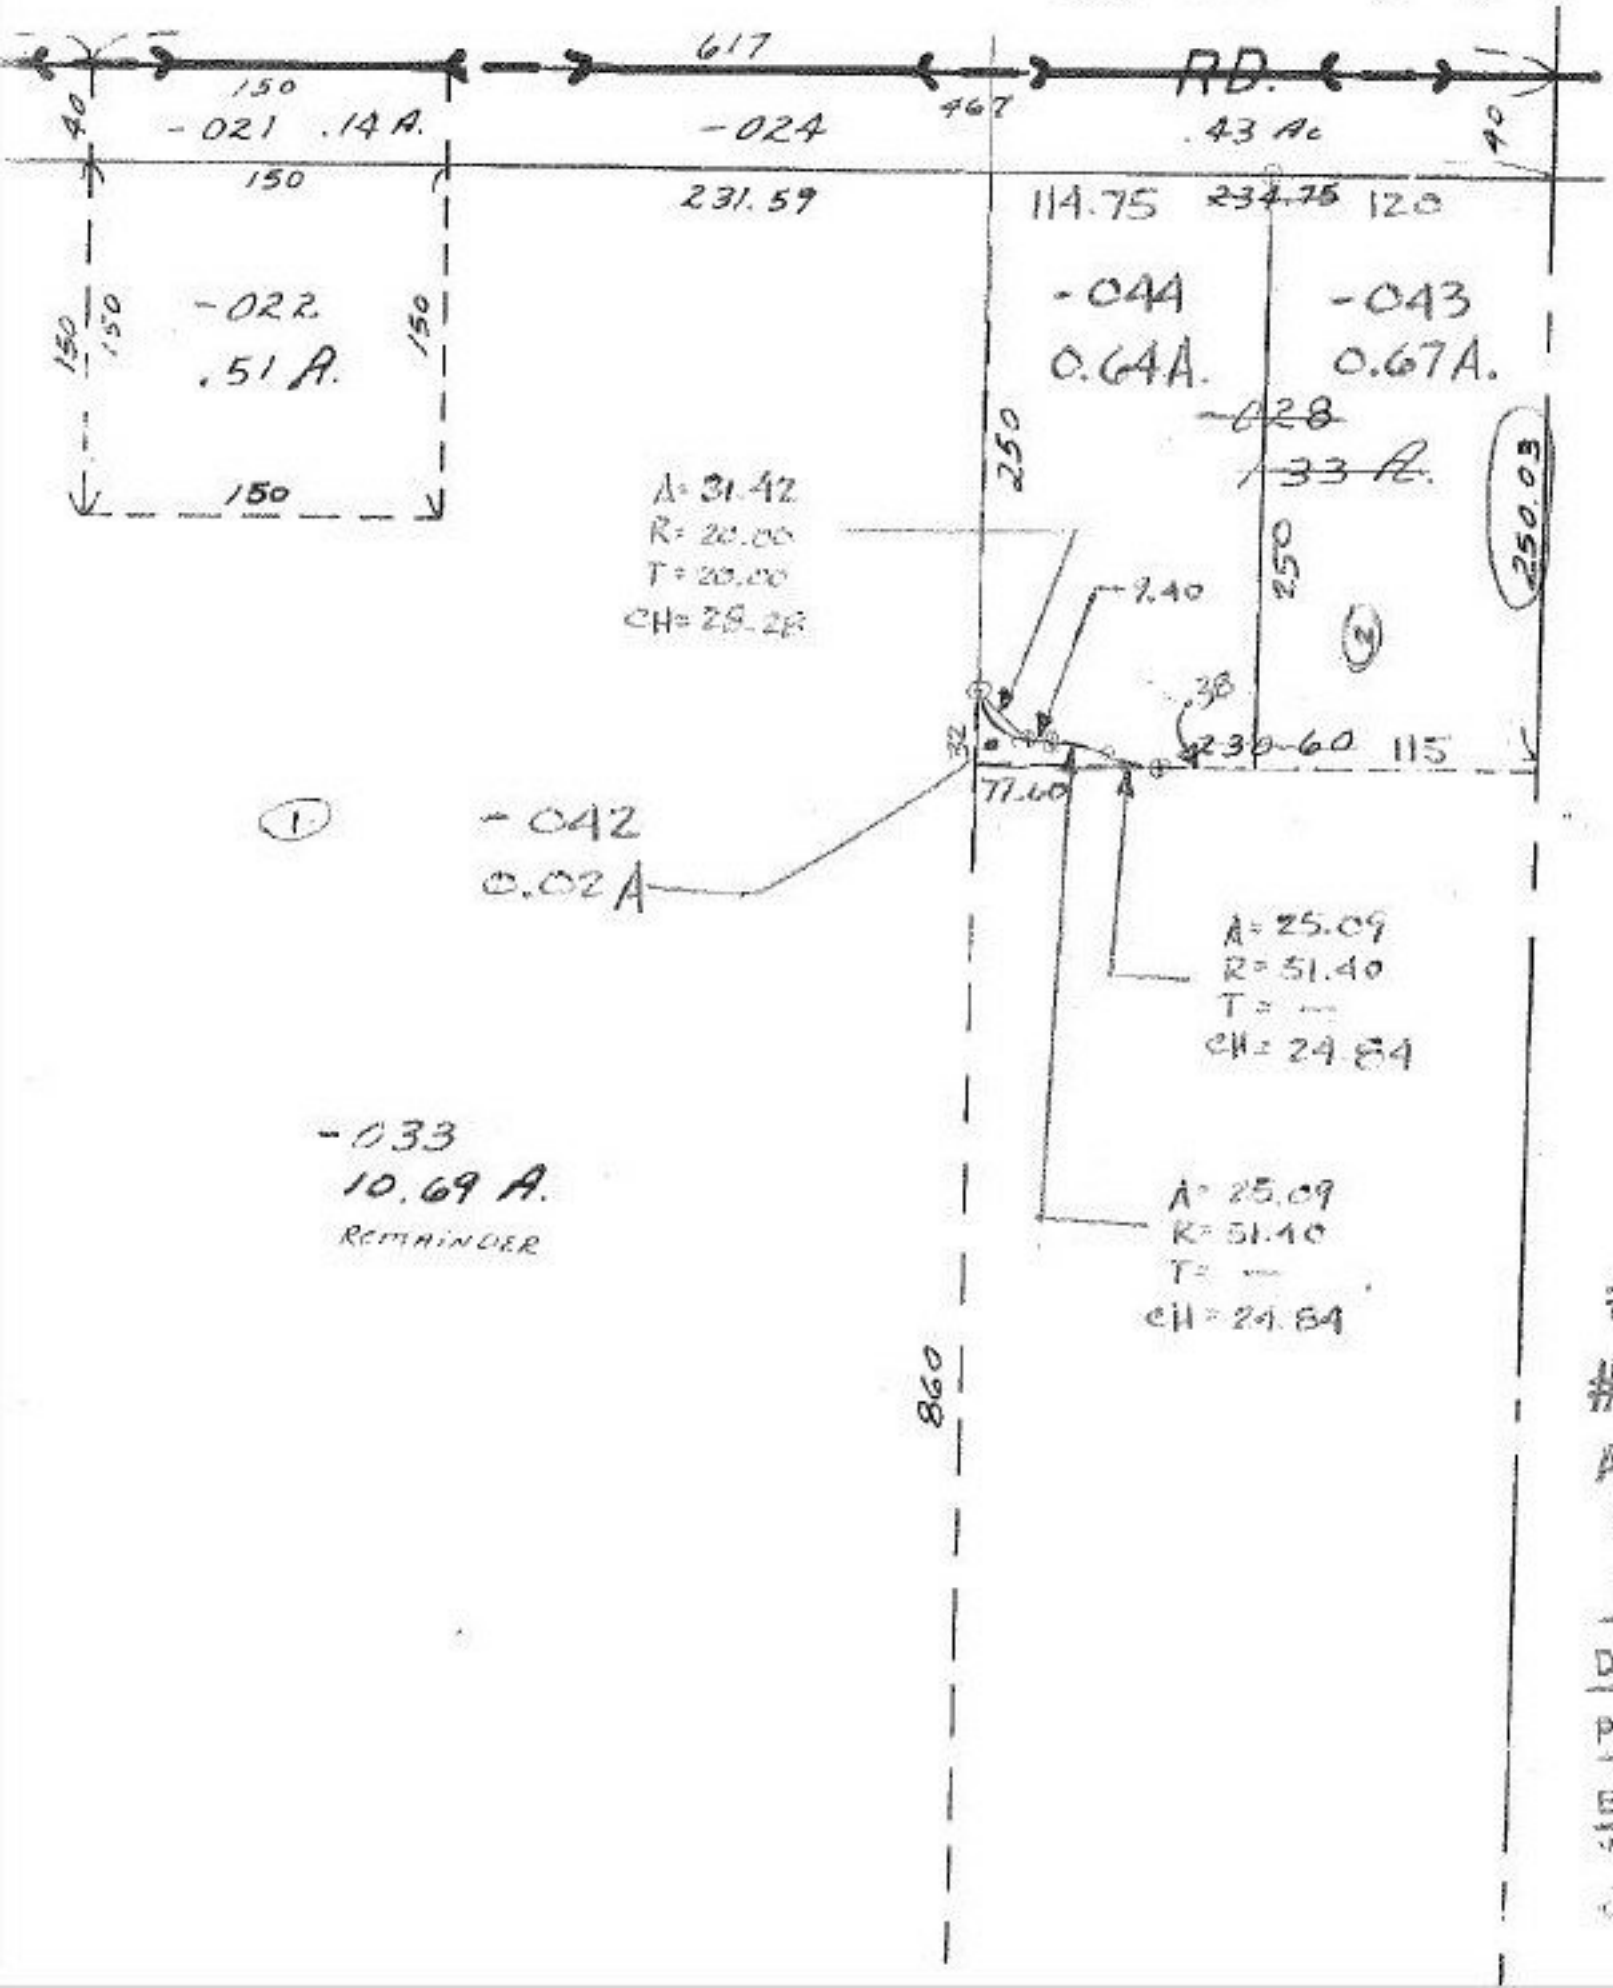


#16414
#16415
APPROVED
LORAIN CO.
MAP DEPT.
DATE 10.18.85
PAGE 5-00-041-B
BY T. McNair
VOID.
SH 3-28-86