6-1-87 Cb

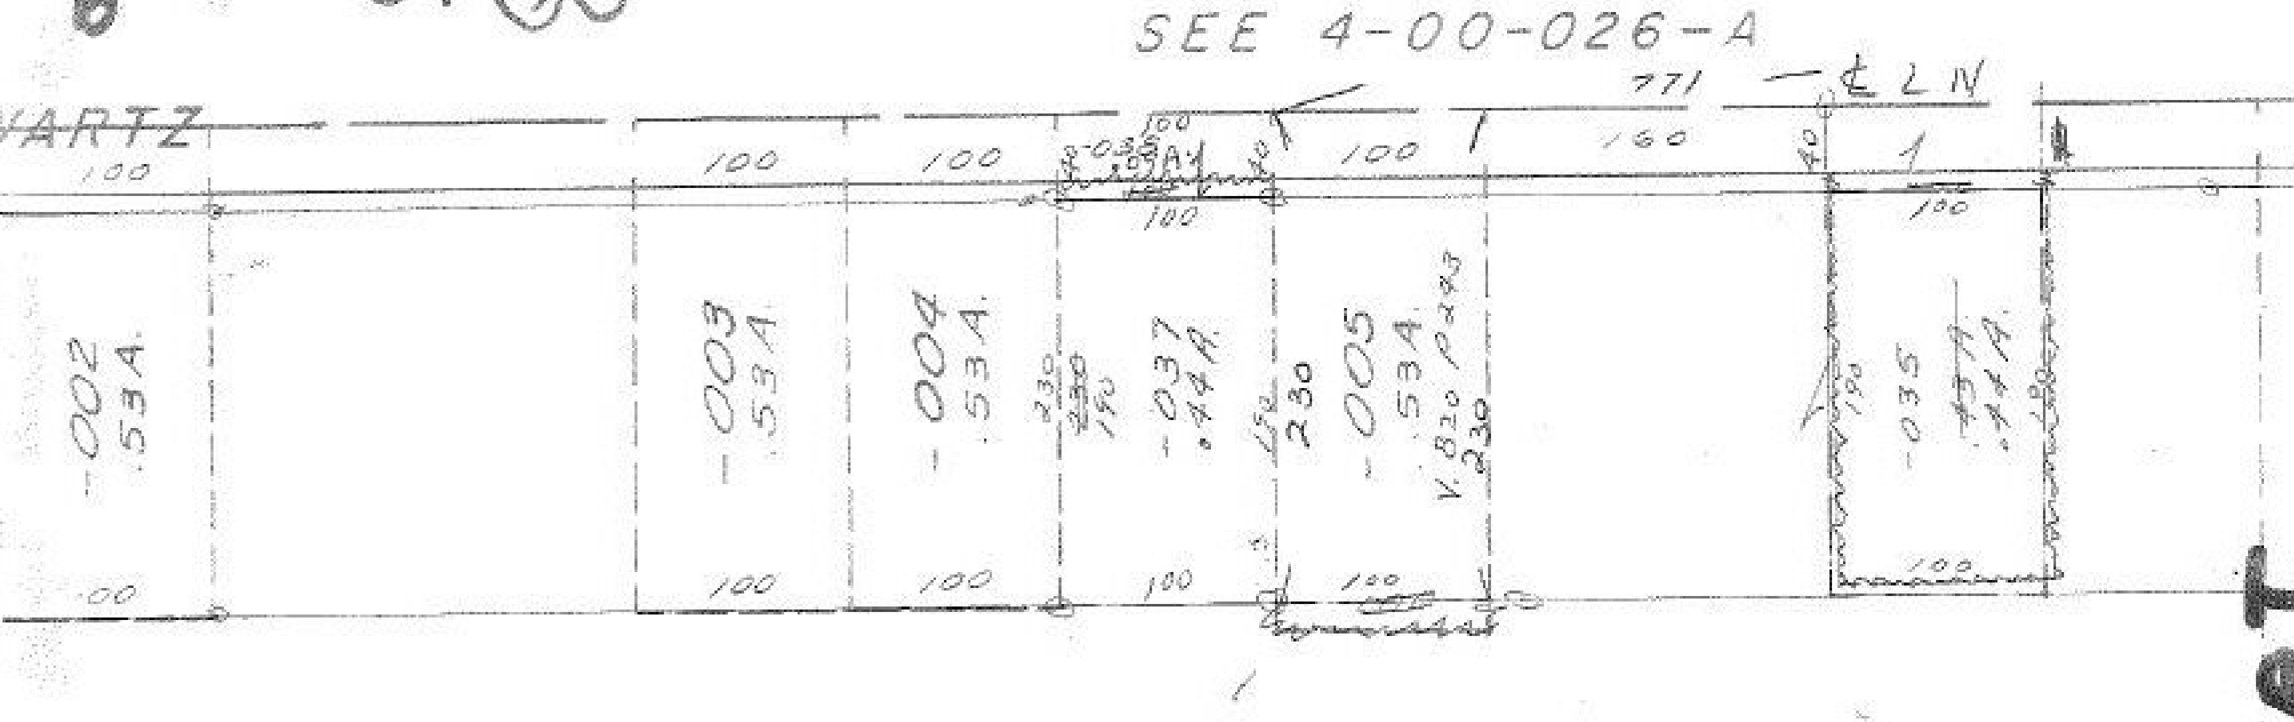

~~-036~~ -039
~~71.38A.~~ 70.85 A.

DWB 78-51-L
~~#1642~~
APPROVED
LORAIN CO.
MAP DEPT.
DATE 4-16-68
BY 4-00-026-E
F. Colbert

DONE 5-4-68
FRANK COLBERT.