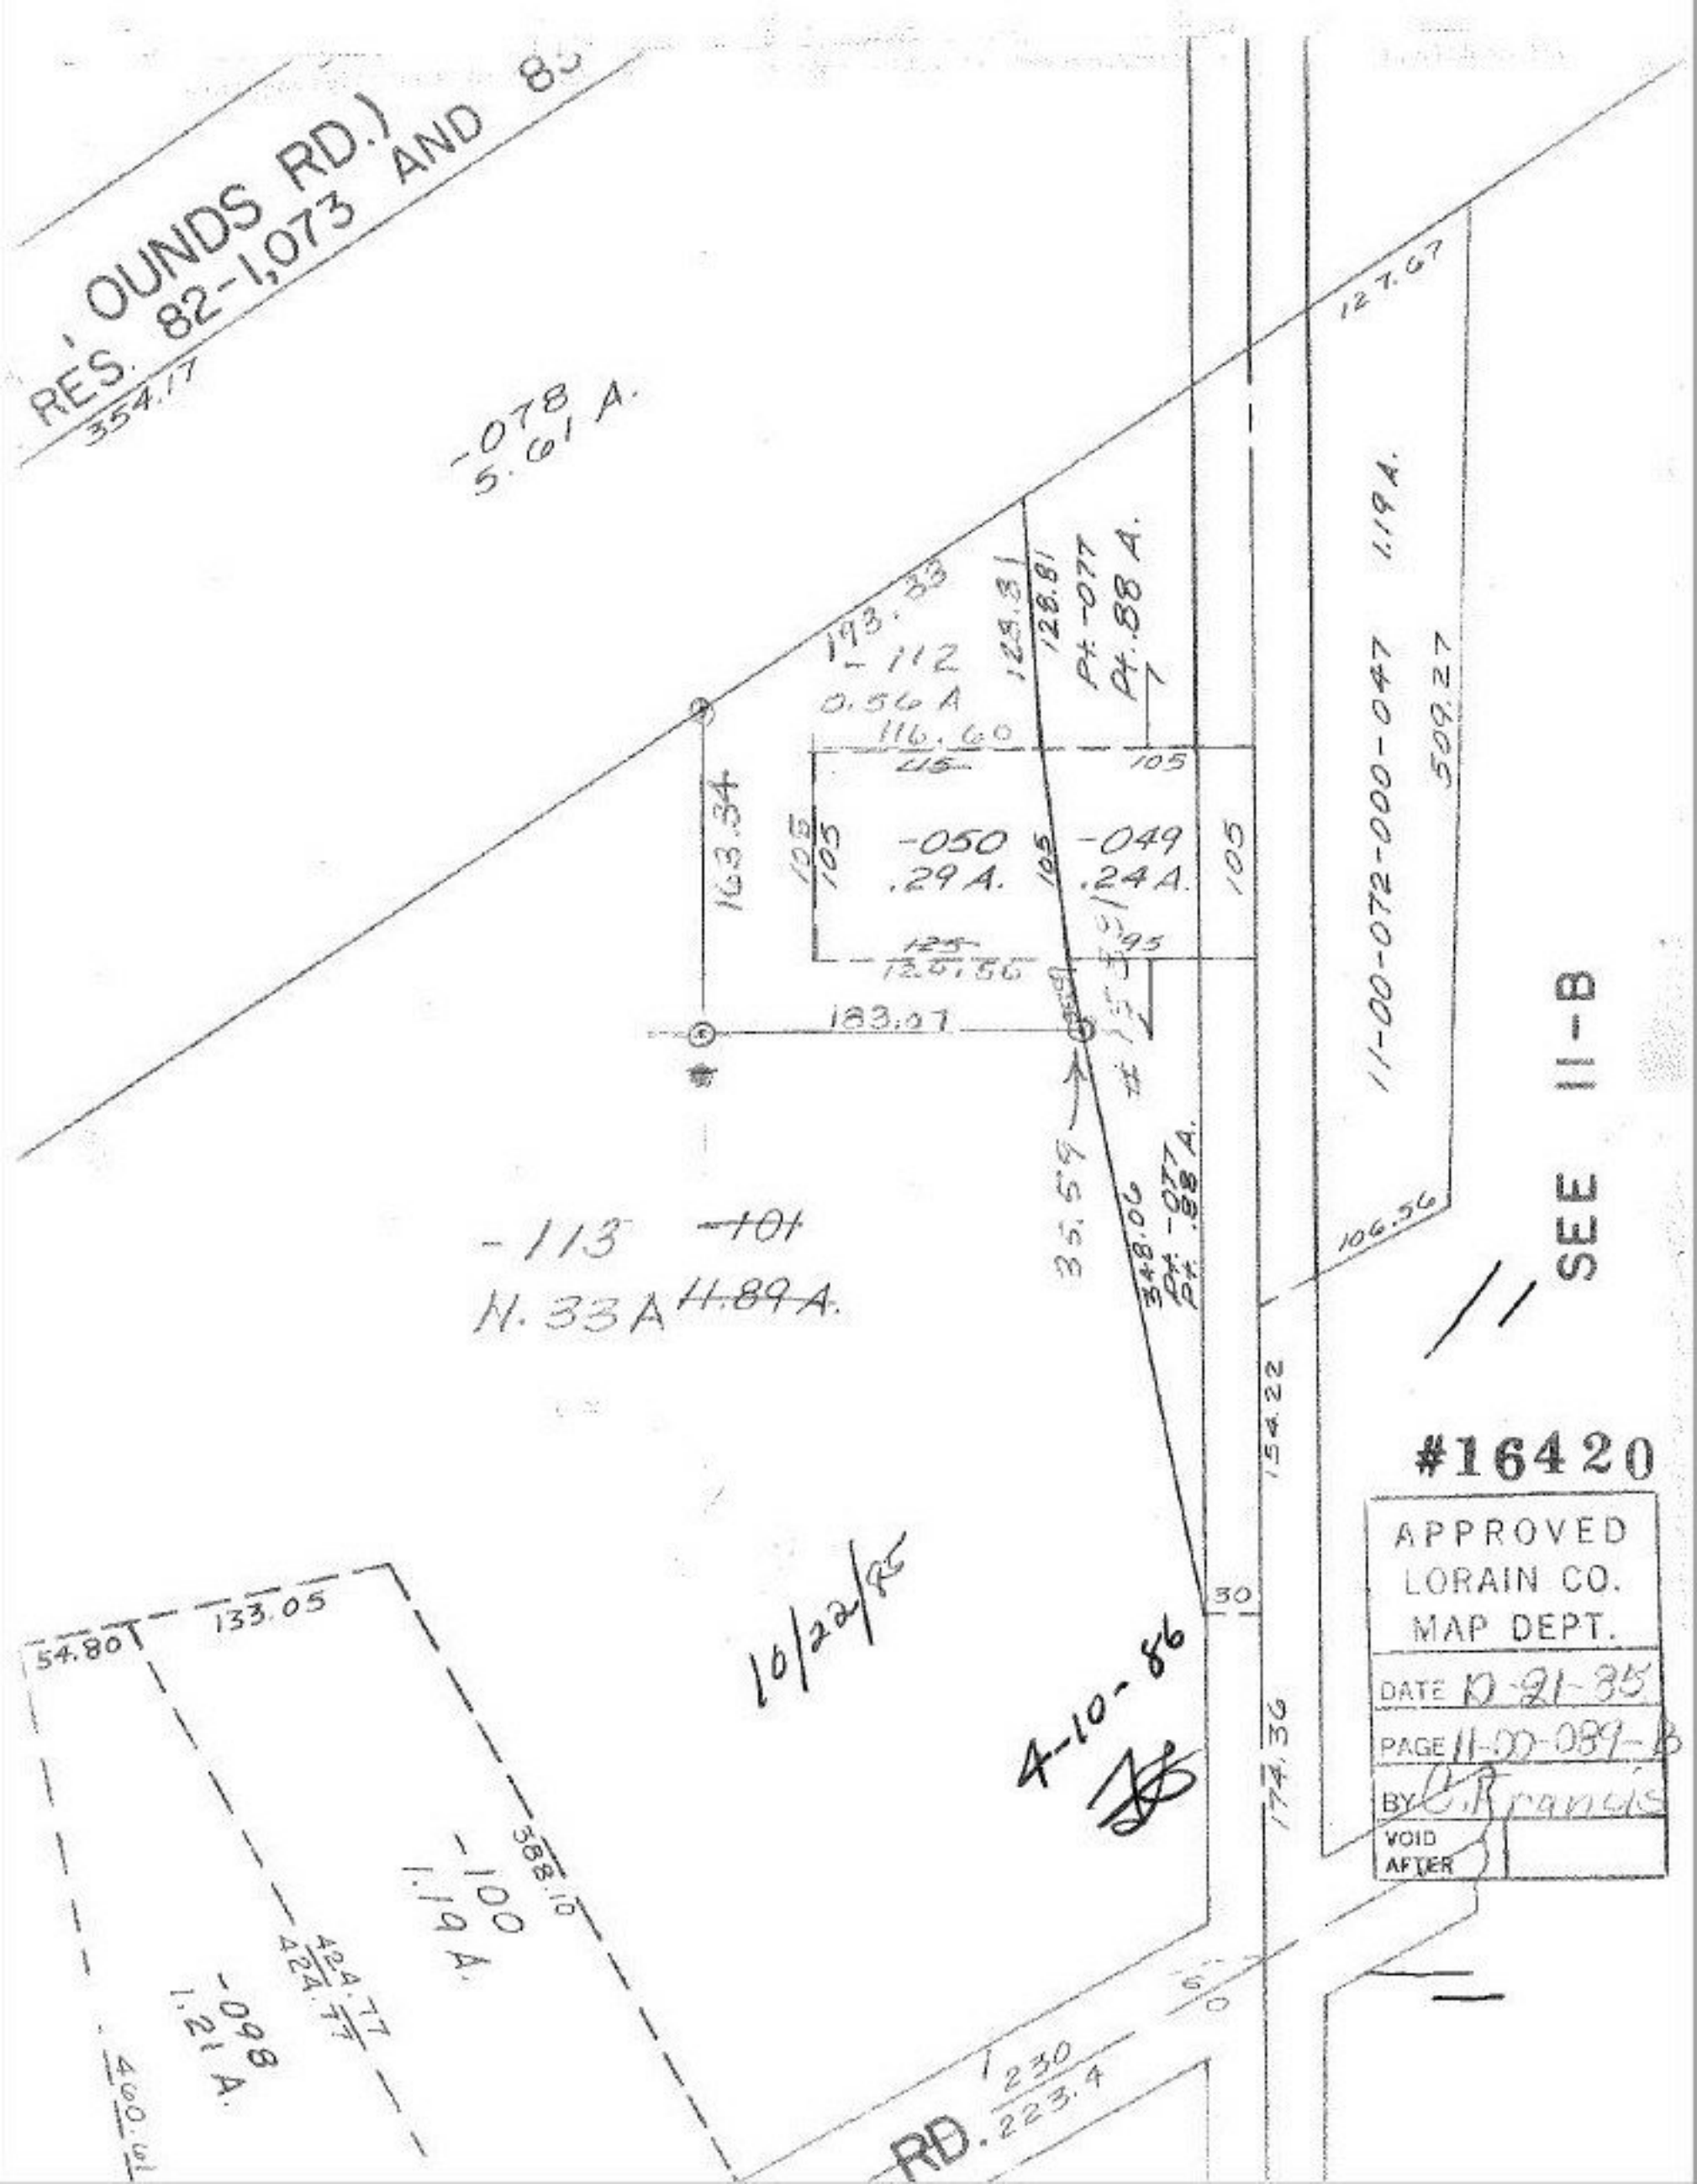

OUNDS RD.)
RES. 82-1,073 AND 83
354.17
-078
5.61 A.
127.67
193.33
-112
0.56 A
116.60
128.81
128.81
Pt.-077
Pt.88 A.
1.19 A.
11-00-072-000-047
509.27
163.34
105
105
-050
.29 A.
105
-049
.24 A.
105
125
124.56
95
183.07
35.59
348.06
Pt.-077
Pt.88 A.
106.56
SEE II-B
-113
~~-101~~
N.33A ~~11.89 A.~~
154.22
#16420
APPROVED
LORAIN CO.
MAP DEPT.
DATE 10-21-85
PAGE 11-00-089-B
BY C. Francis
VOID
AFTER
30
10/22/85
4-10-86
174.36
54.80
133.05
388.10
-100
1.19 A.
424.77
424.77
-098
1.21 A.
460.61
230
223.4
RD.