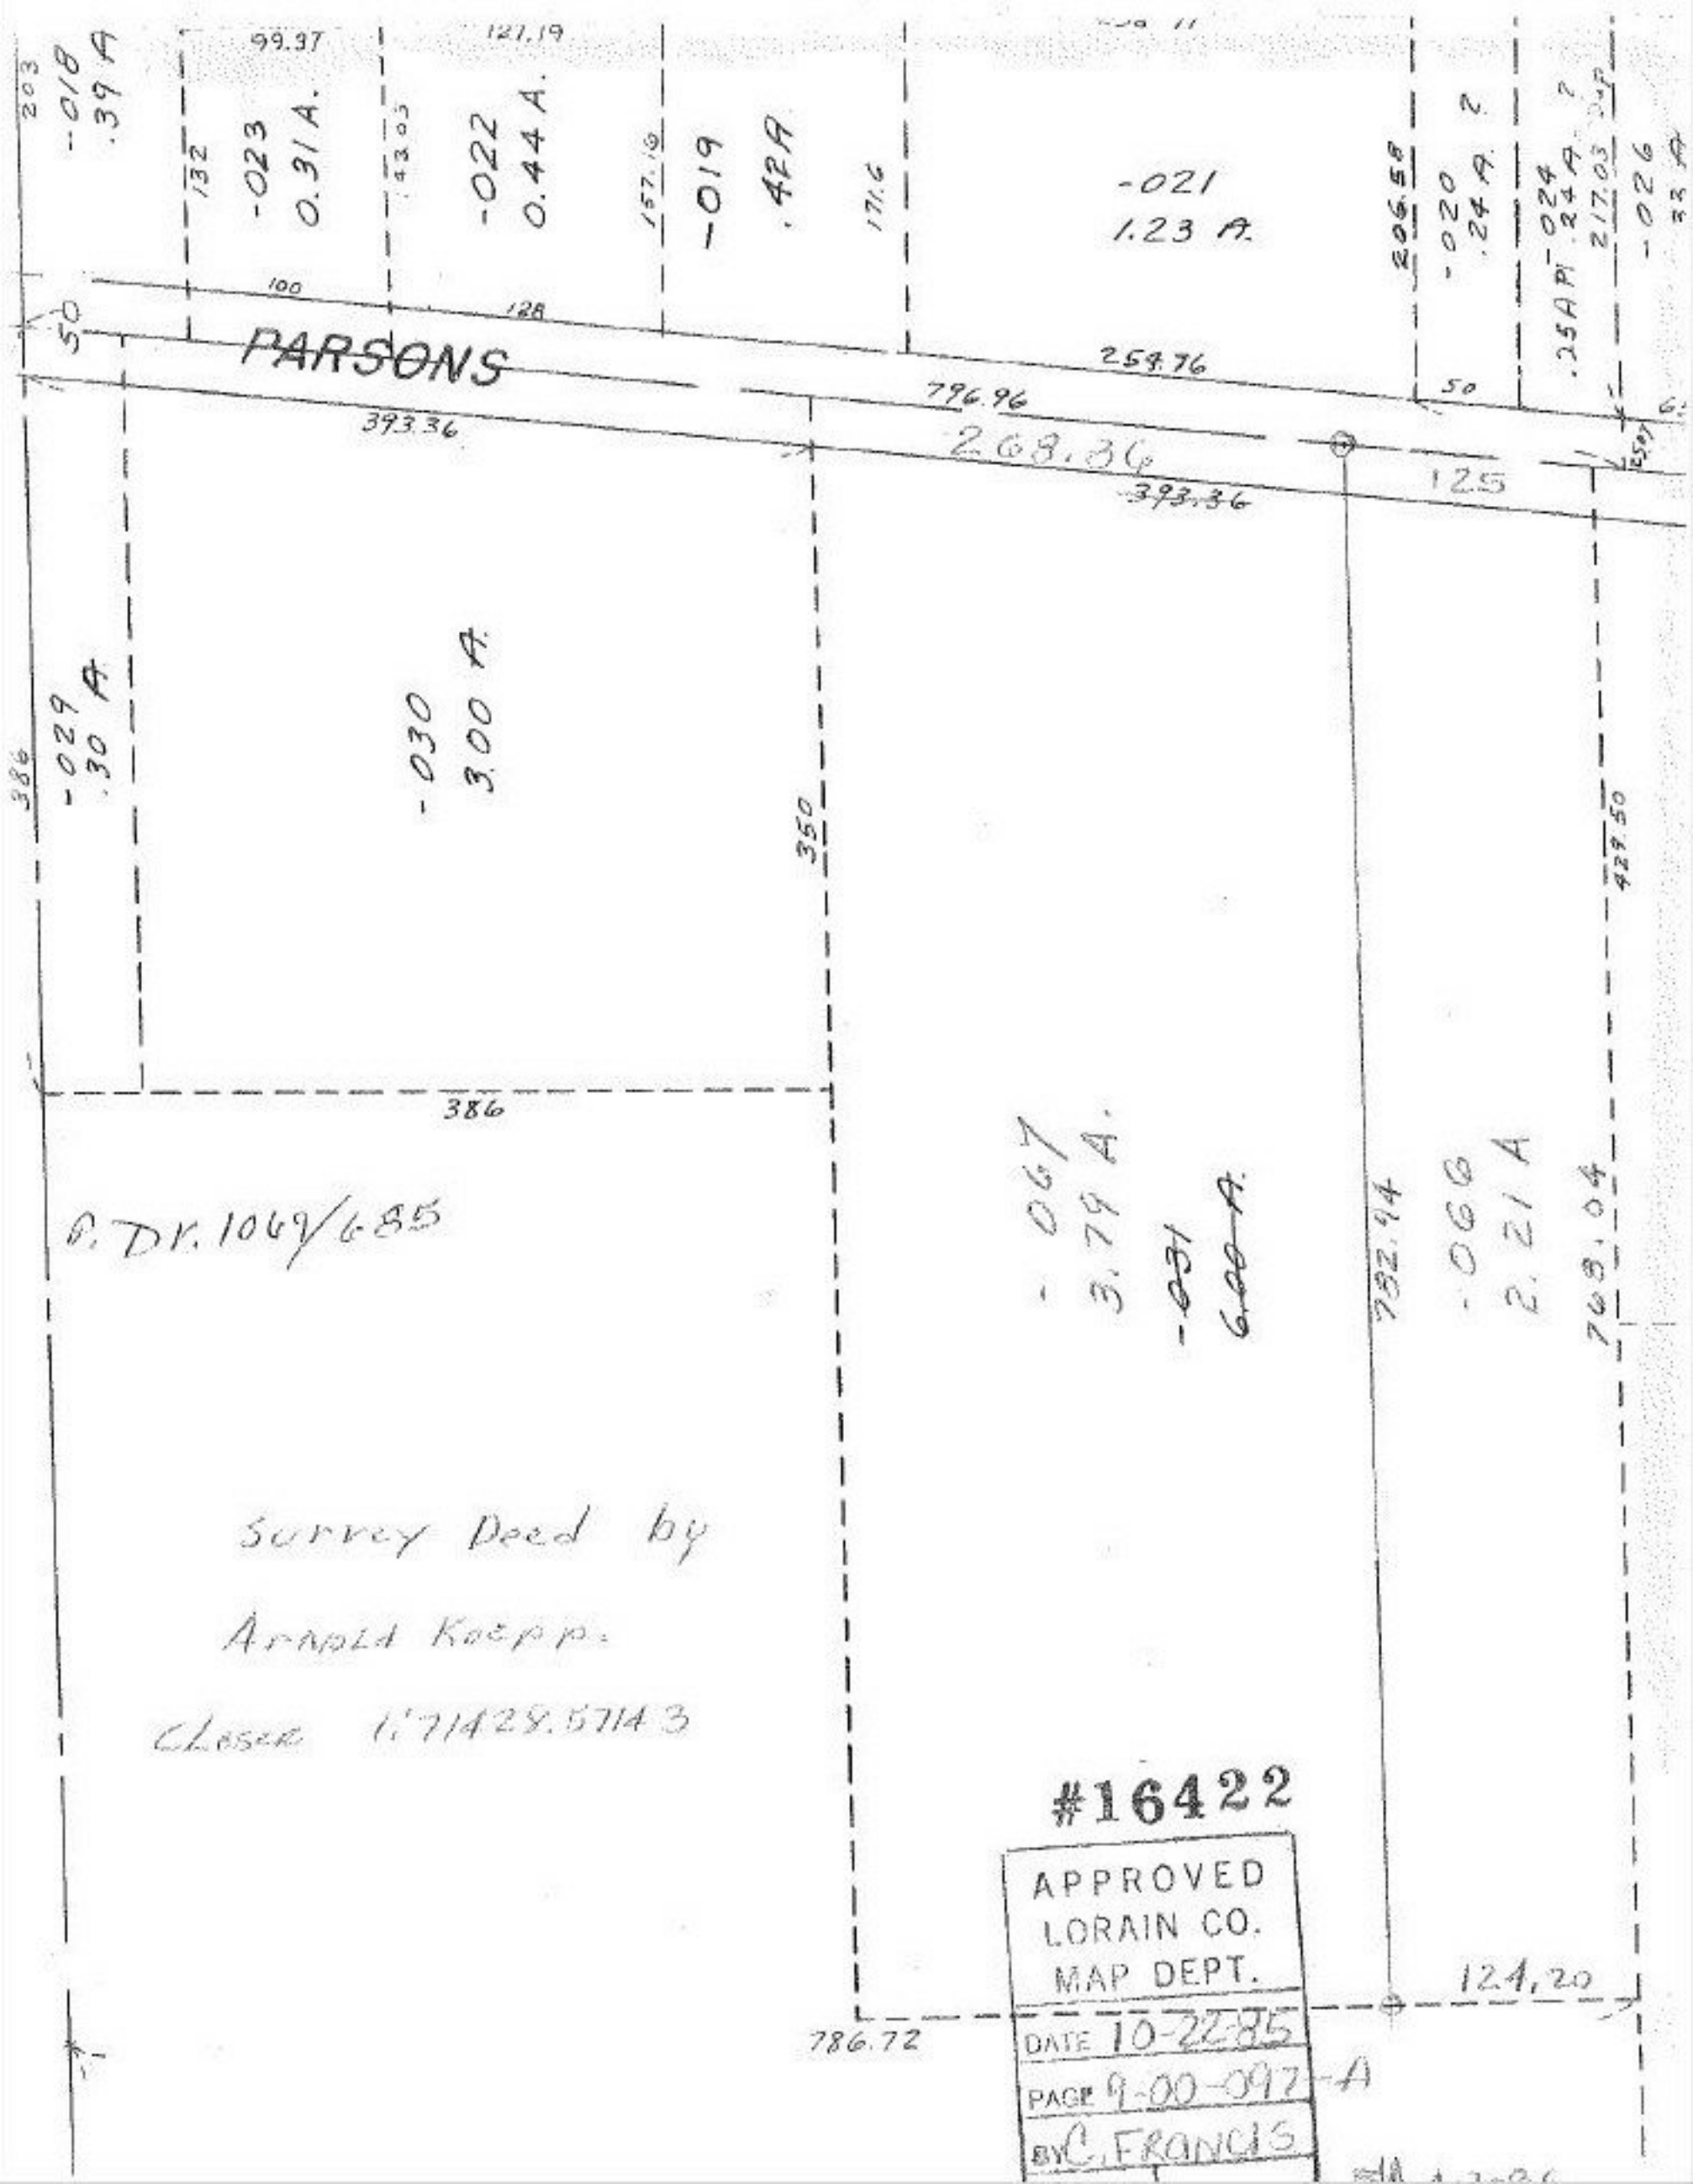

-018
.39 A
-023
0.31 A.
-022
0.44 A.
-019
.42 A
-021
1.23 A.
-020
.24 A.
-024
.24 A.
-026
PARSONS
254.76
796.96
393.36
268.36
125
-029
.30 A
-030
3.00 A.
386
350
429.50
-067
3.79 A.
-031
6.00 A.
782.94
-066
2.21 A
768.04
P. Dr. 1069/685
Survey Deed by
Arnold Koepp.
Closer 1:71428.57143
#16422
APPROVED
LORAIN CO.
MAP DEPT.
DATE 10-22-85
PAGE 9-00-097-A
BY C. FRANCIS
124.20
786.72