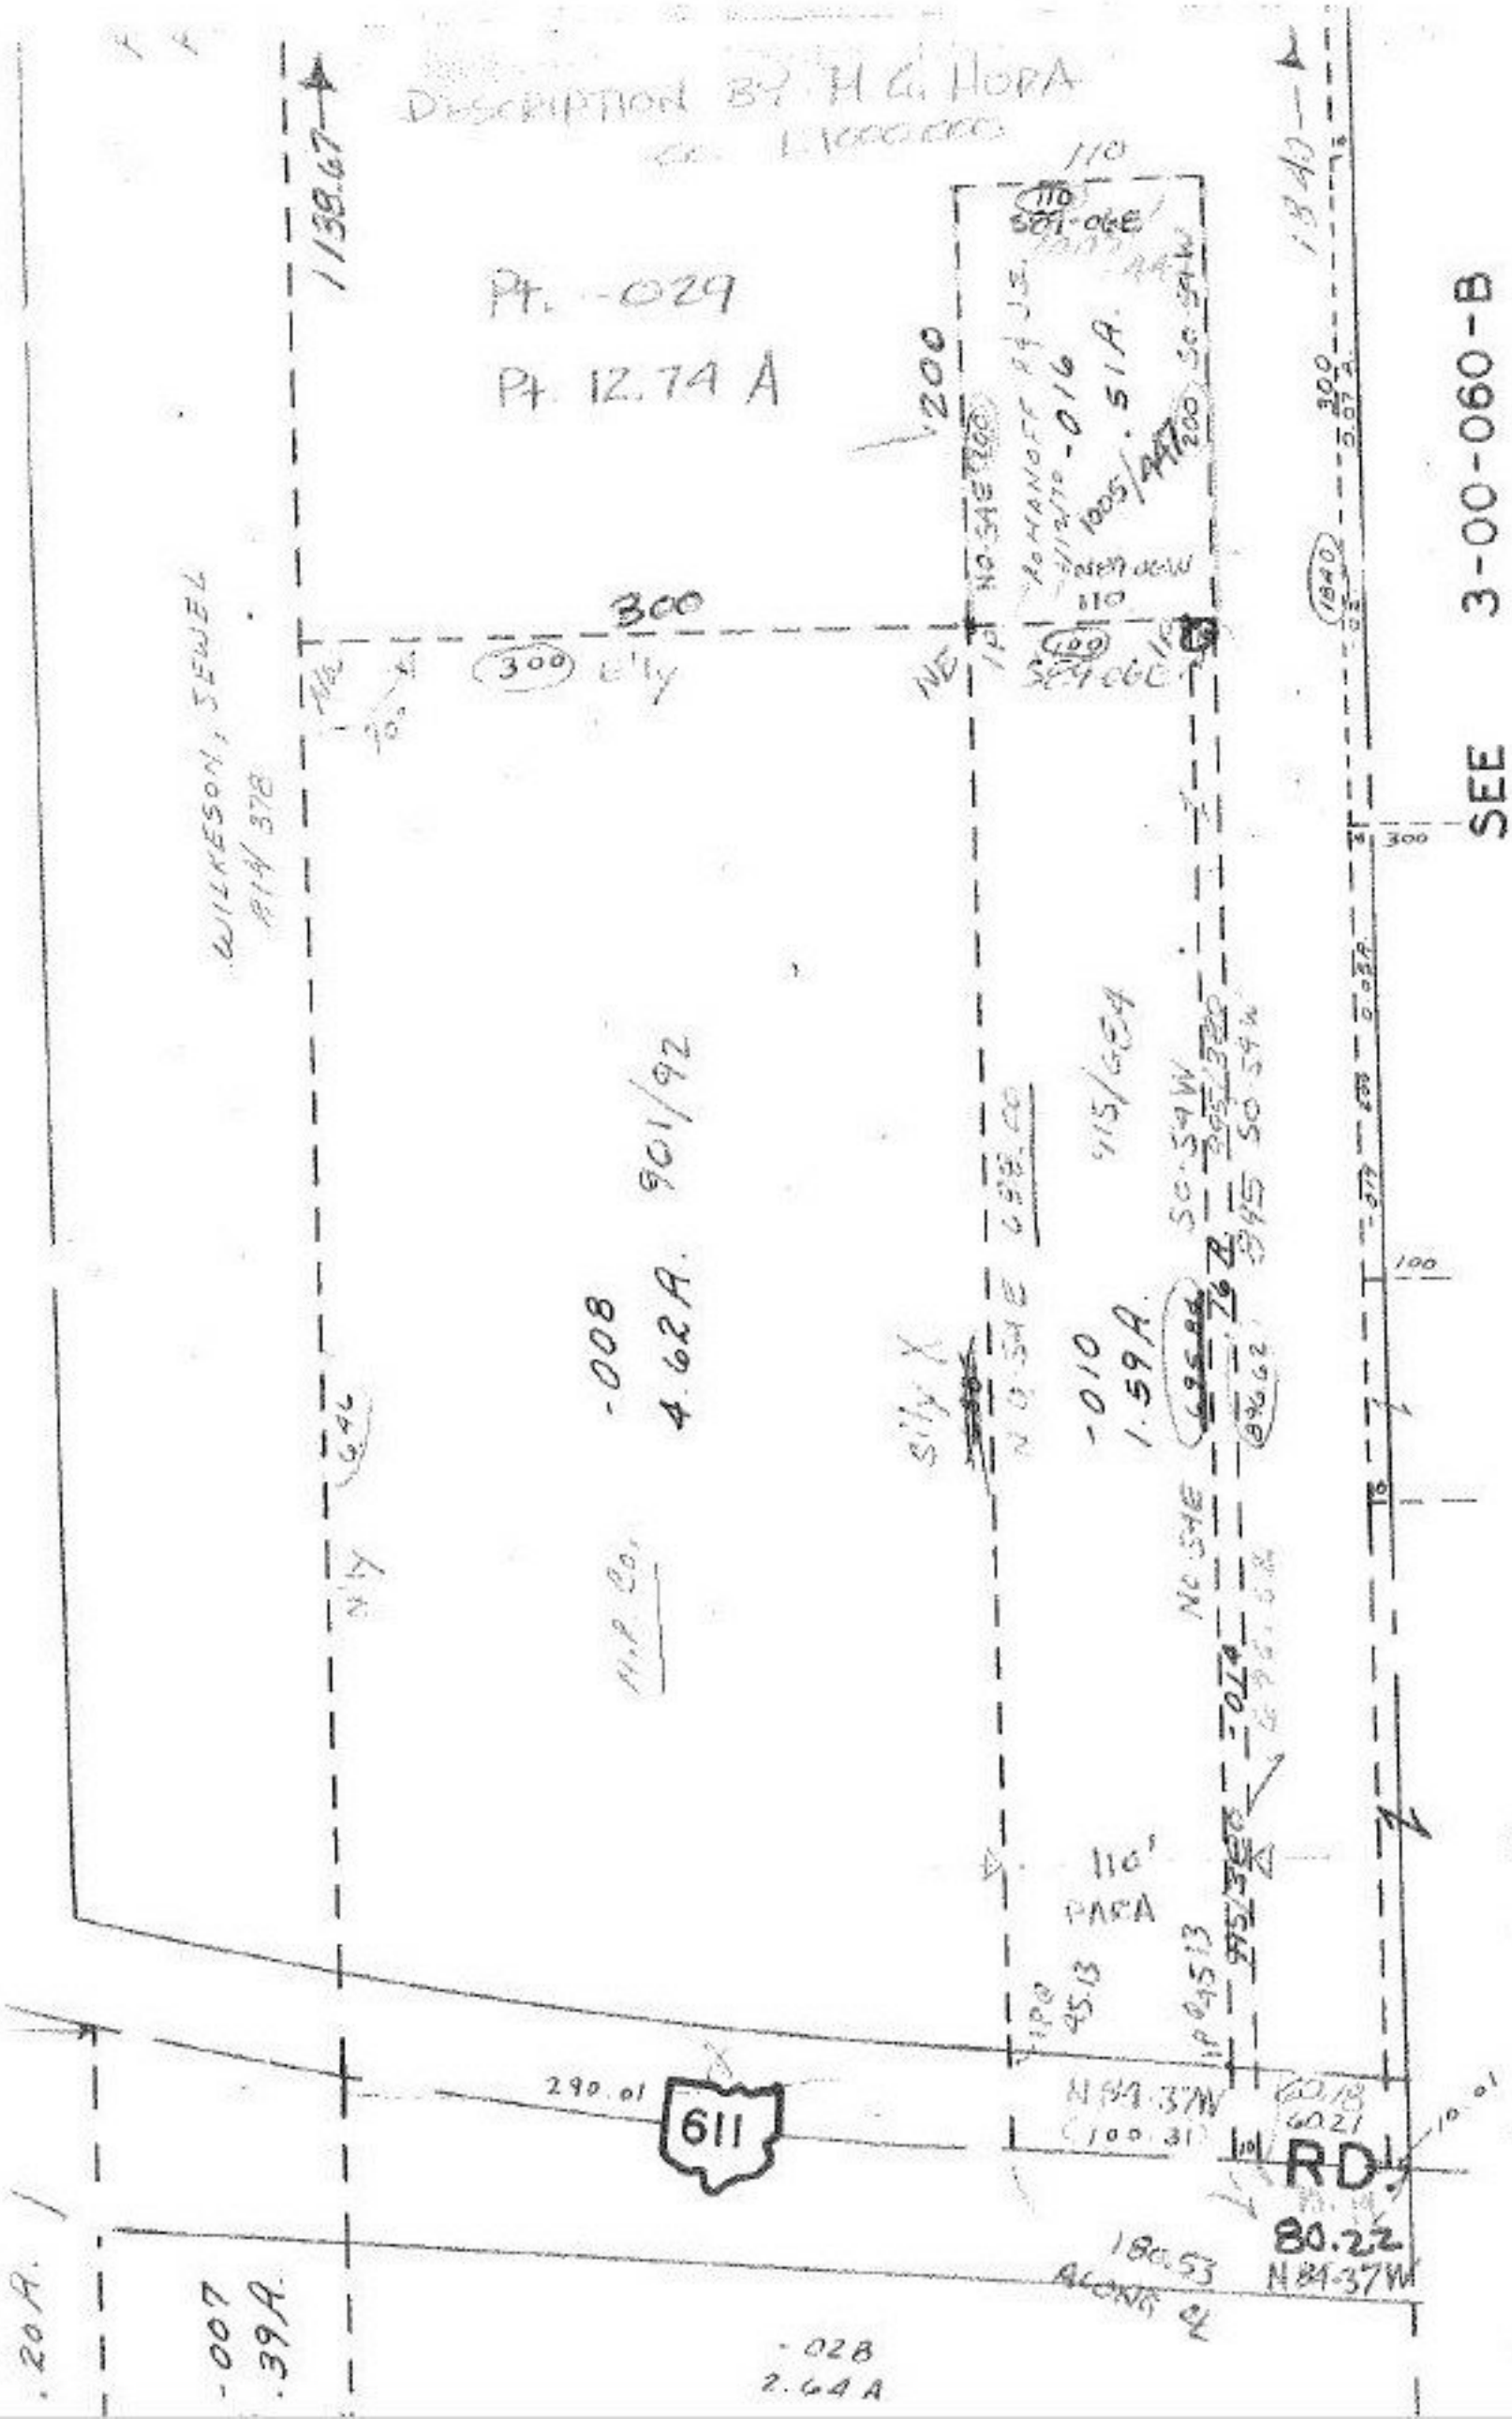

#16423
APPROVED
LORAIN CO.
MAP DEPT.
DATE 12-24-85
PAGE 3-00-059-1
BY T McMain
VOID
3-25-86