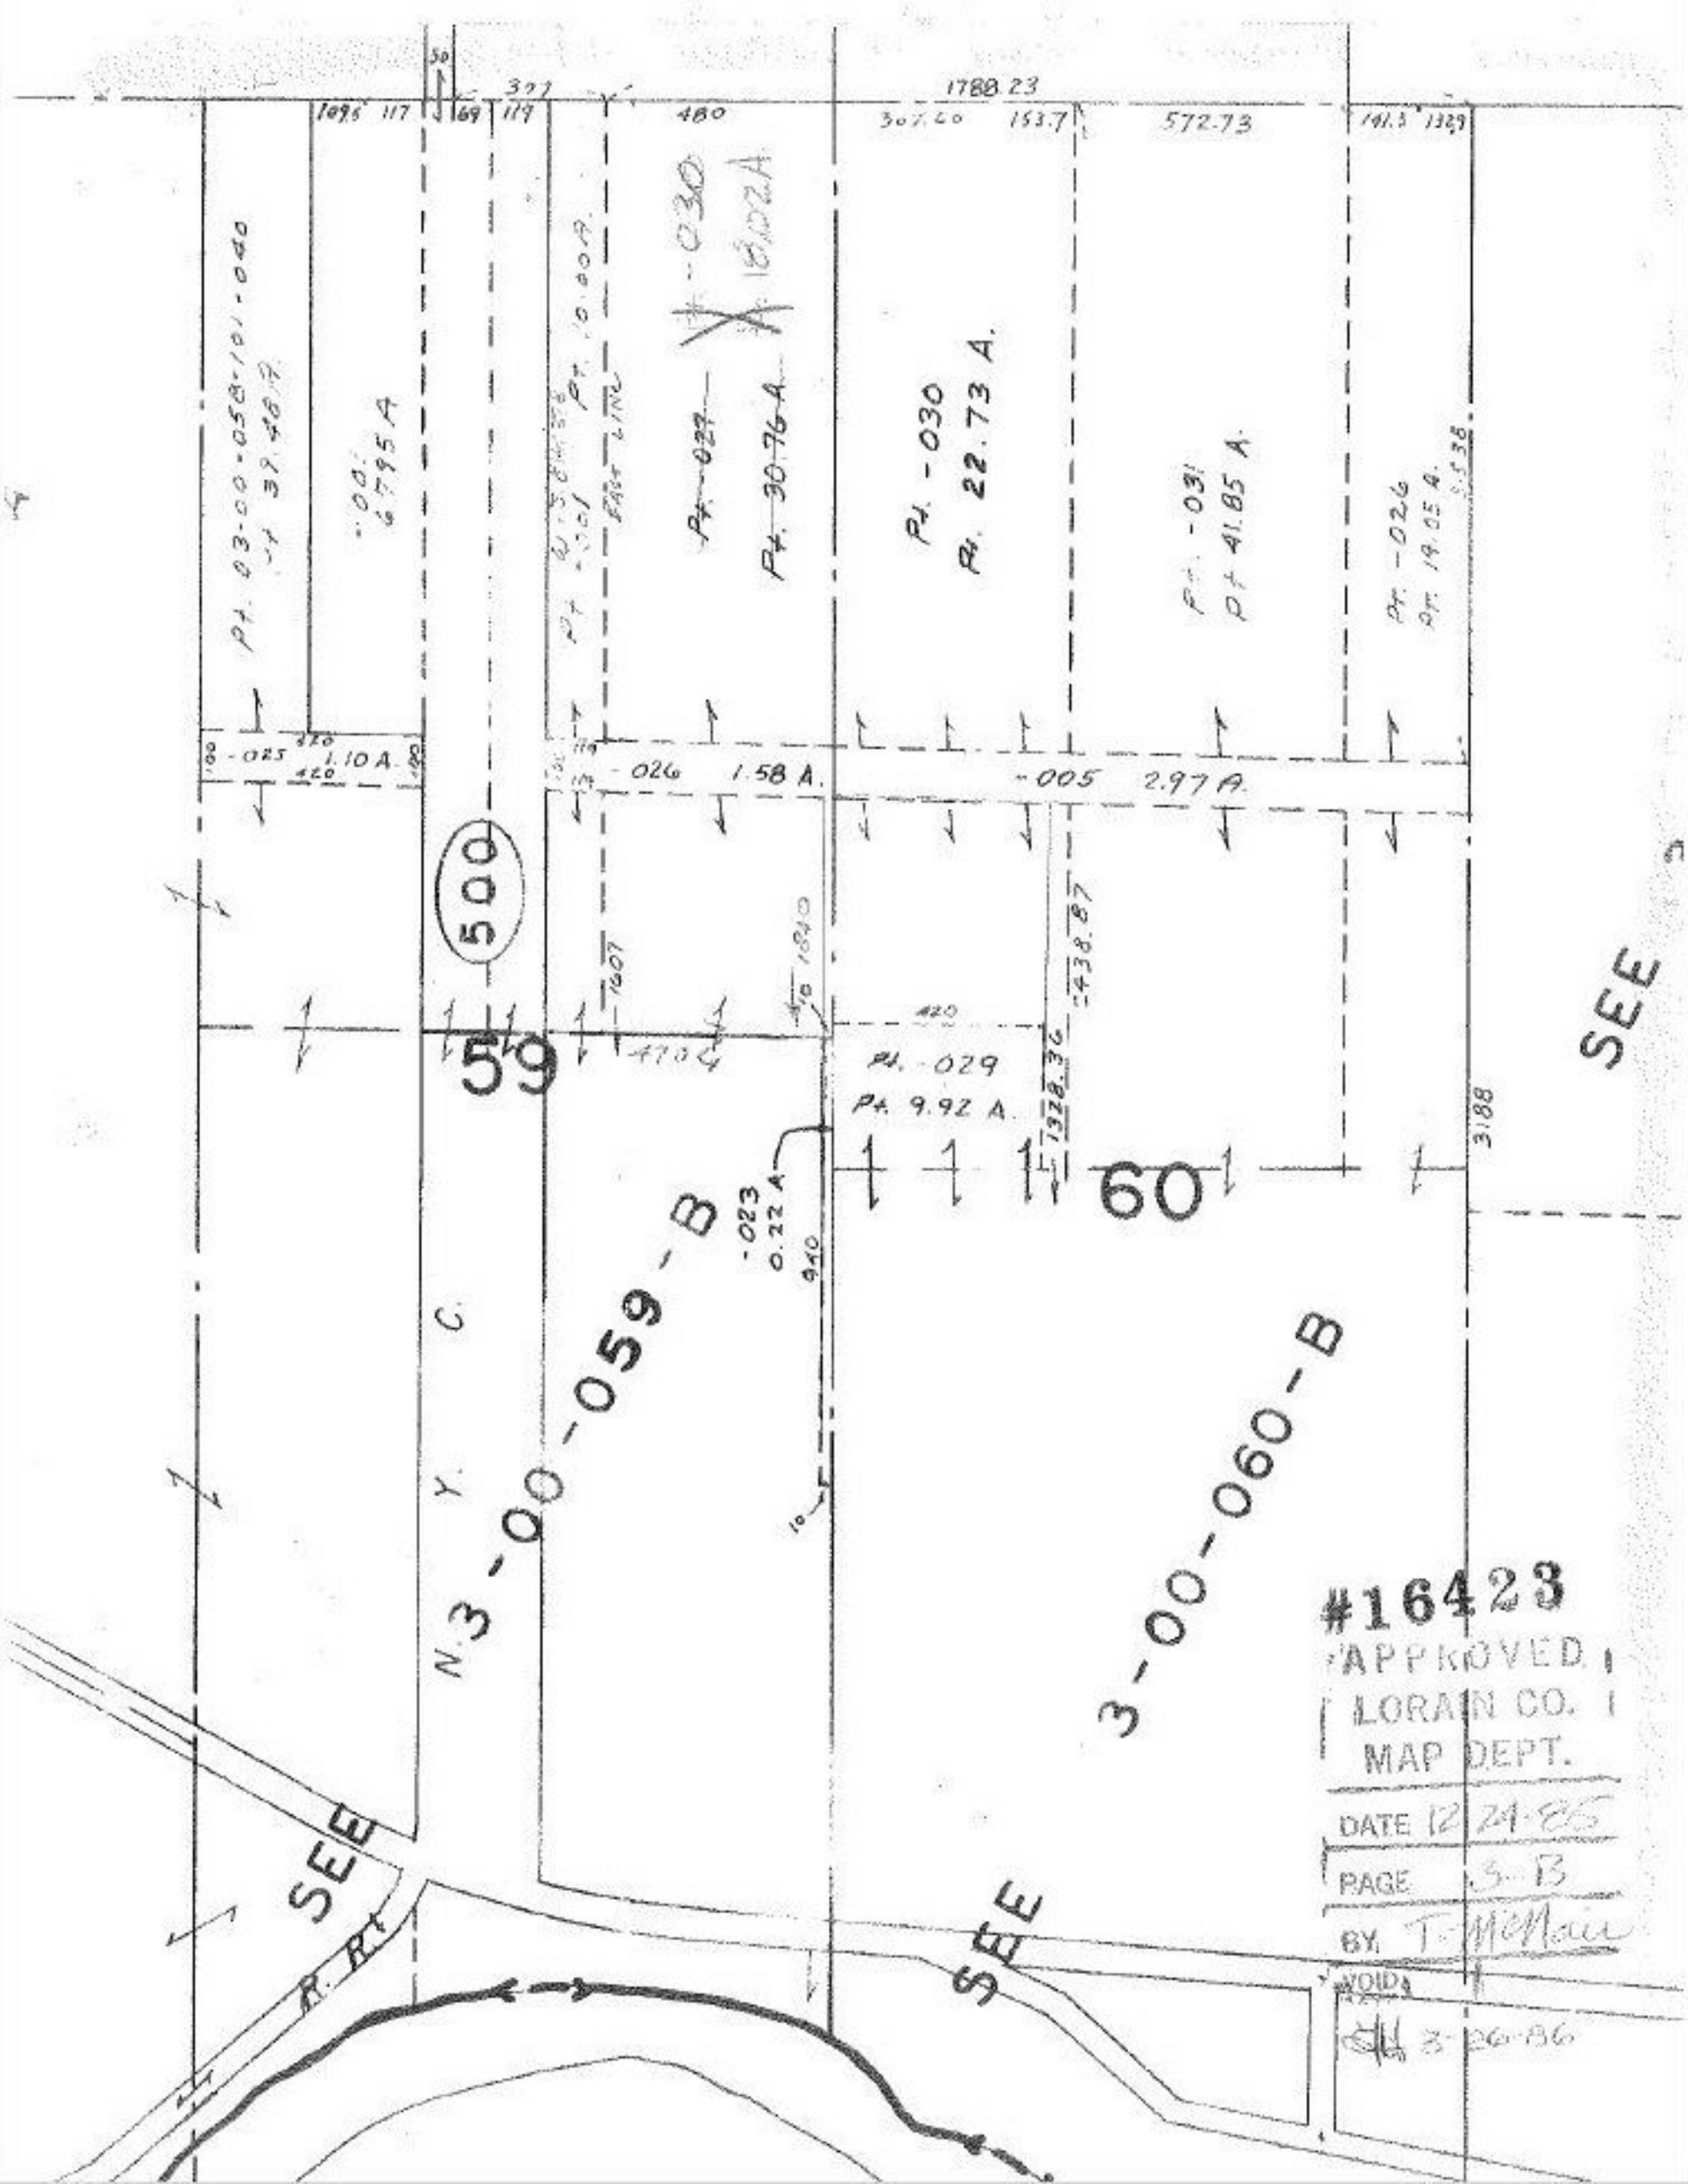
50
307
1788.23
1095
117
169
119
480
307.60
153.7
572.73
141.3
1329
Pt. 03-00-058-101-040
Pt. 39.48 A.
-040
6.795 A.
-030
16.02 A.
Pt. -027
Pt. 30.76 A.
Pt. -030
Pt. 22.73 A.
Pt. -031
Pt. 41.85 A.
Pt. -026
Pym. 19.15 A.
S.S. 38
100
-025
1.10 A.
420
420
180
119
-026
1.58 A.
-005
2.97 A.
500
59
1607
470
420
1328.36
438.87
Pt. -029
Pt. 9.92 A.
60
3188
-023
0.22 A.
940
10
N. 3-00-059-B
C. Y.
3-00-060-B
SEE
R. R.
SEE
SEE
#16423
APPROVED
LORAIN CO.
MAP DEPT.
DATE 12-24-86
PAGE 3-B
BY T. McNair
VOID
3-26-86