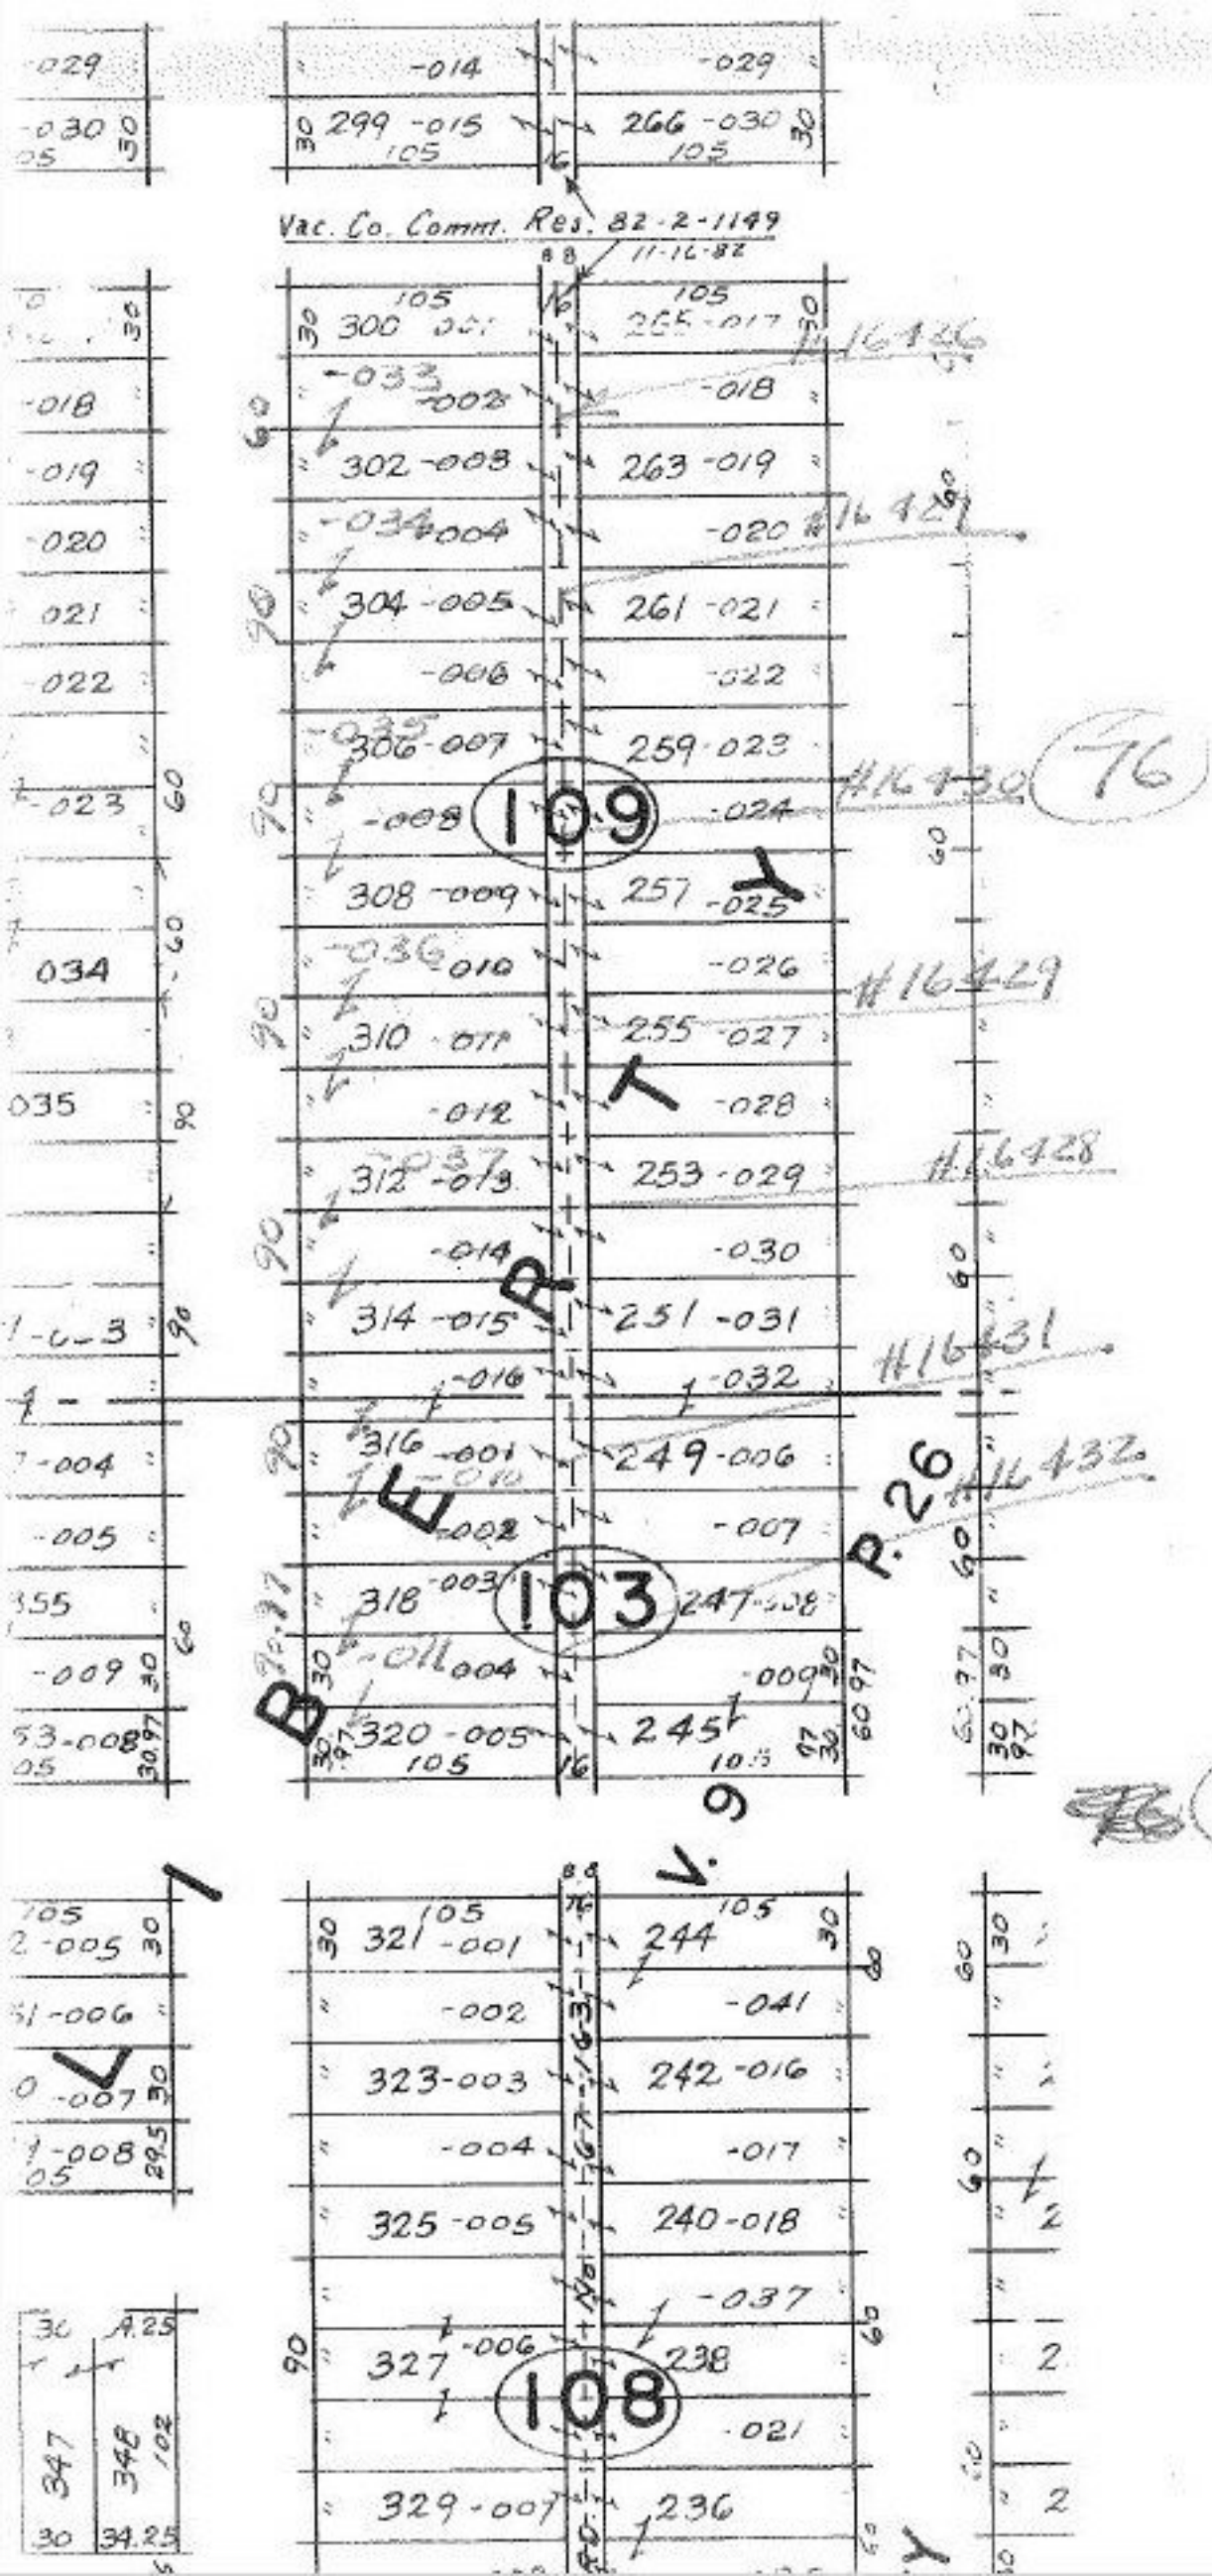

#16426
#16427
#16428
#16430
#16429
#16431
#16432

APPROVED
LORAIN CO.
MAP DEPT.
DATE 10-25-85
PAGES-00 075A
BY
VOID AFTER

3-26-86