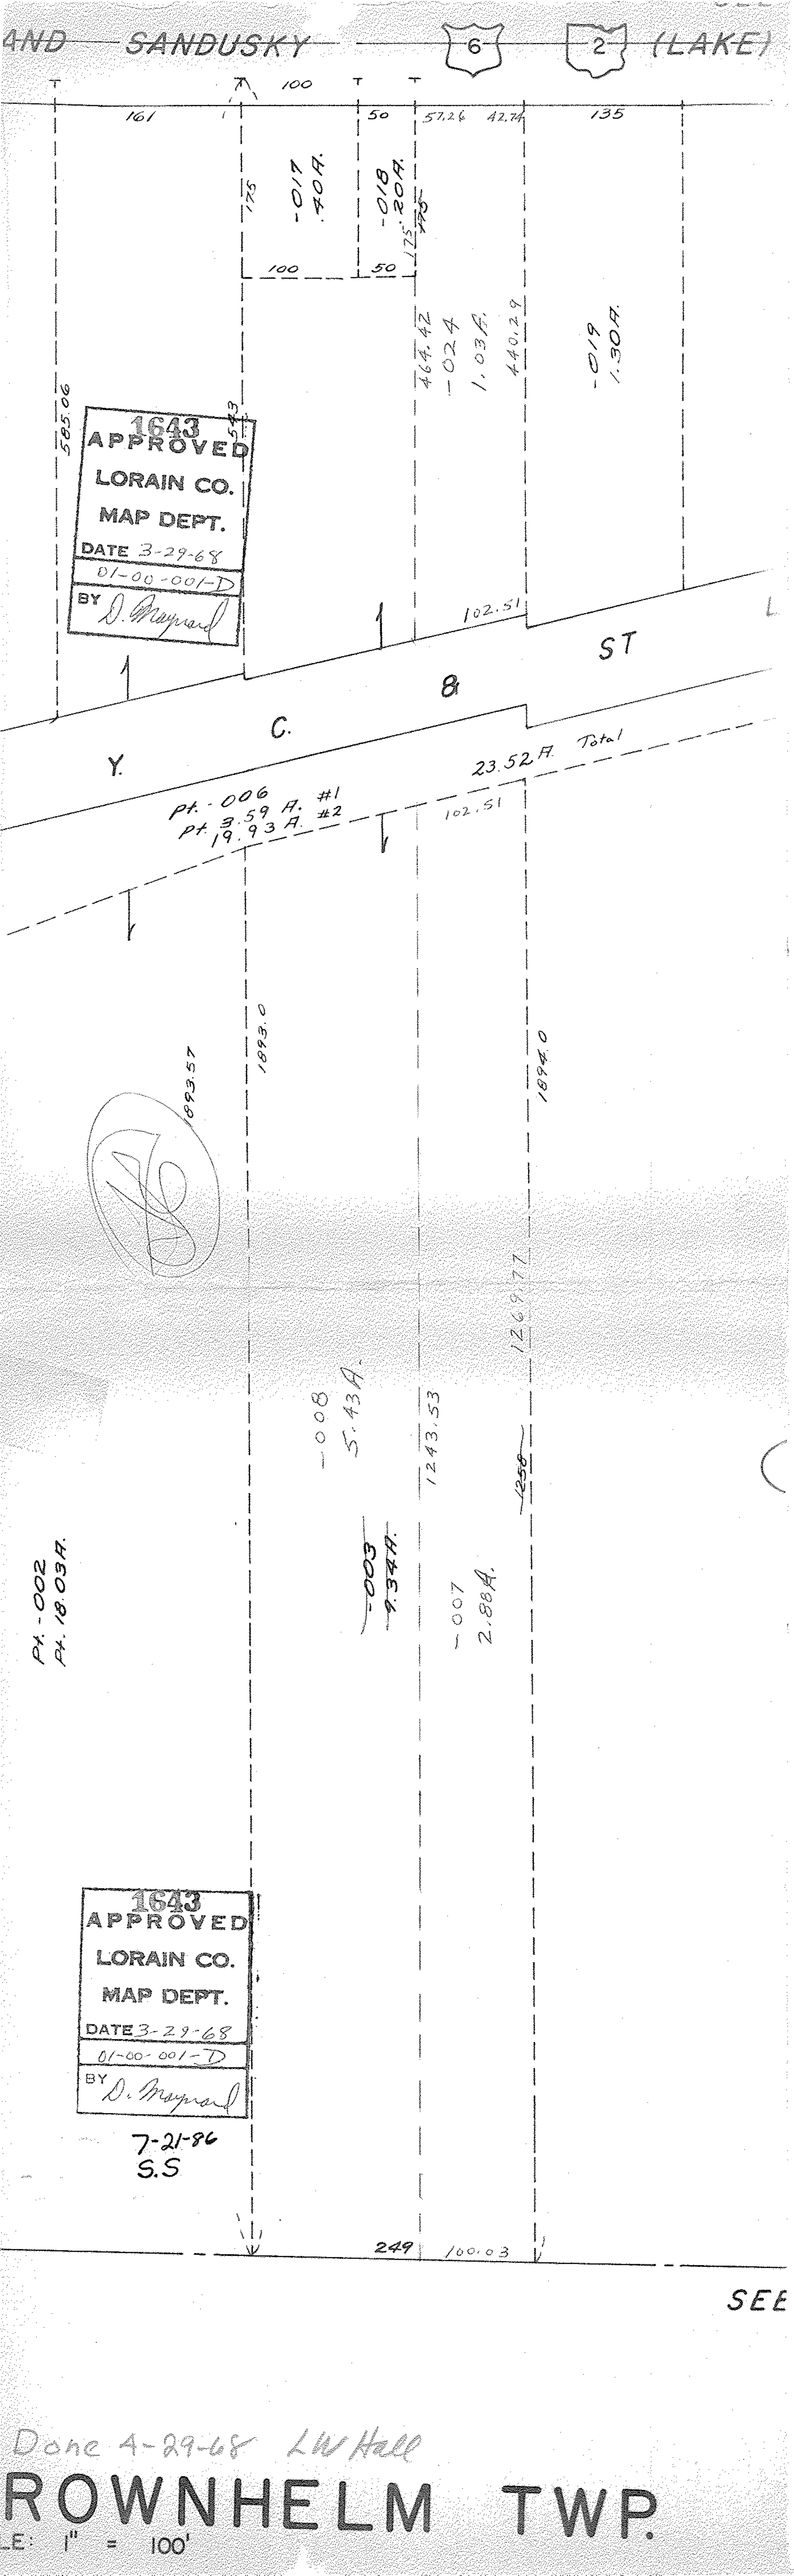


Done 4-29-68 LW Hall

# ROWNHELM TWP.

LE: 1" = 100'