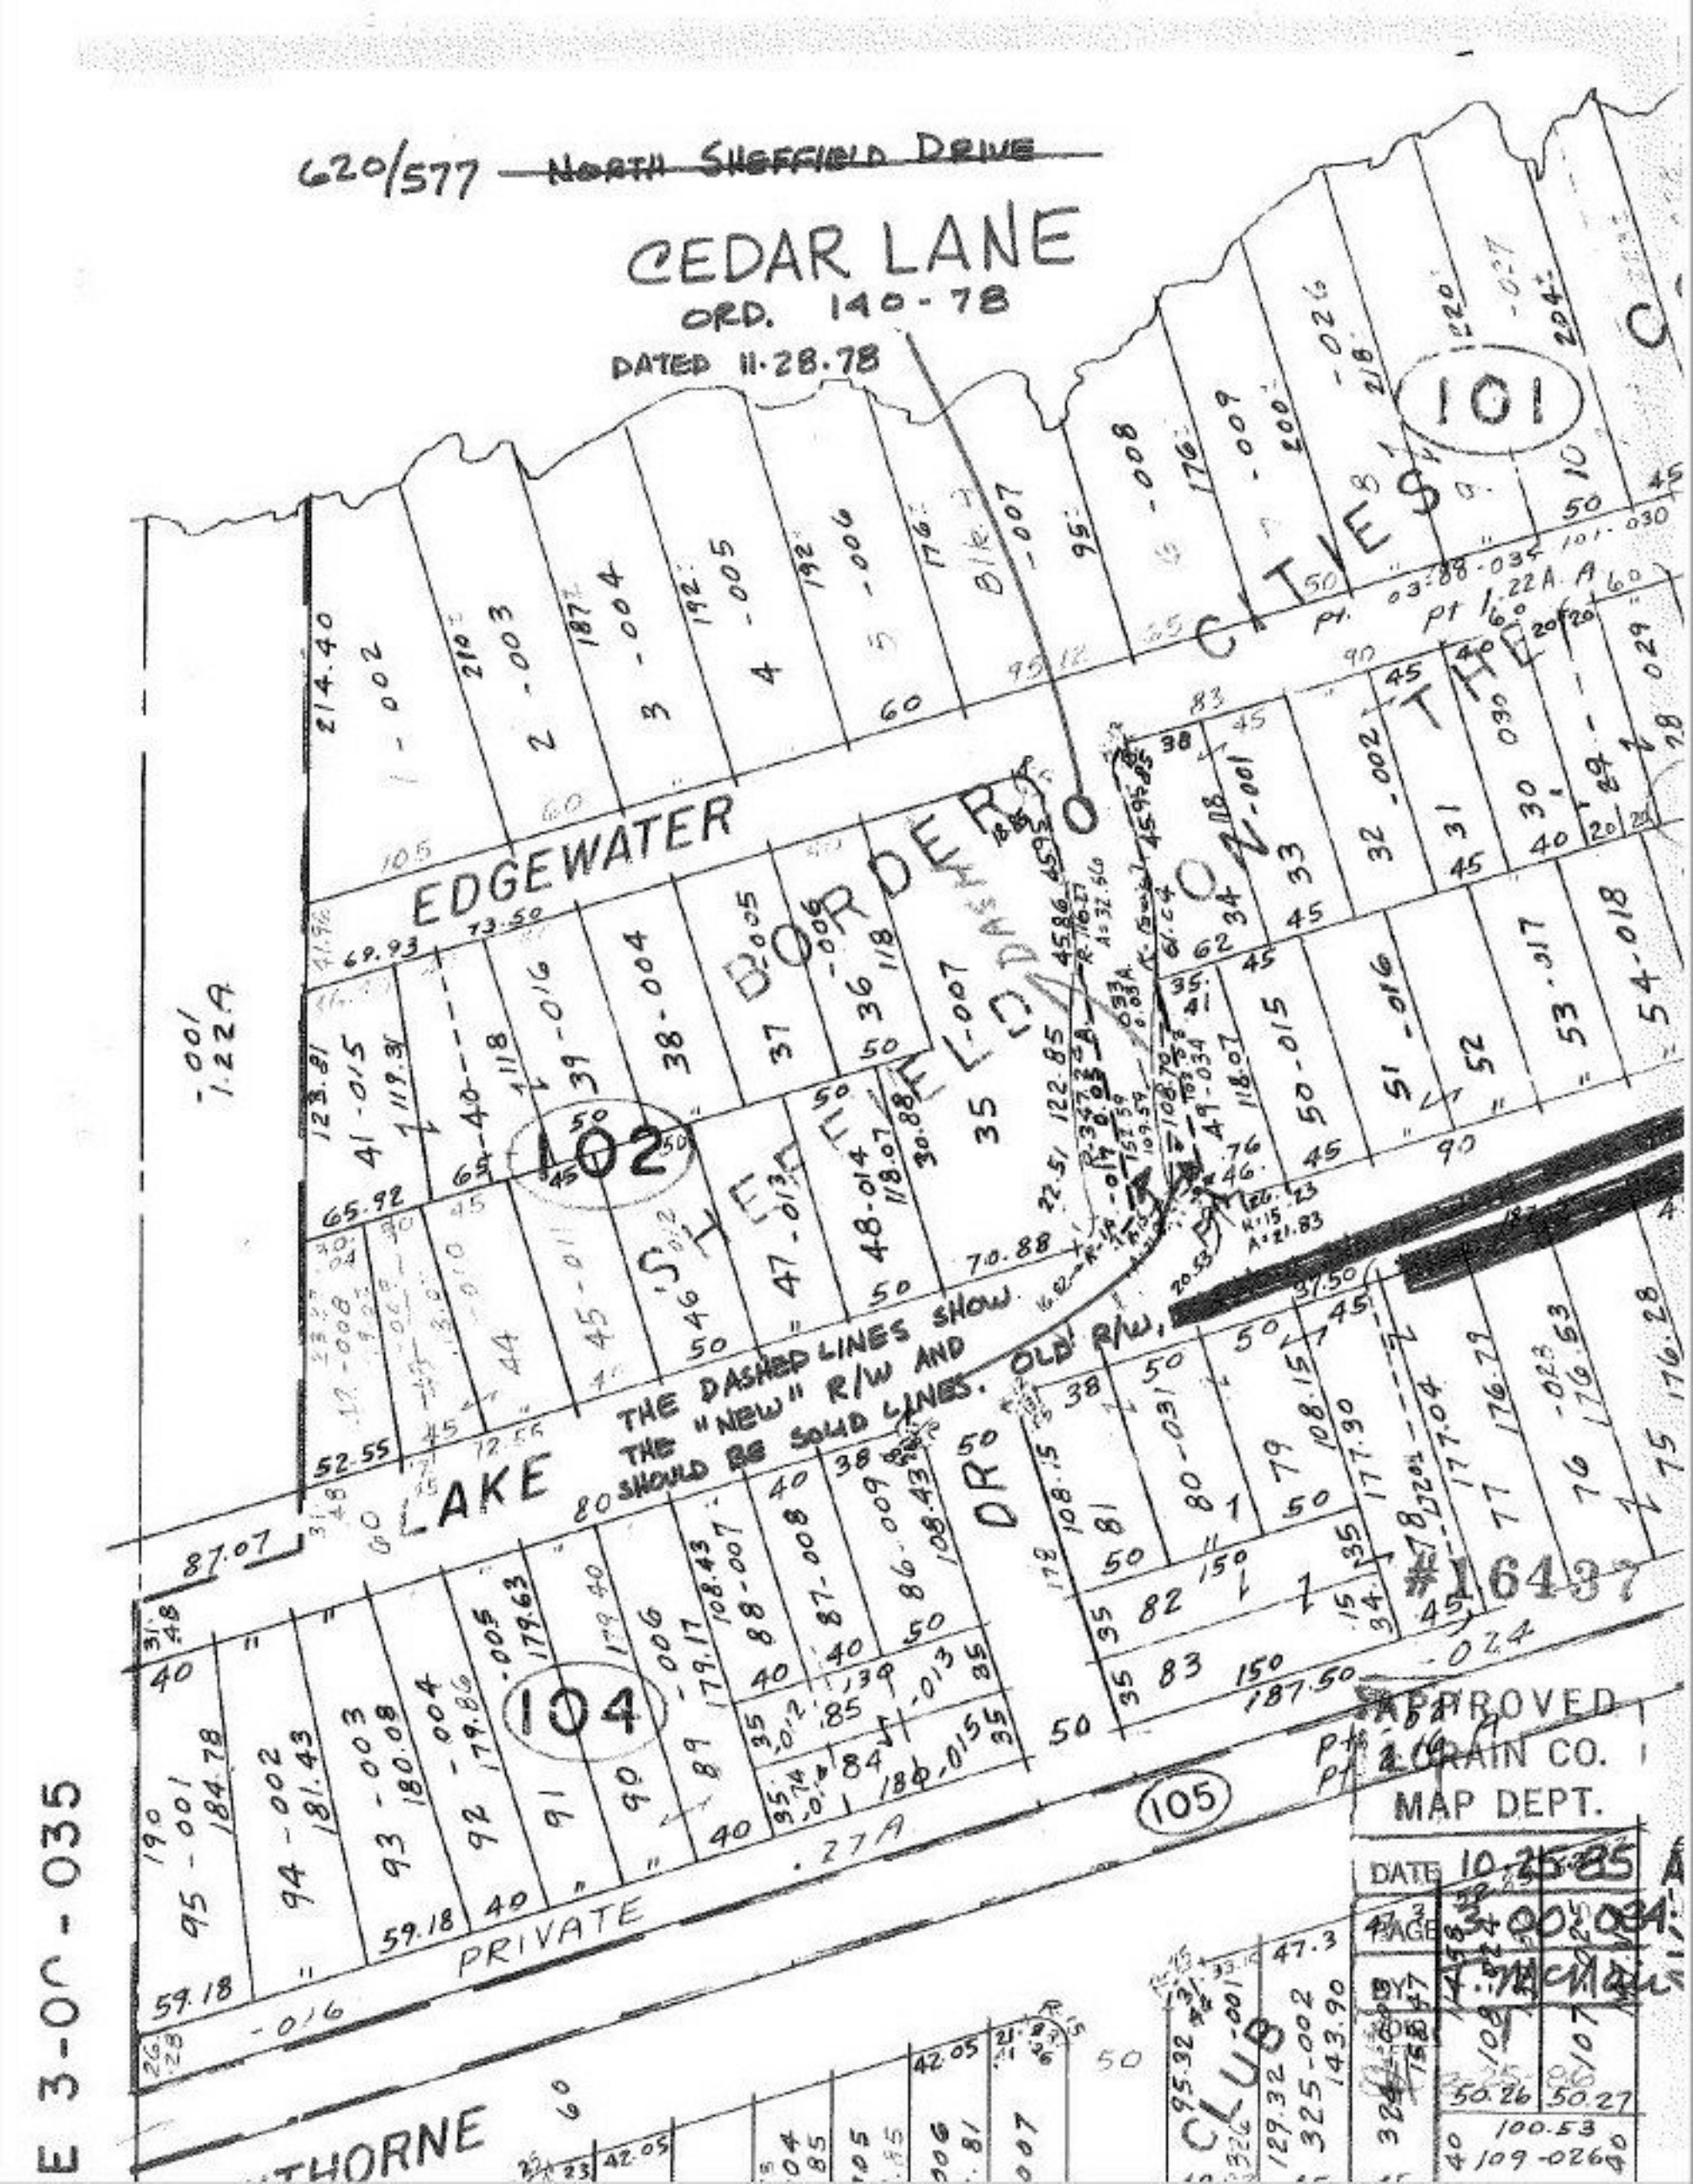
620/577 ~~NORTH SHEFFIELD DRIVE~~
CEDAR LANE
ORD. 140-78
DATED 11.28.78
EDGEWATER
BORDER
CITIES
THE
LAKE
DR
THORNE
CLUB
PRIVATE
THE DASHED LINES SHOW THE "NEW" R/W AND SHOULD BE SOLID LINES. OLD R/W,
101
102
104
105
#16437
APPROVED
LORAIN CO.
MAP DEPT.
DATE 10-25-85
PAGE 3-00-034
BY
E 3-00-035