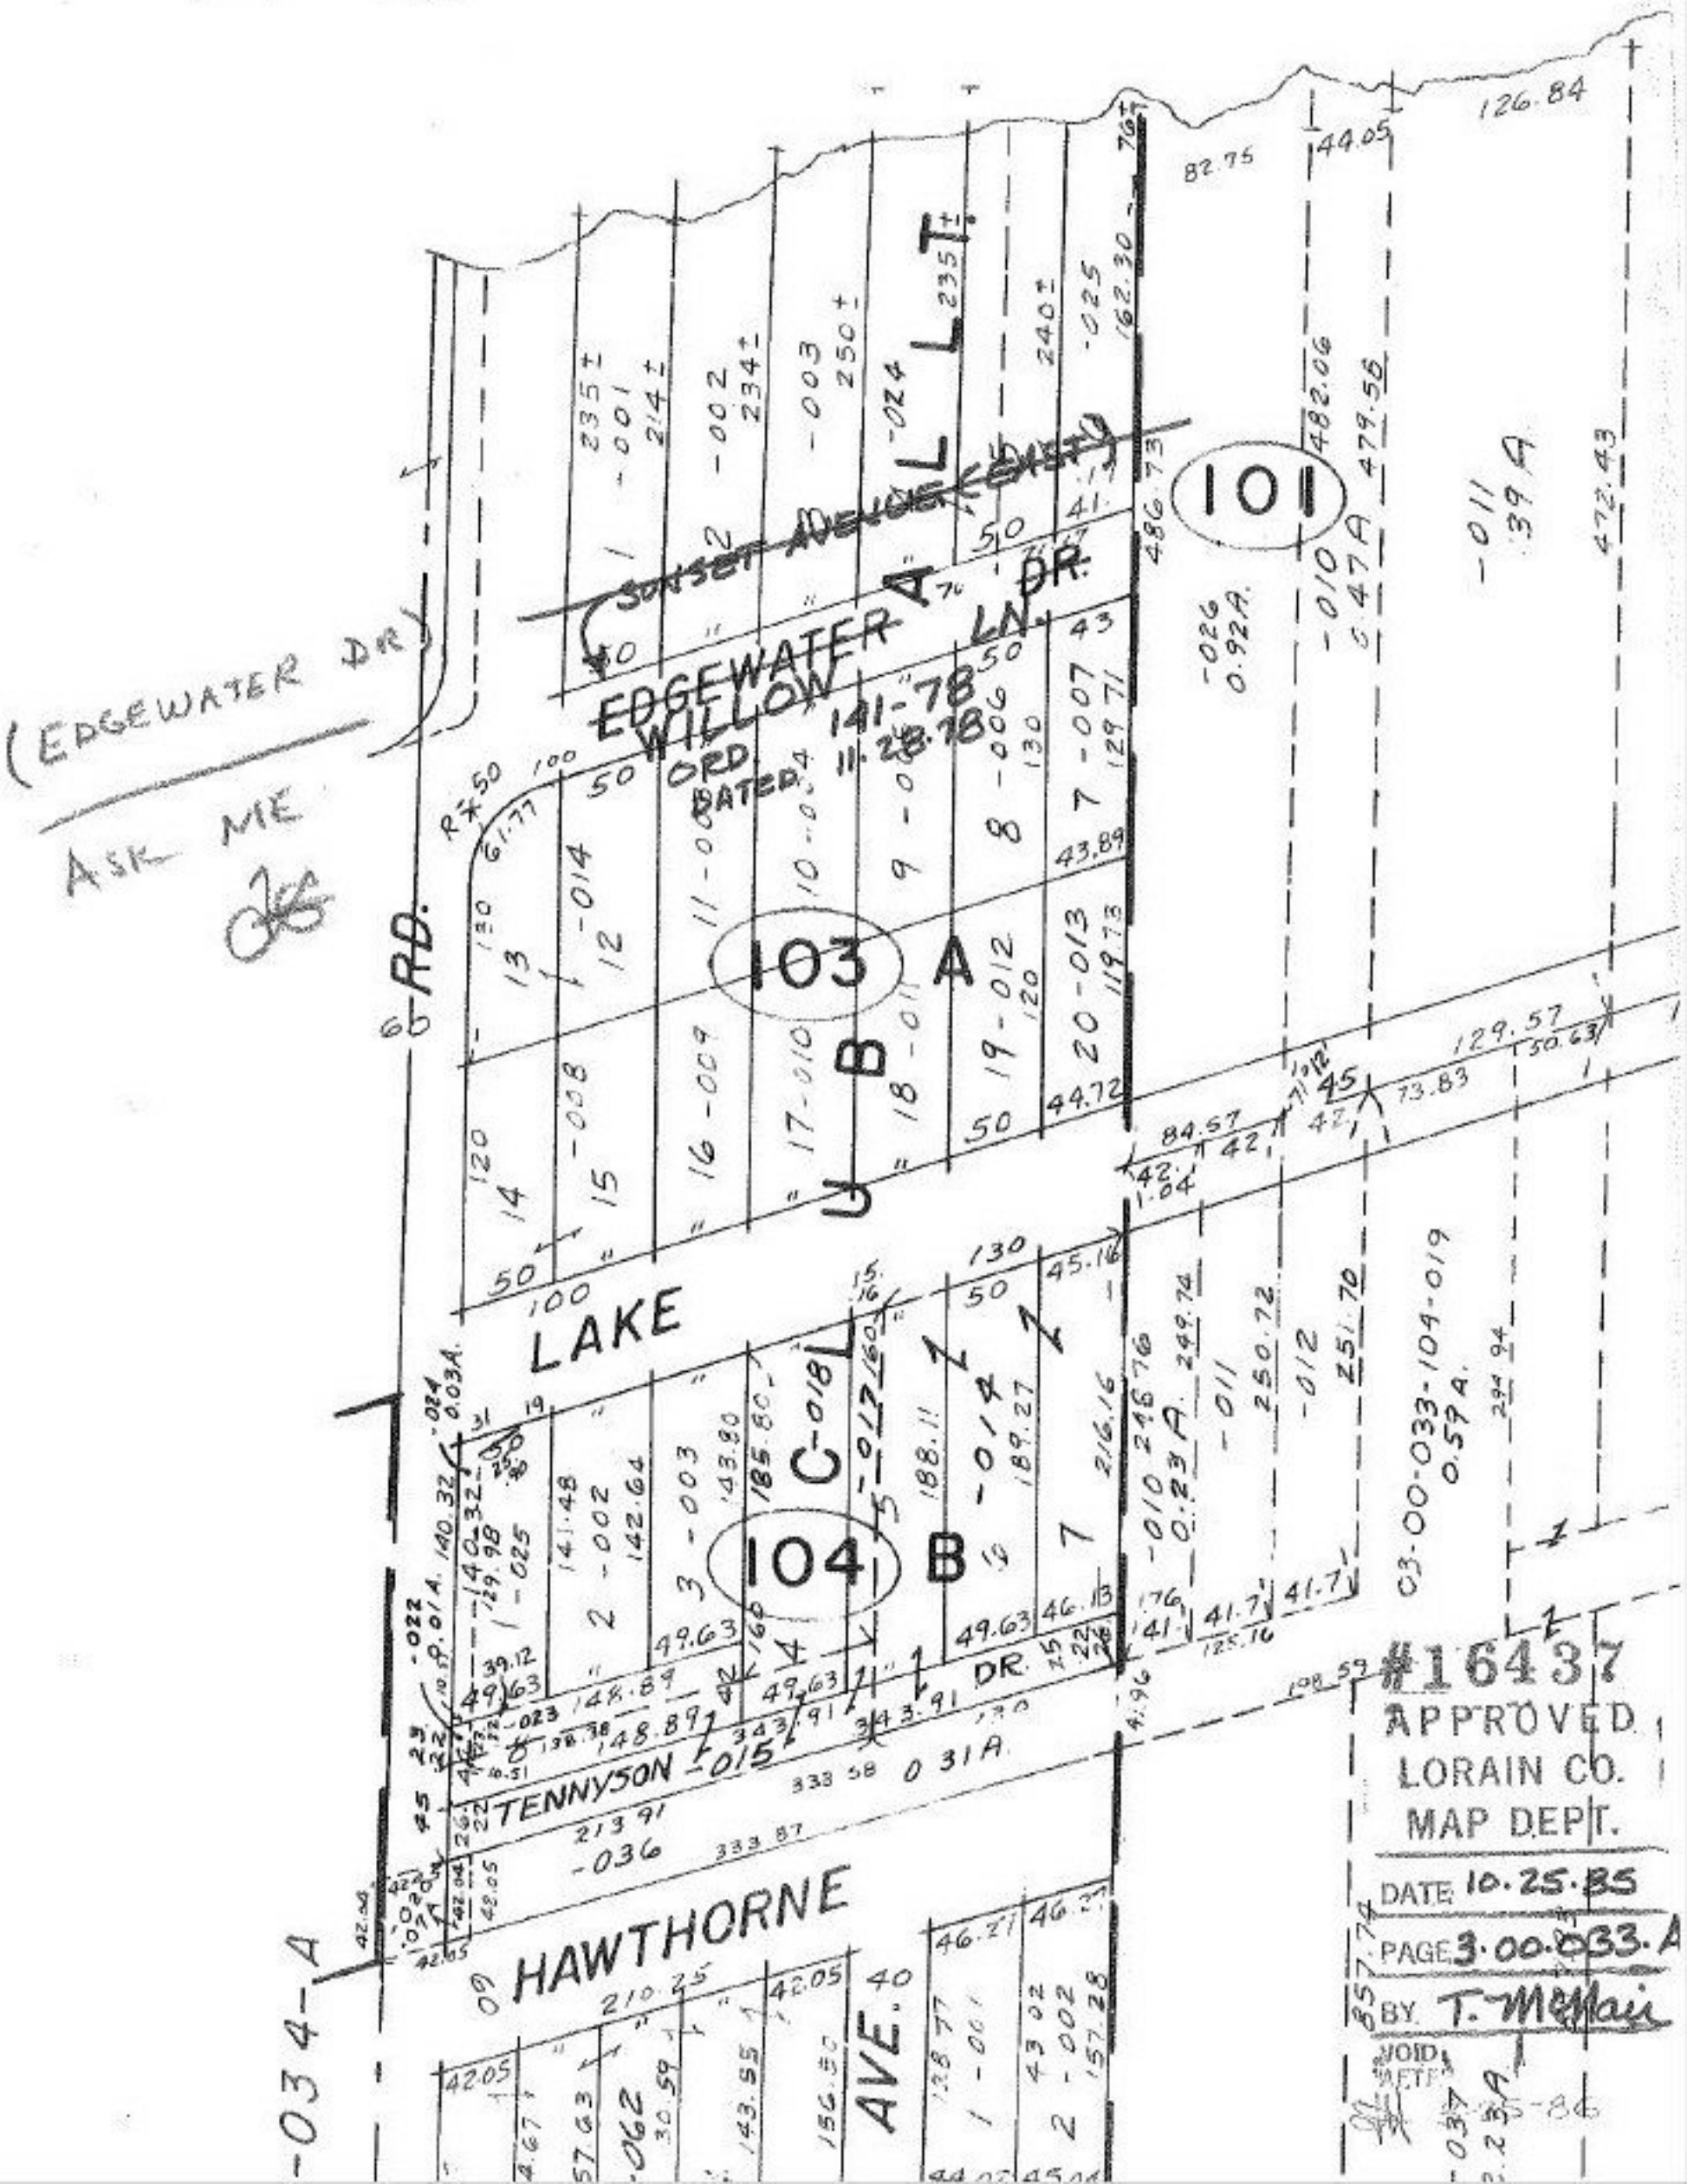

(EDGEWATER DR)
ASK ME
SUNSET AVENUE (EAST)
EDGEWATER LN.
WILLOW DR.
ORD. 141-78
DATED 11.28.78
101
103 A
104 B
LAKE
HAWTHORNE
AVE.
TENNYSON DR.
RD.
#16437
APPROVED
LORAIN CO.
MAP DEPT.
DATE 10.25.85
PAGE 3.00.033.A
BY T. McNair
VOID AFTER