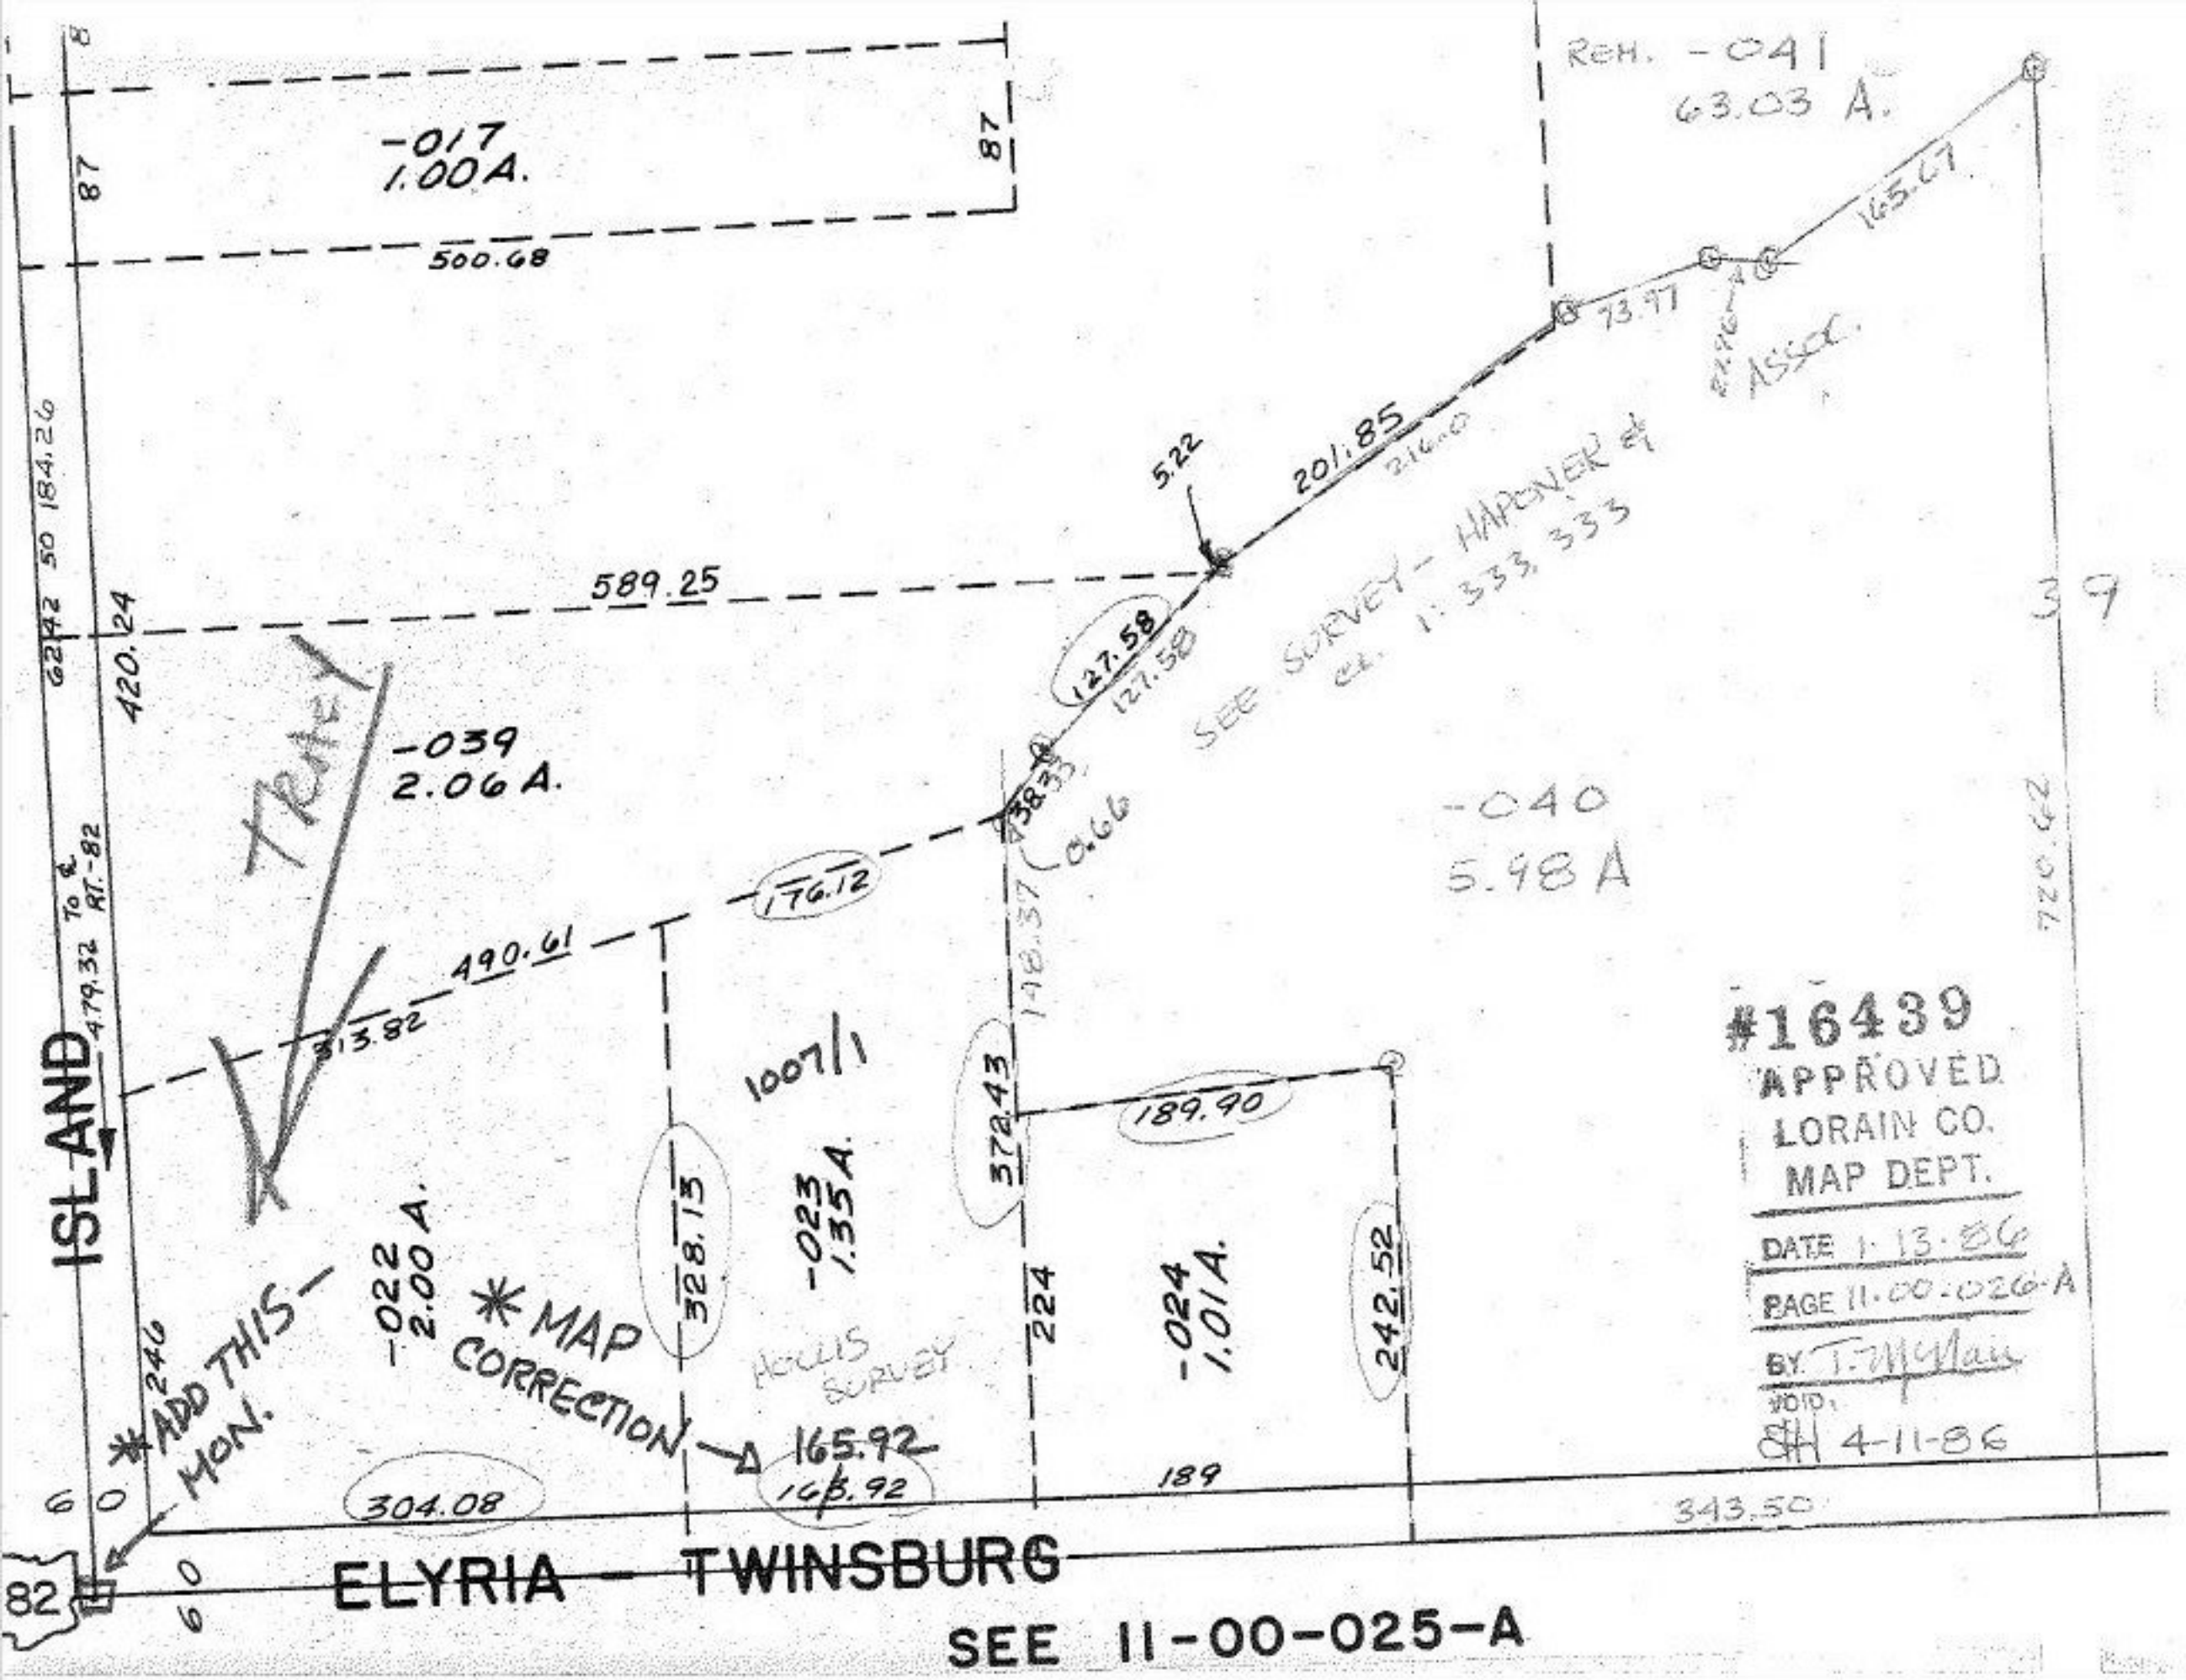

REM. -041
63.03 A.
-017
1.00 A.
500.68
87
87
165.67
73.97
ASSOC.
201.85
216.0
5.22
589.25
127.58
127.58
SEE SURVEY - HAPONER &
CL. 1:333,333
39
62.42 50 184.26
420.24
TRAFT
-039
2.06 A.
-040
5.98 A
720.62
176.12
490.61
313.82
479.32 To & RT.-82
ISLAND
1007/1
372.43
189.90
328.13
-023
1.35 A.
-022
2.00 A.
*MAP
CORRECTION
HOLLIS
SURVEY
224
-024
1.01 A.
242.52
*ADD THIS
MON.
246
165.92
163.92
304.08
189
343.50
60
60
82
ELYRIA - TWINSBURG
SEE 11-00-025-A
#16439
APPROVED
LORAIN CO.
MAP DEPT.
DATE 1-13-86
PAGE 11-00-026-A
BY T. McNair
VOID.
4-11-86