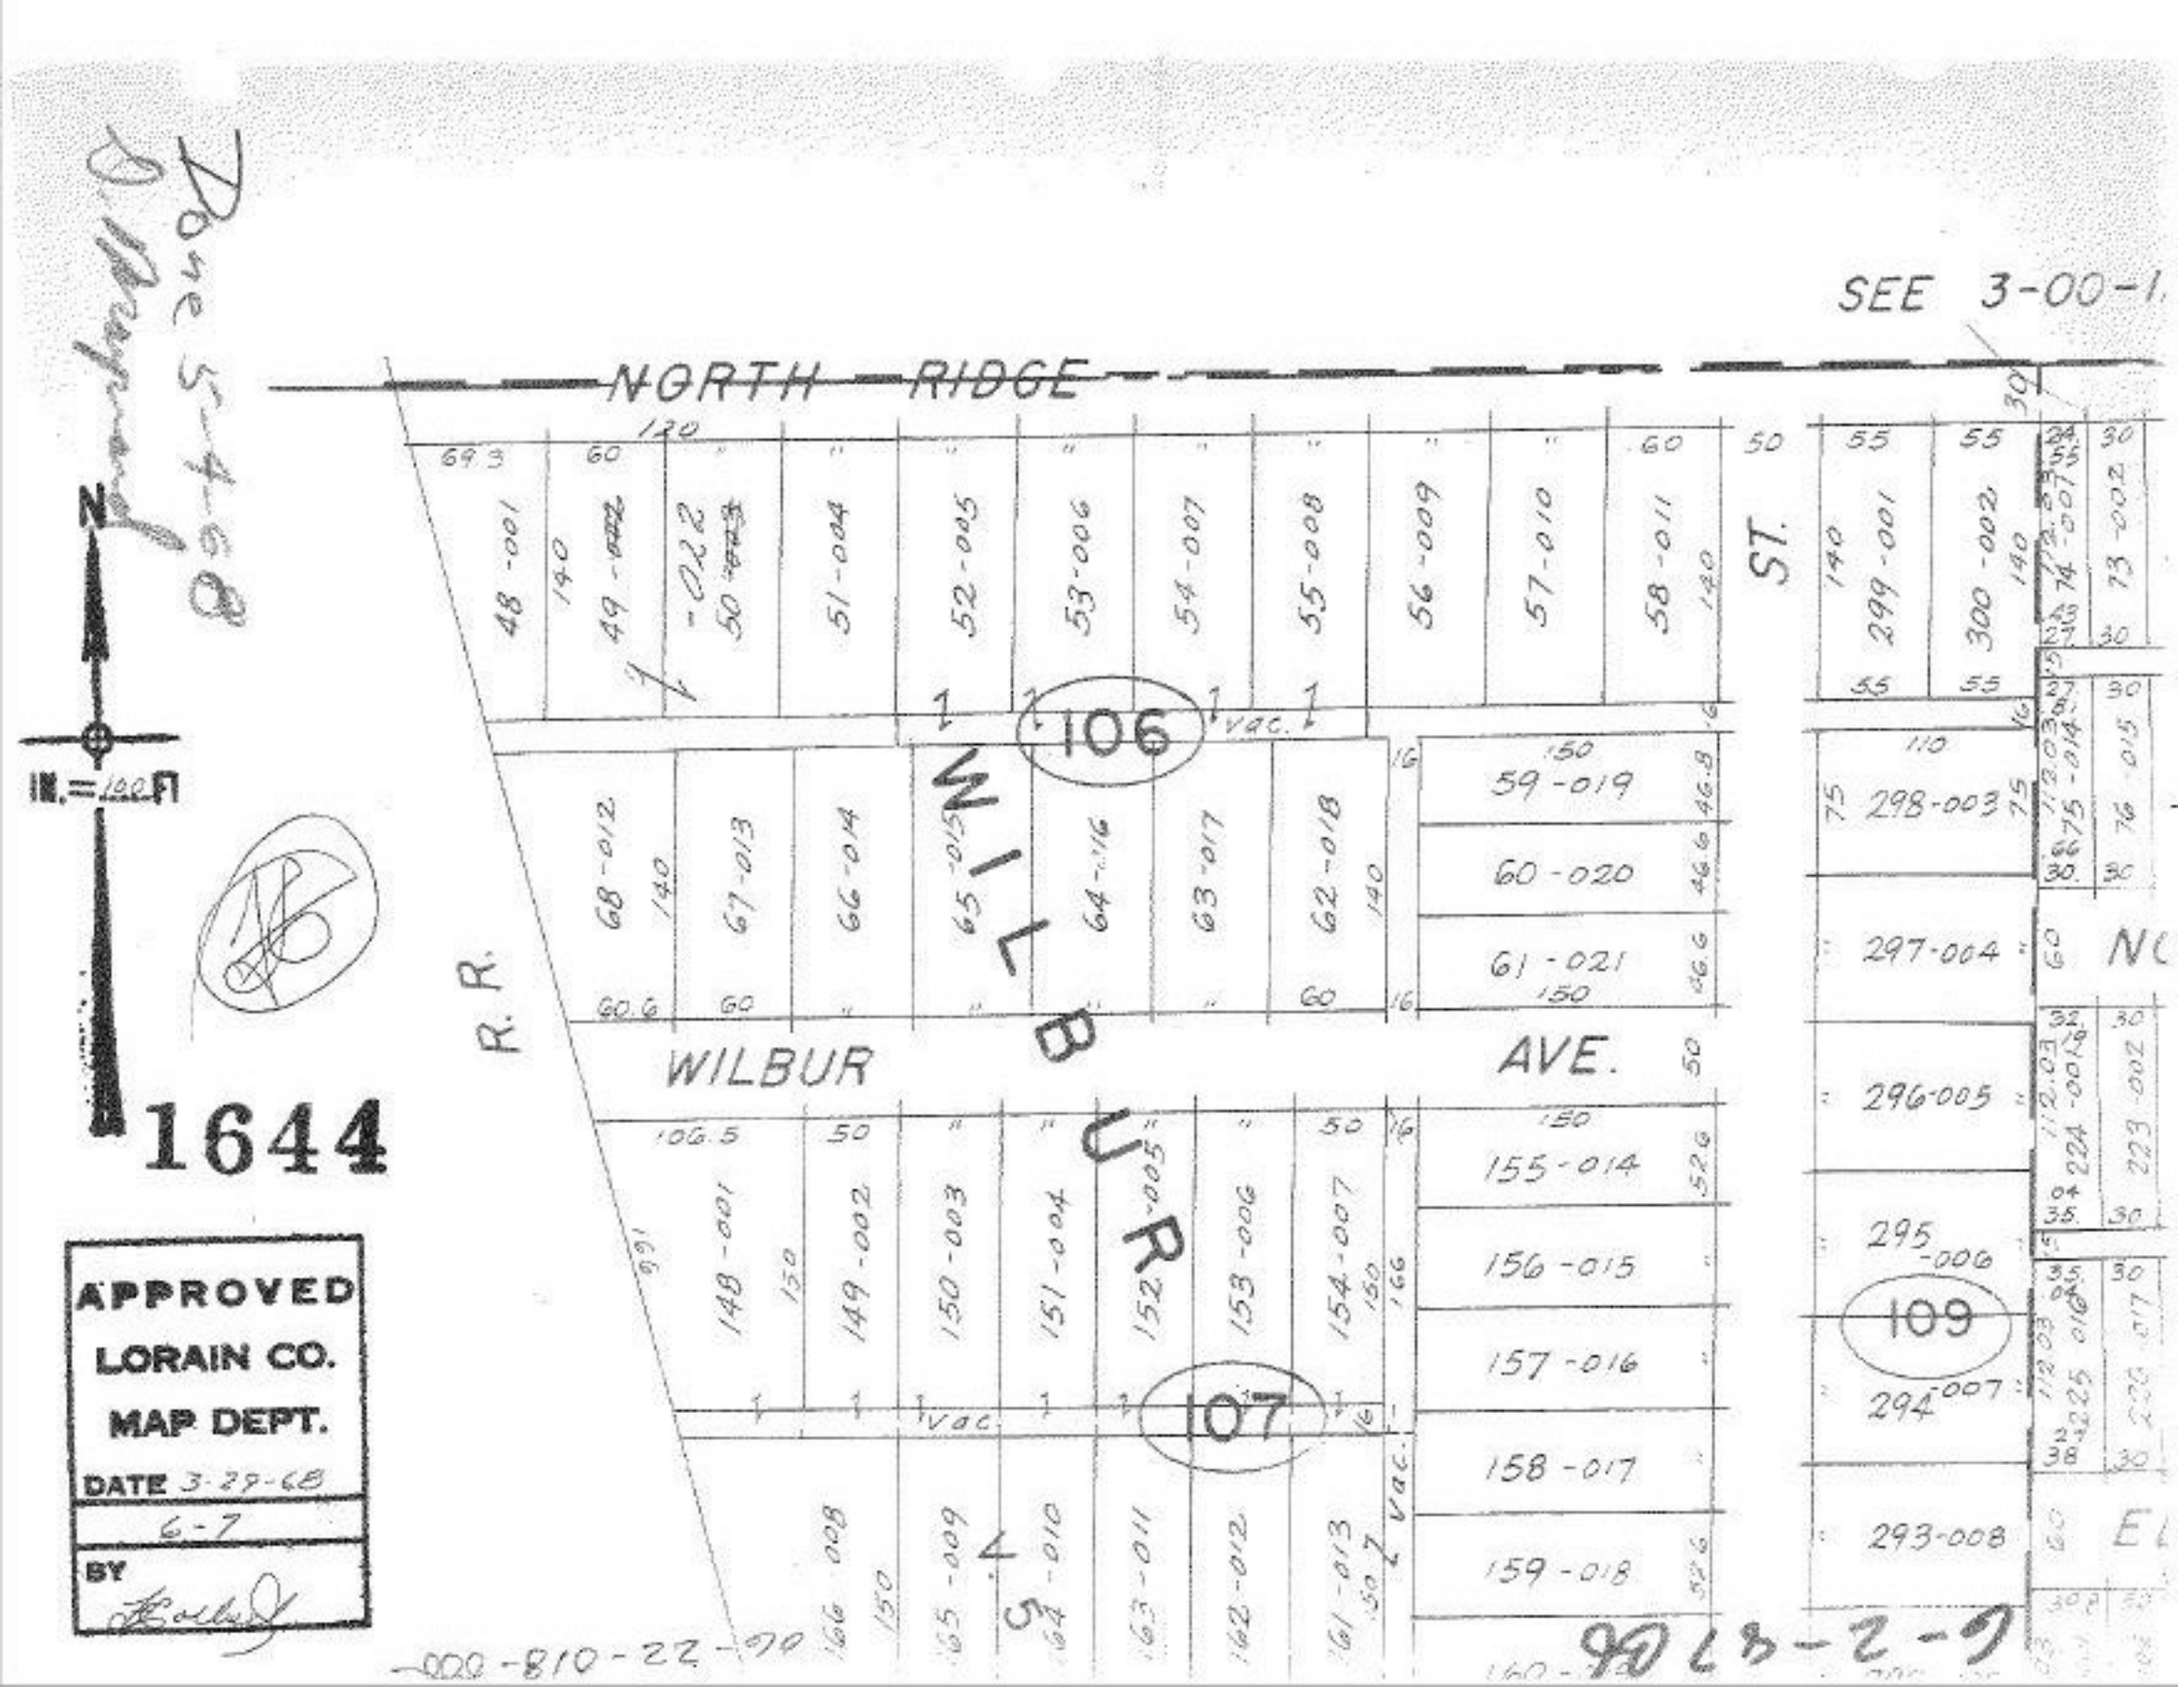
SEE 3-00-1
NORTH RIDGE
ST.
WILBUR
AVE.
R. R.
106
107
109
1" = 100 FT
N
1644
APPROVED
LORAIN CO.
MAP DEPT.
DATE 3-29-68
6-7
BY
48-001
49-002
-022
50
51-004
52-005
53-006
54-007
55-008
56-009
57-010
58-011
59-019
60-020
61-021
68-012
67-013
66-014
65-015
64-016
63-017
62-018
148-001
149-002
150-003
151-004
152-005
153-006
154-007
155-014
156-015
157-016
158-017
159-018
166-008
165-009
164-010
163-011
162-012
161-013
298-003
297-004
296-005
295-006
294-007
293-008
299-001
300-002
224-001
225-002
-000-810-22-00
90 18-2-9