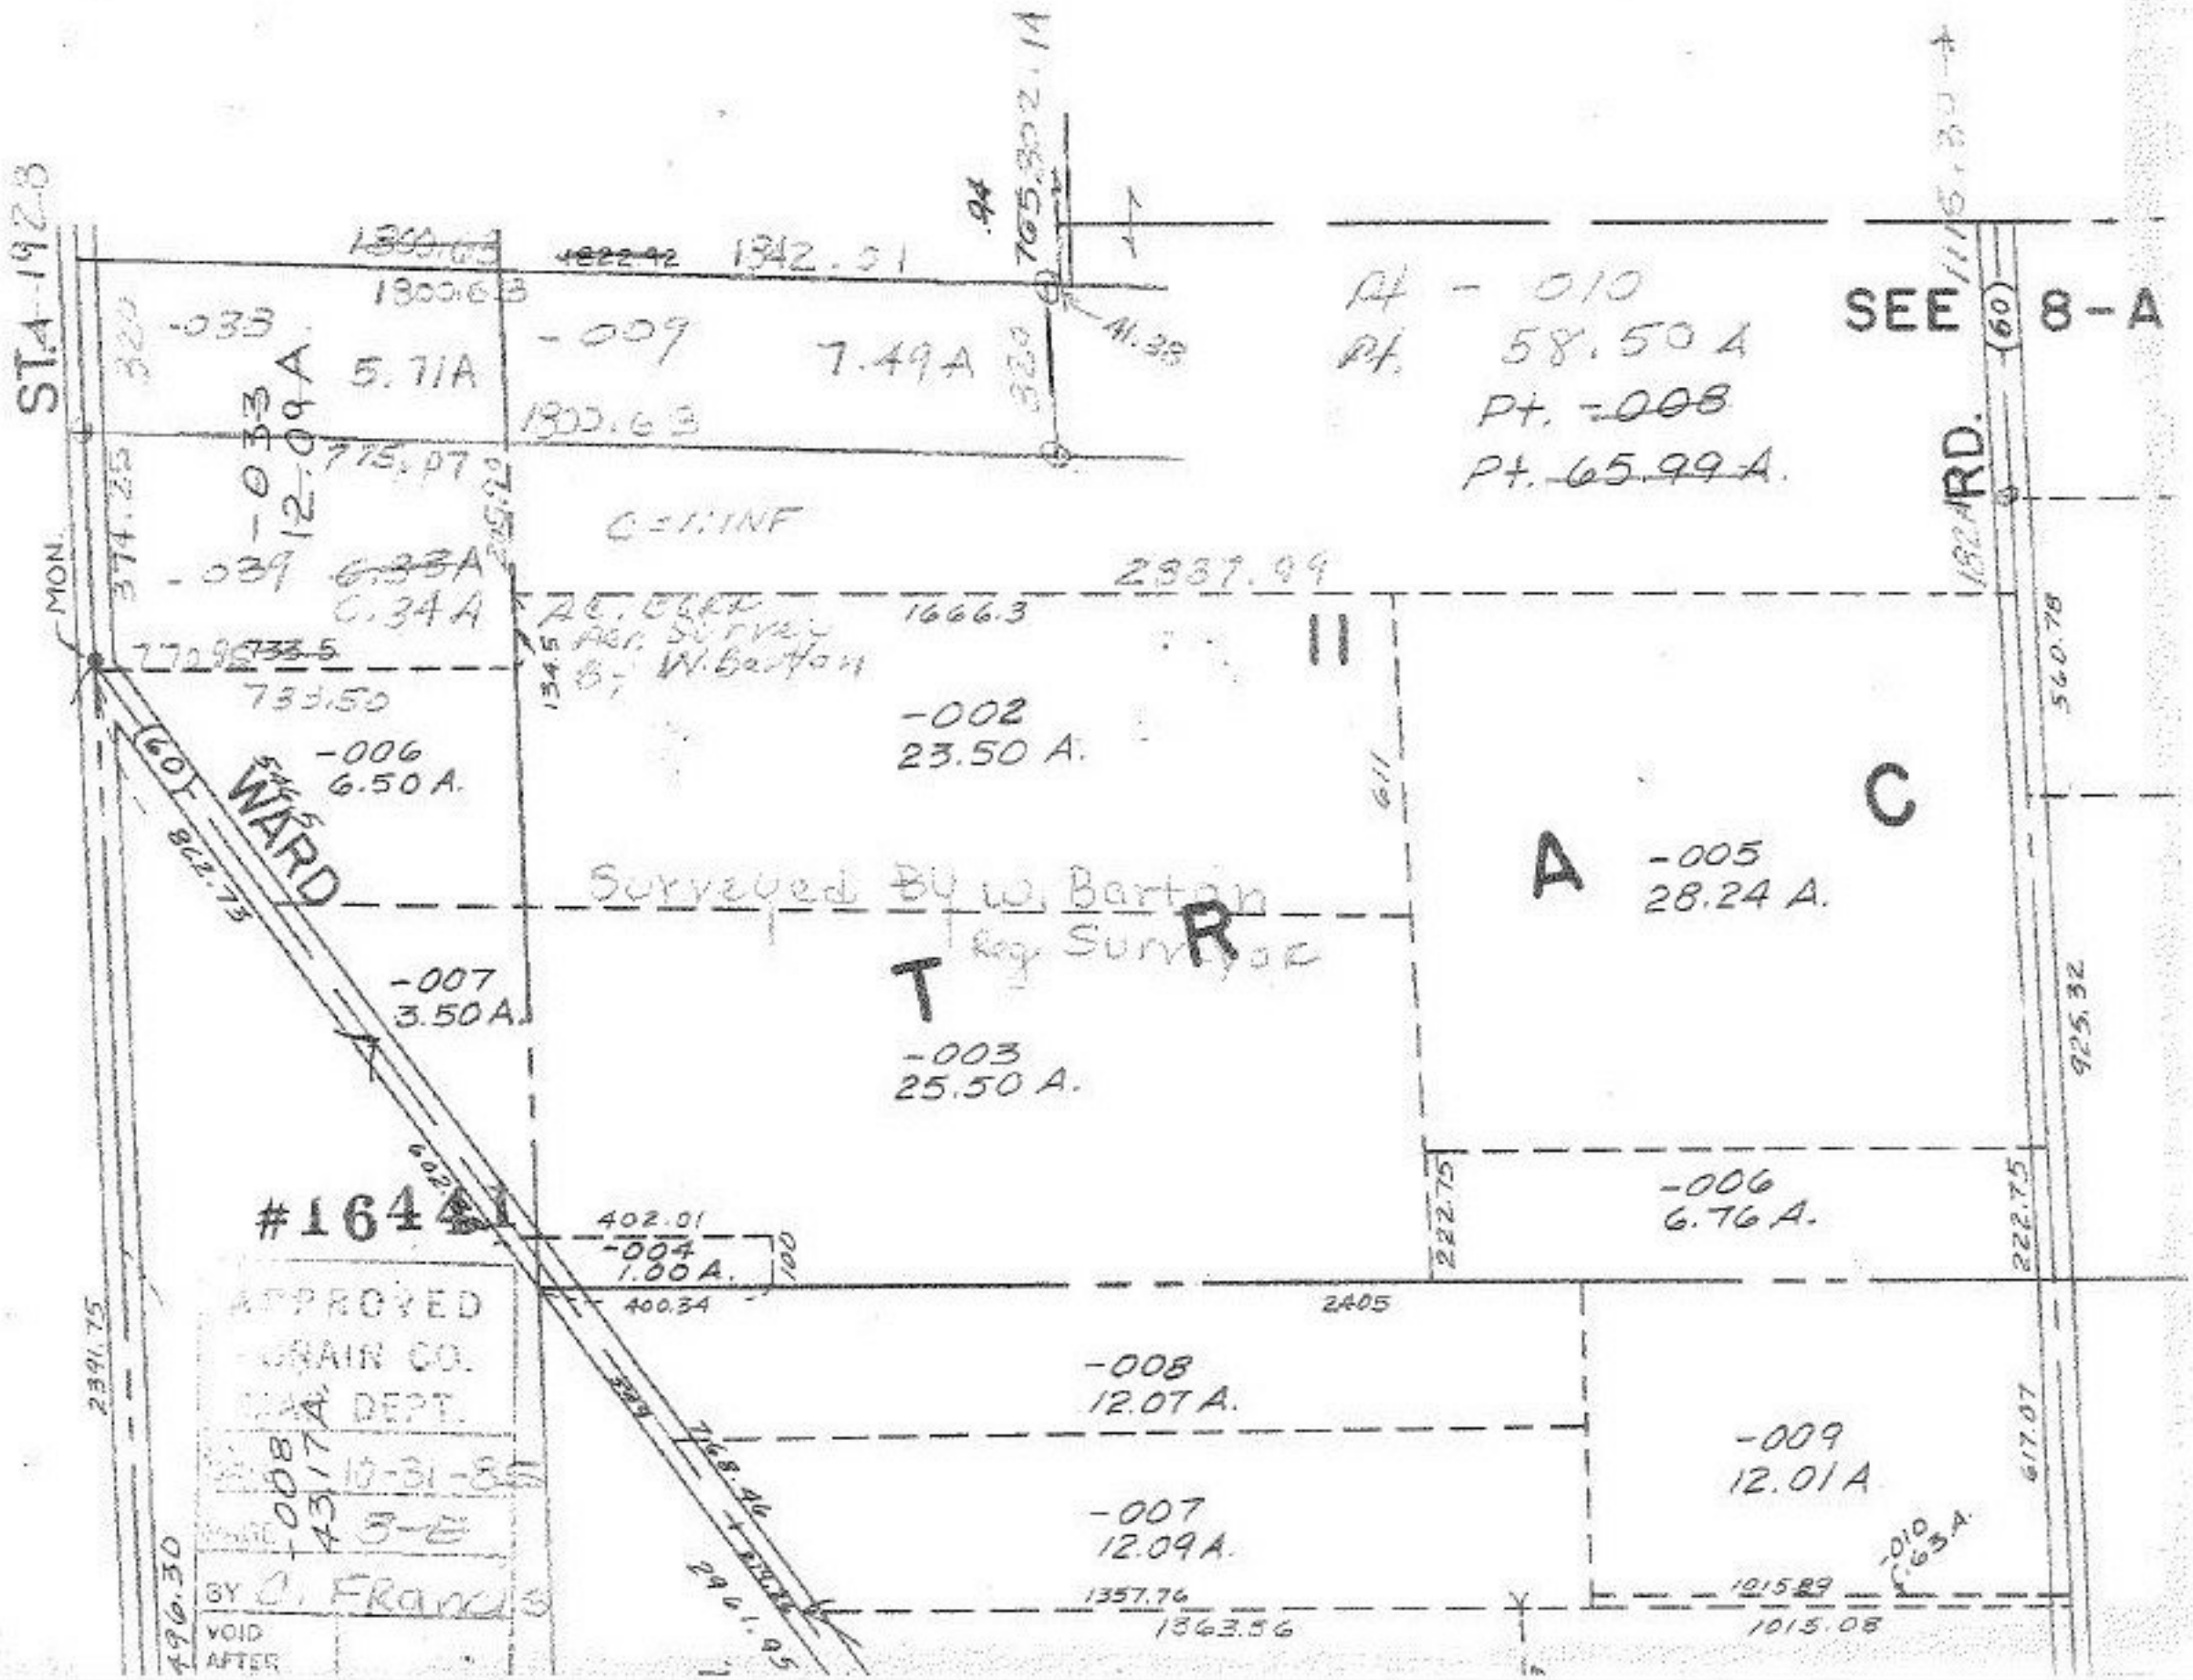

ST. 4-1928
SEE 8-A
RD.
WARD
MON.
Pt - 010
Pt. 58.50 A
Pt. -008
Pt. 65.99 A.
-033
5.71A
-009
7.49A
-033
12.09A
-039
6.33A
6.34A
C=1:INF
2337.99
1666.3
-002
23.50 A.
-006
6.50 A.
-005
28.24 A.
Surveyed By W. Barton
Reg. Surveyor
-007
3.50 A.
-003
25.50 A.
-006
6.76 A.
#16441
402.01
-004
1.00 A.
400.34
2405
-008
12.07 A.
-009
12.01 A
-007
12.09 A.
-010
.63 A.
1357.76
1363.56
1015.89
1015.08
APPROVED
DEPT.
10-31-85
3-E
BY C. Francis
VOID
AFTER