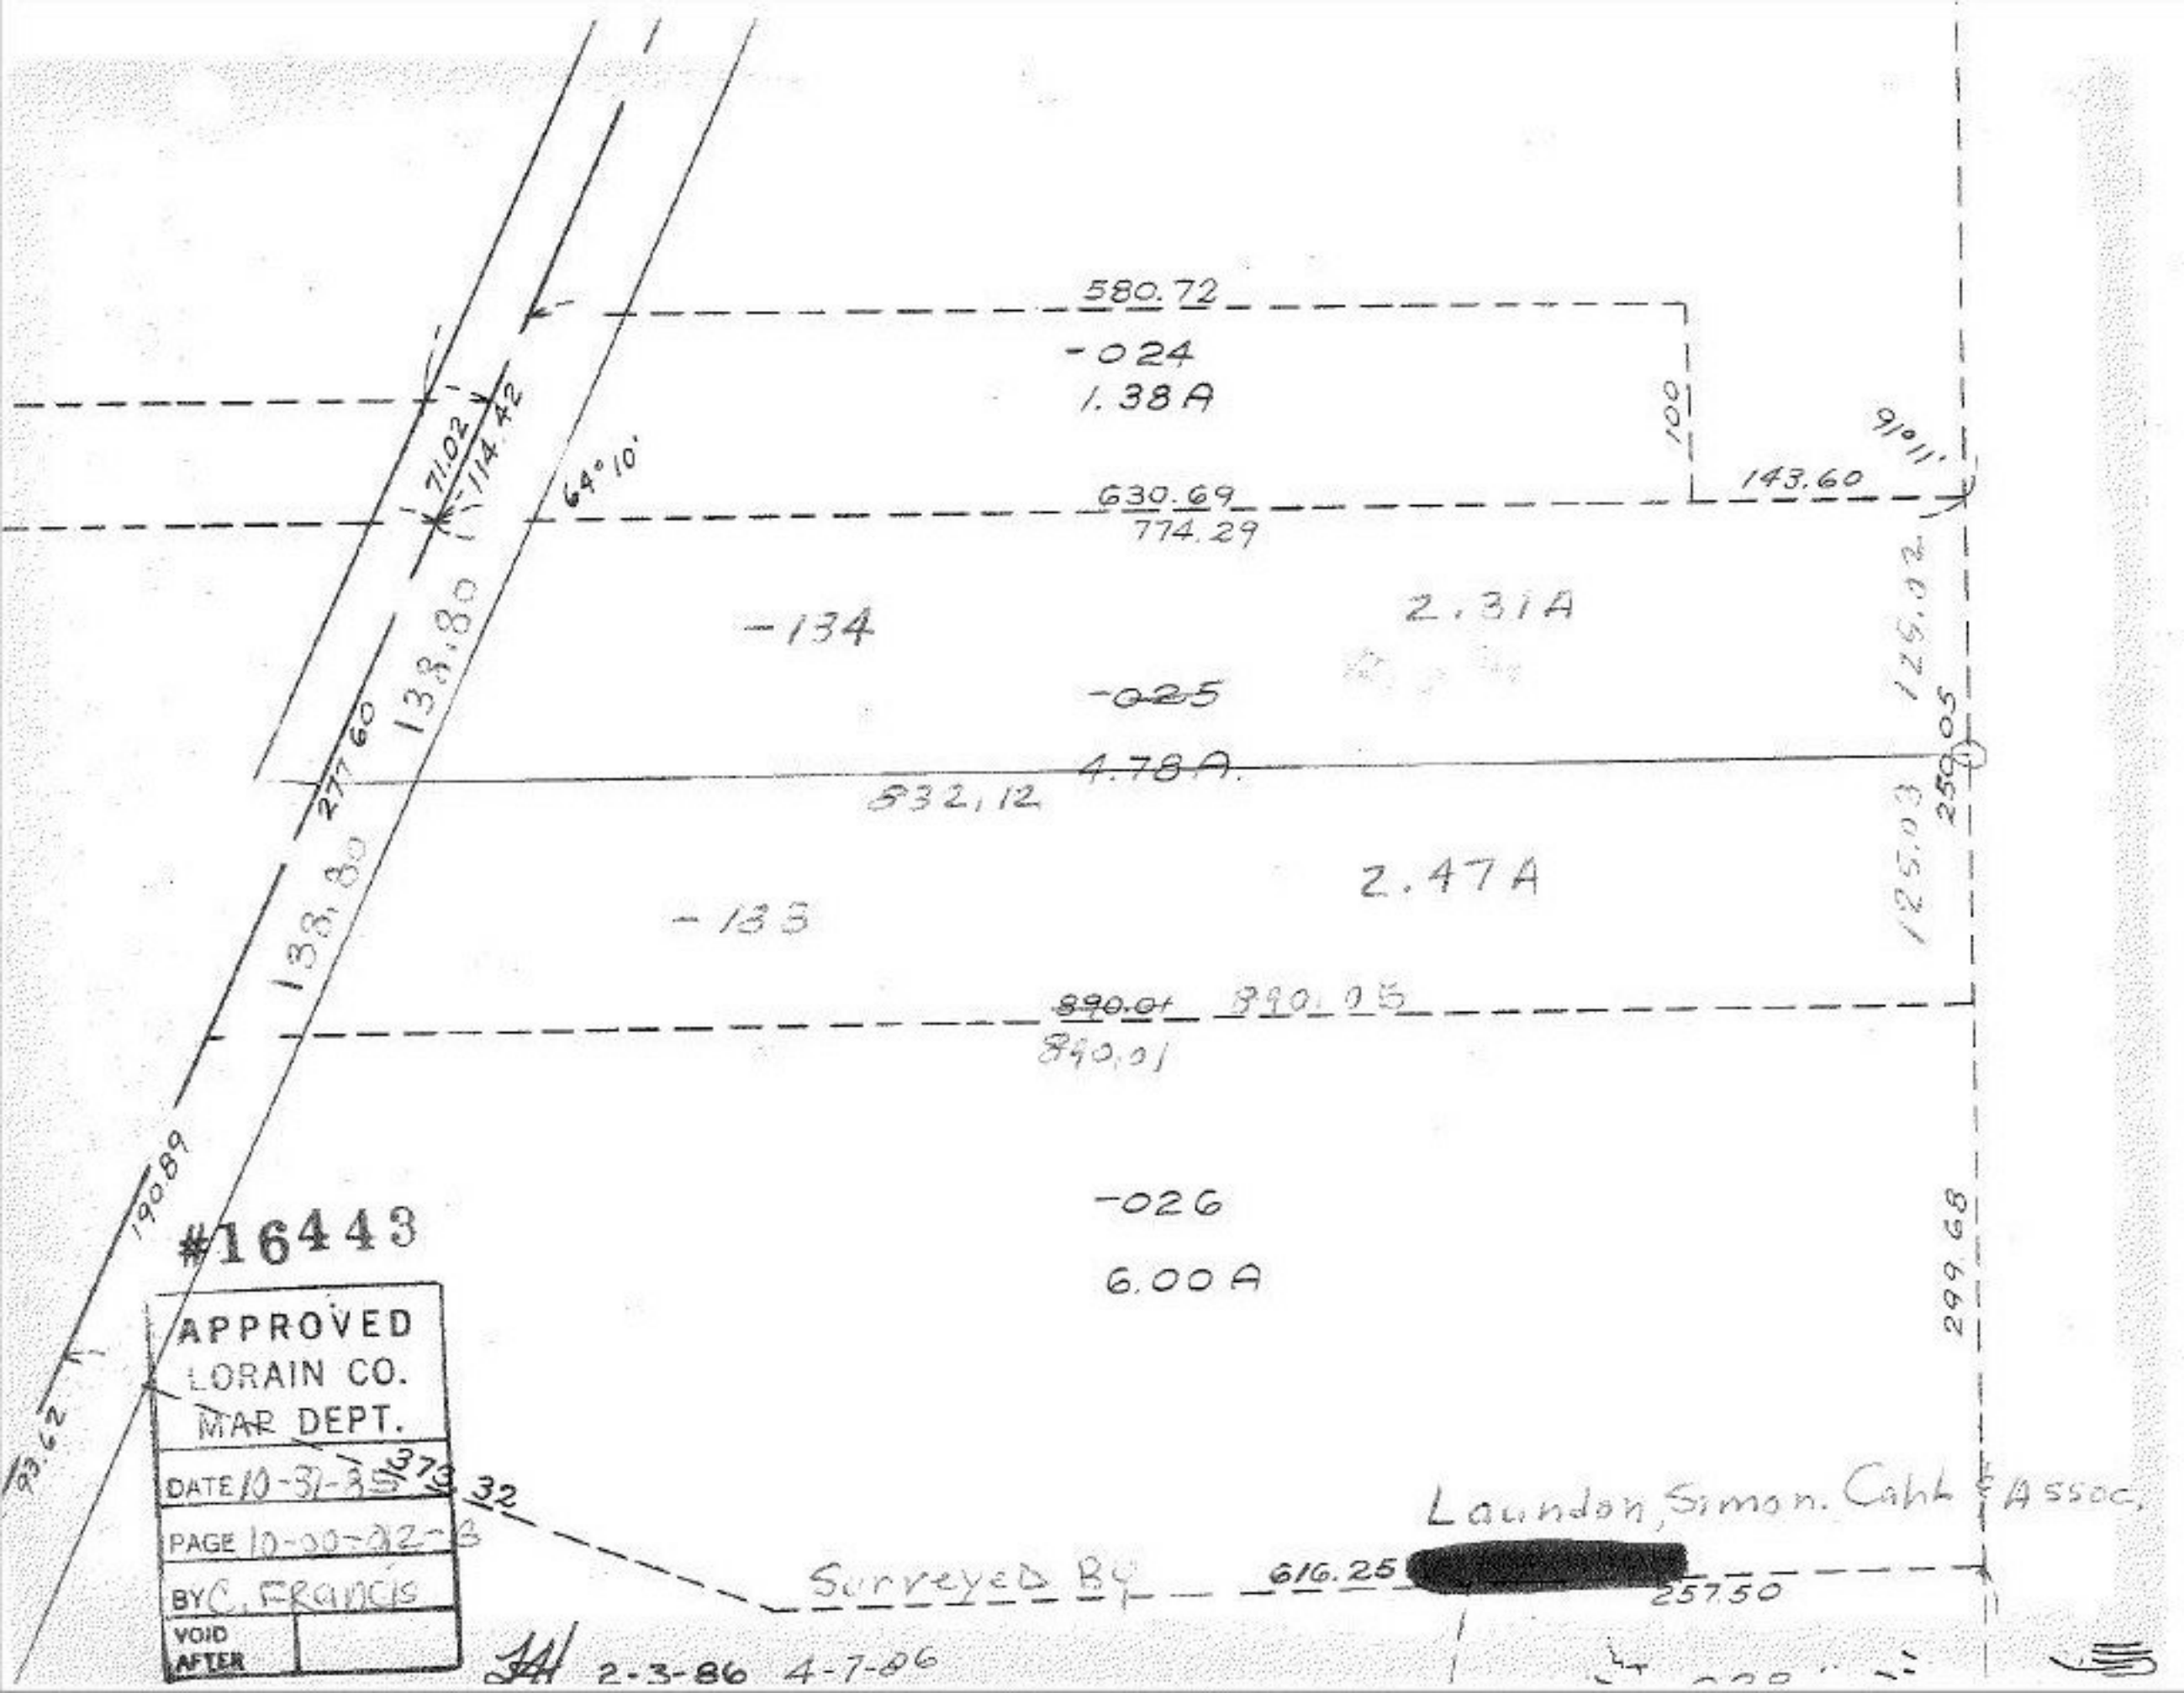

#16443

APPROVED
LORAIN CO.
MAP DEPT.
DATE 10-31-85
PAGE 10-00-02-B
BY C. FRANCIS
VOID AFTER