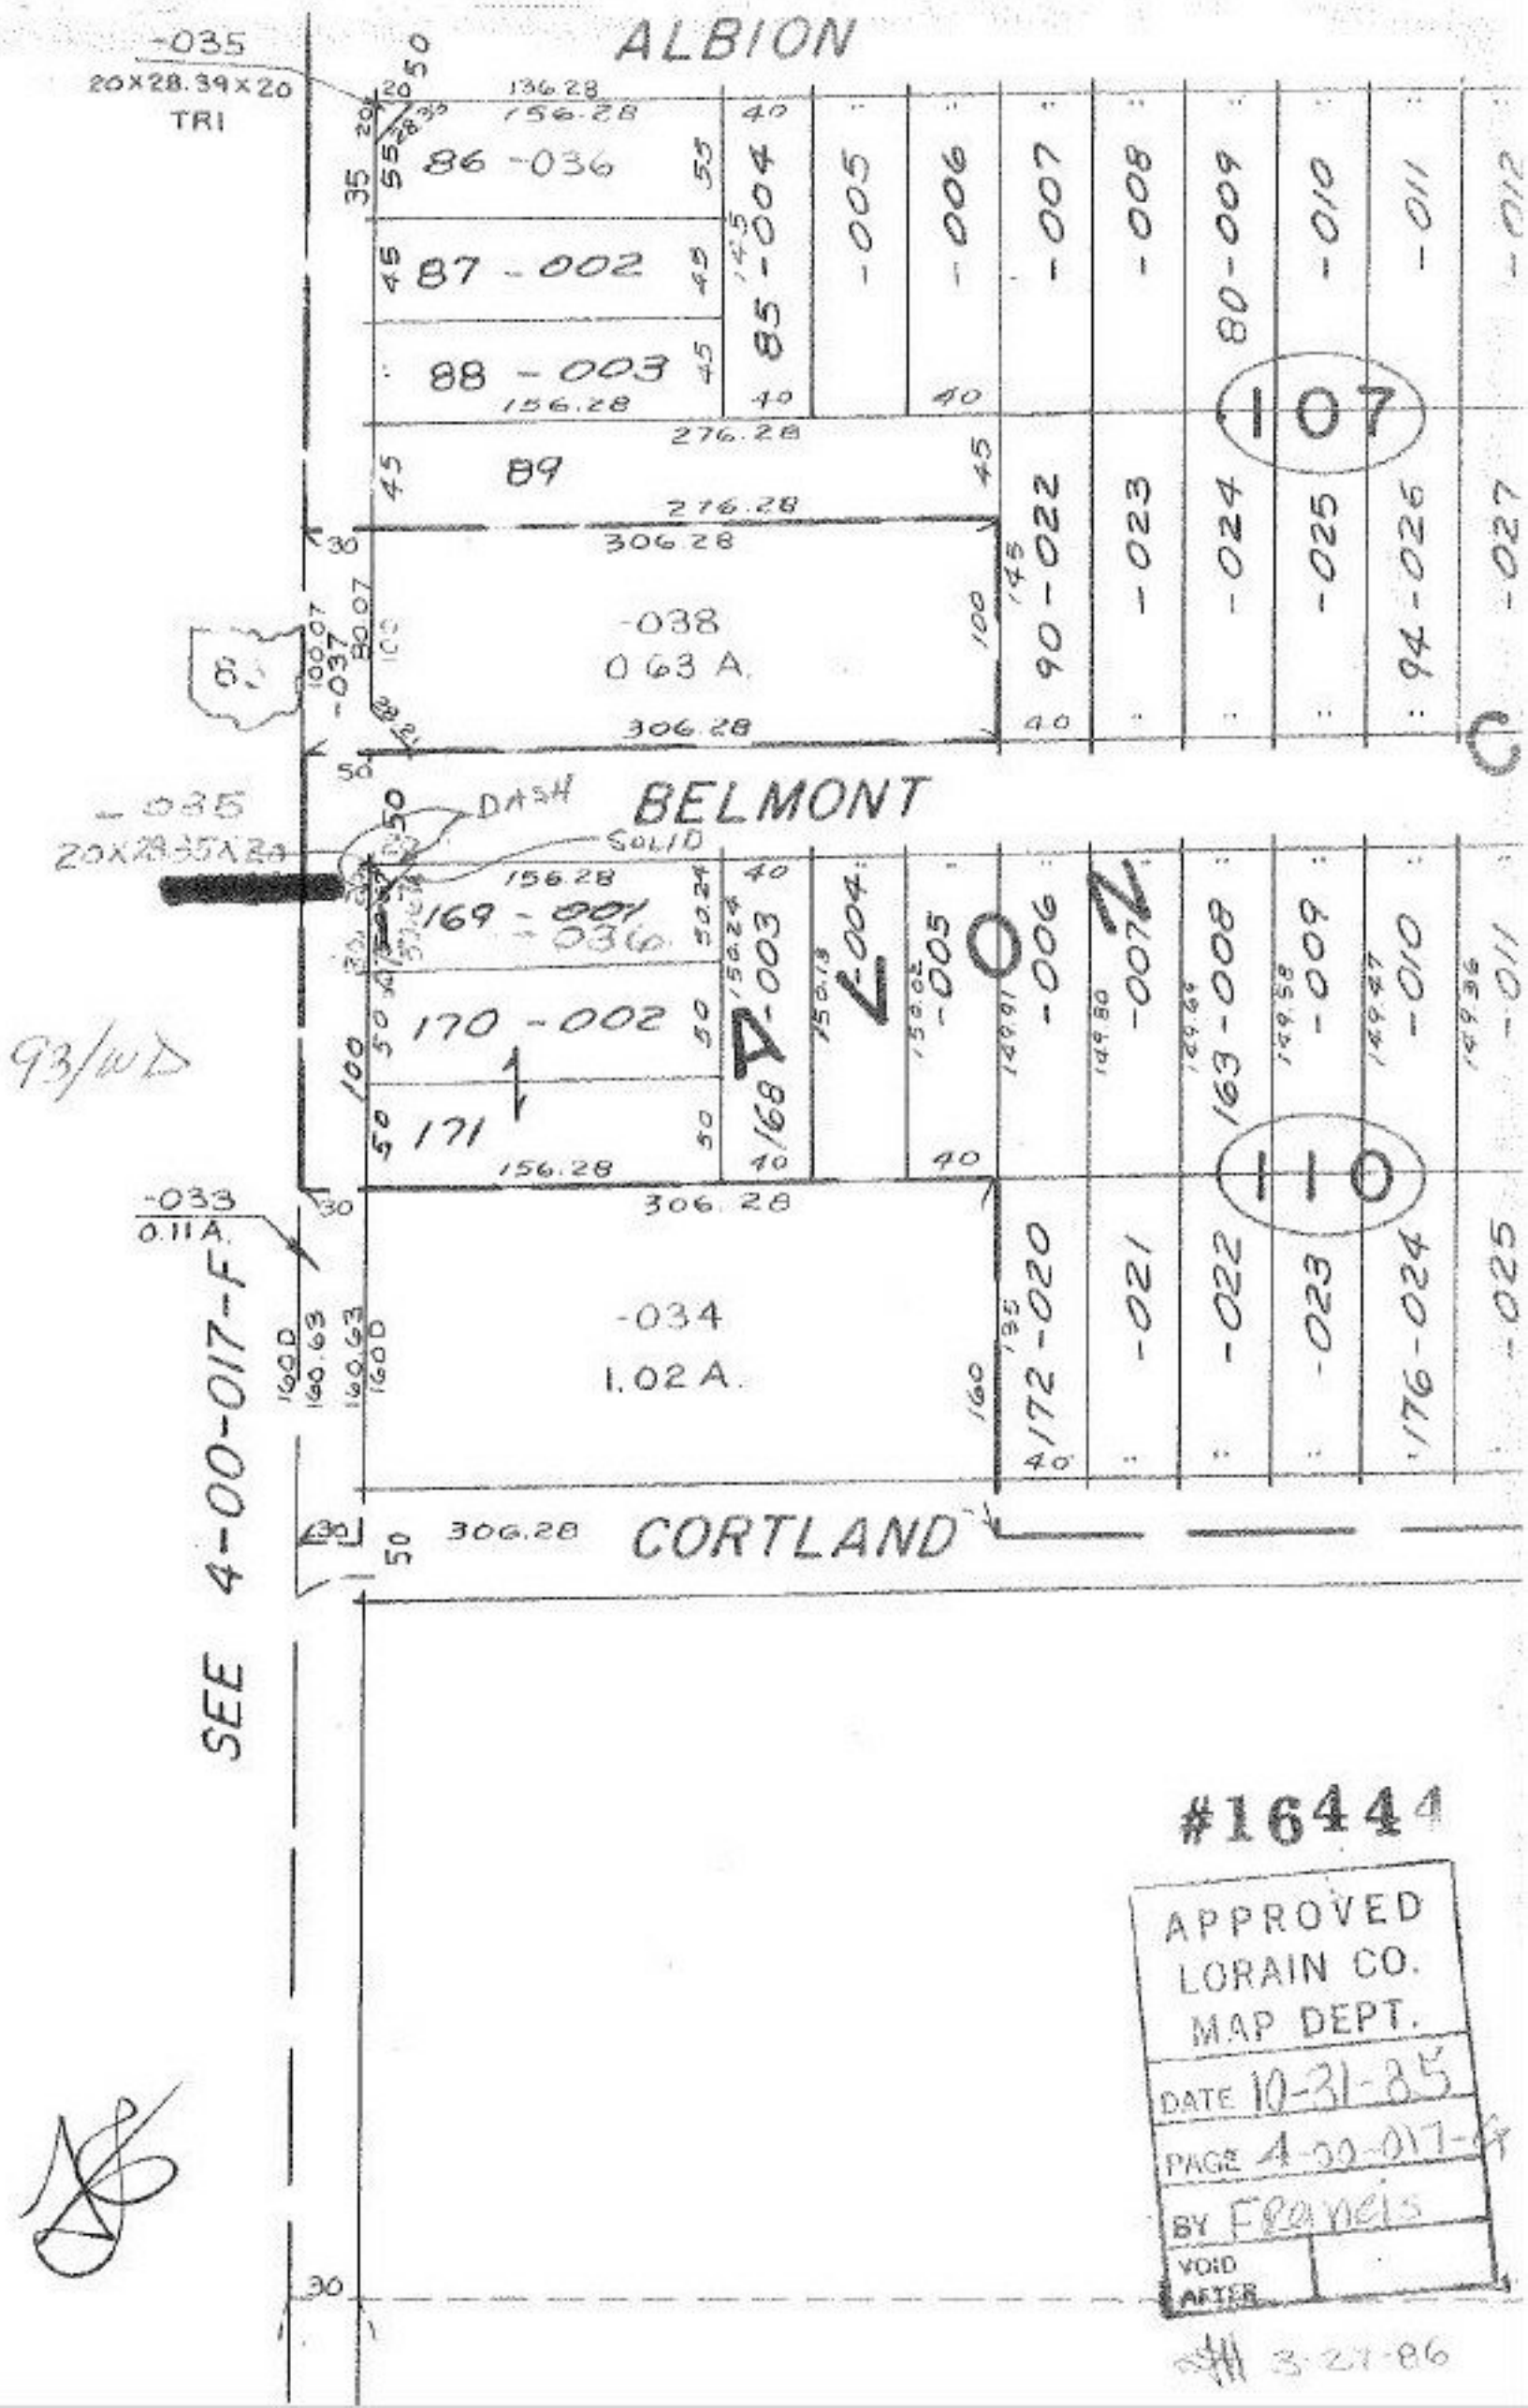
ALBION
BELMONT
CORTLAND
-035
20X28.39X20
TRI
-035
20X28.35X20
DASH
SOLID
-033
0.11A.
SEE 4-00-017-F
86 -036
87 -002
88 -003
89
85 -004
-005
-006
-007
-008
80-009
-010
-011
-012
107
90-022
-023
-024
-025
94-026
-027
-038
0.63 A.
-037
169 -001
-036
170 -002
171
168 -003
-004
-005
-006
-007
163-008
-009
-010
-011
110
172-020
-021
-022
-023
176-024
-025
-034
1.02 A.
93/WD
#16444
APPROVED
LORAIN CO.
MAP DEPT.
DATE 10-31-85
PAGE 4-00-017-G
BY Francis
VOID AFTER
3-27-86