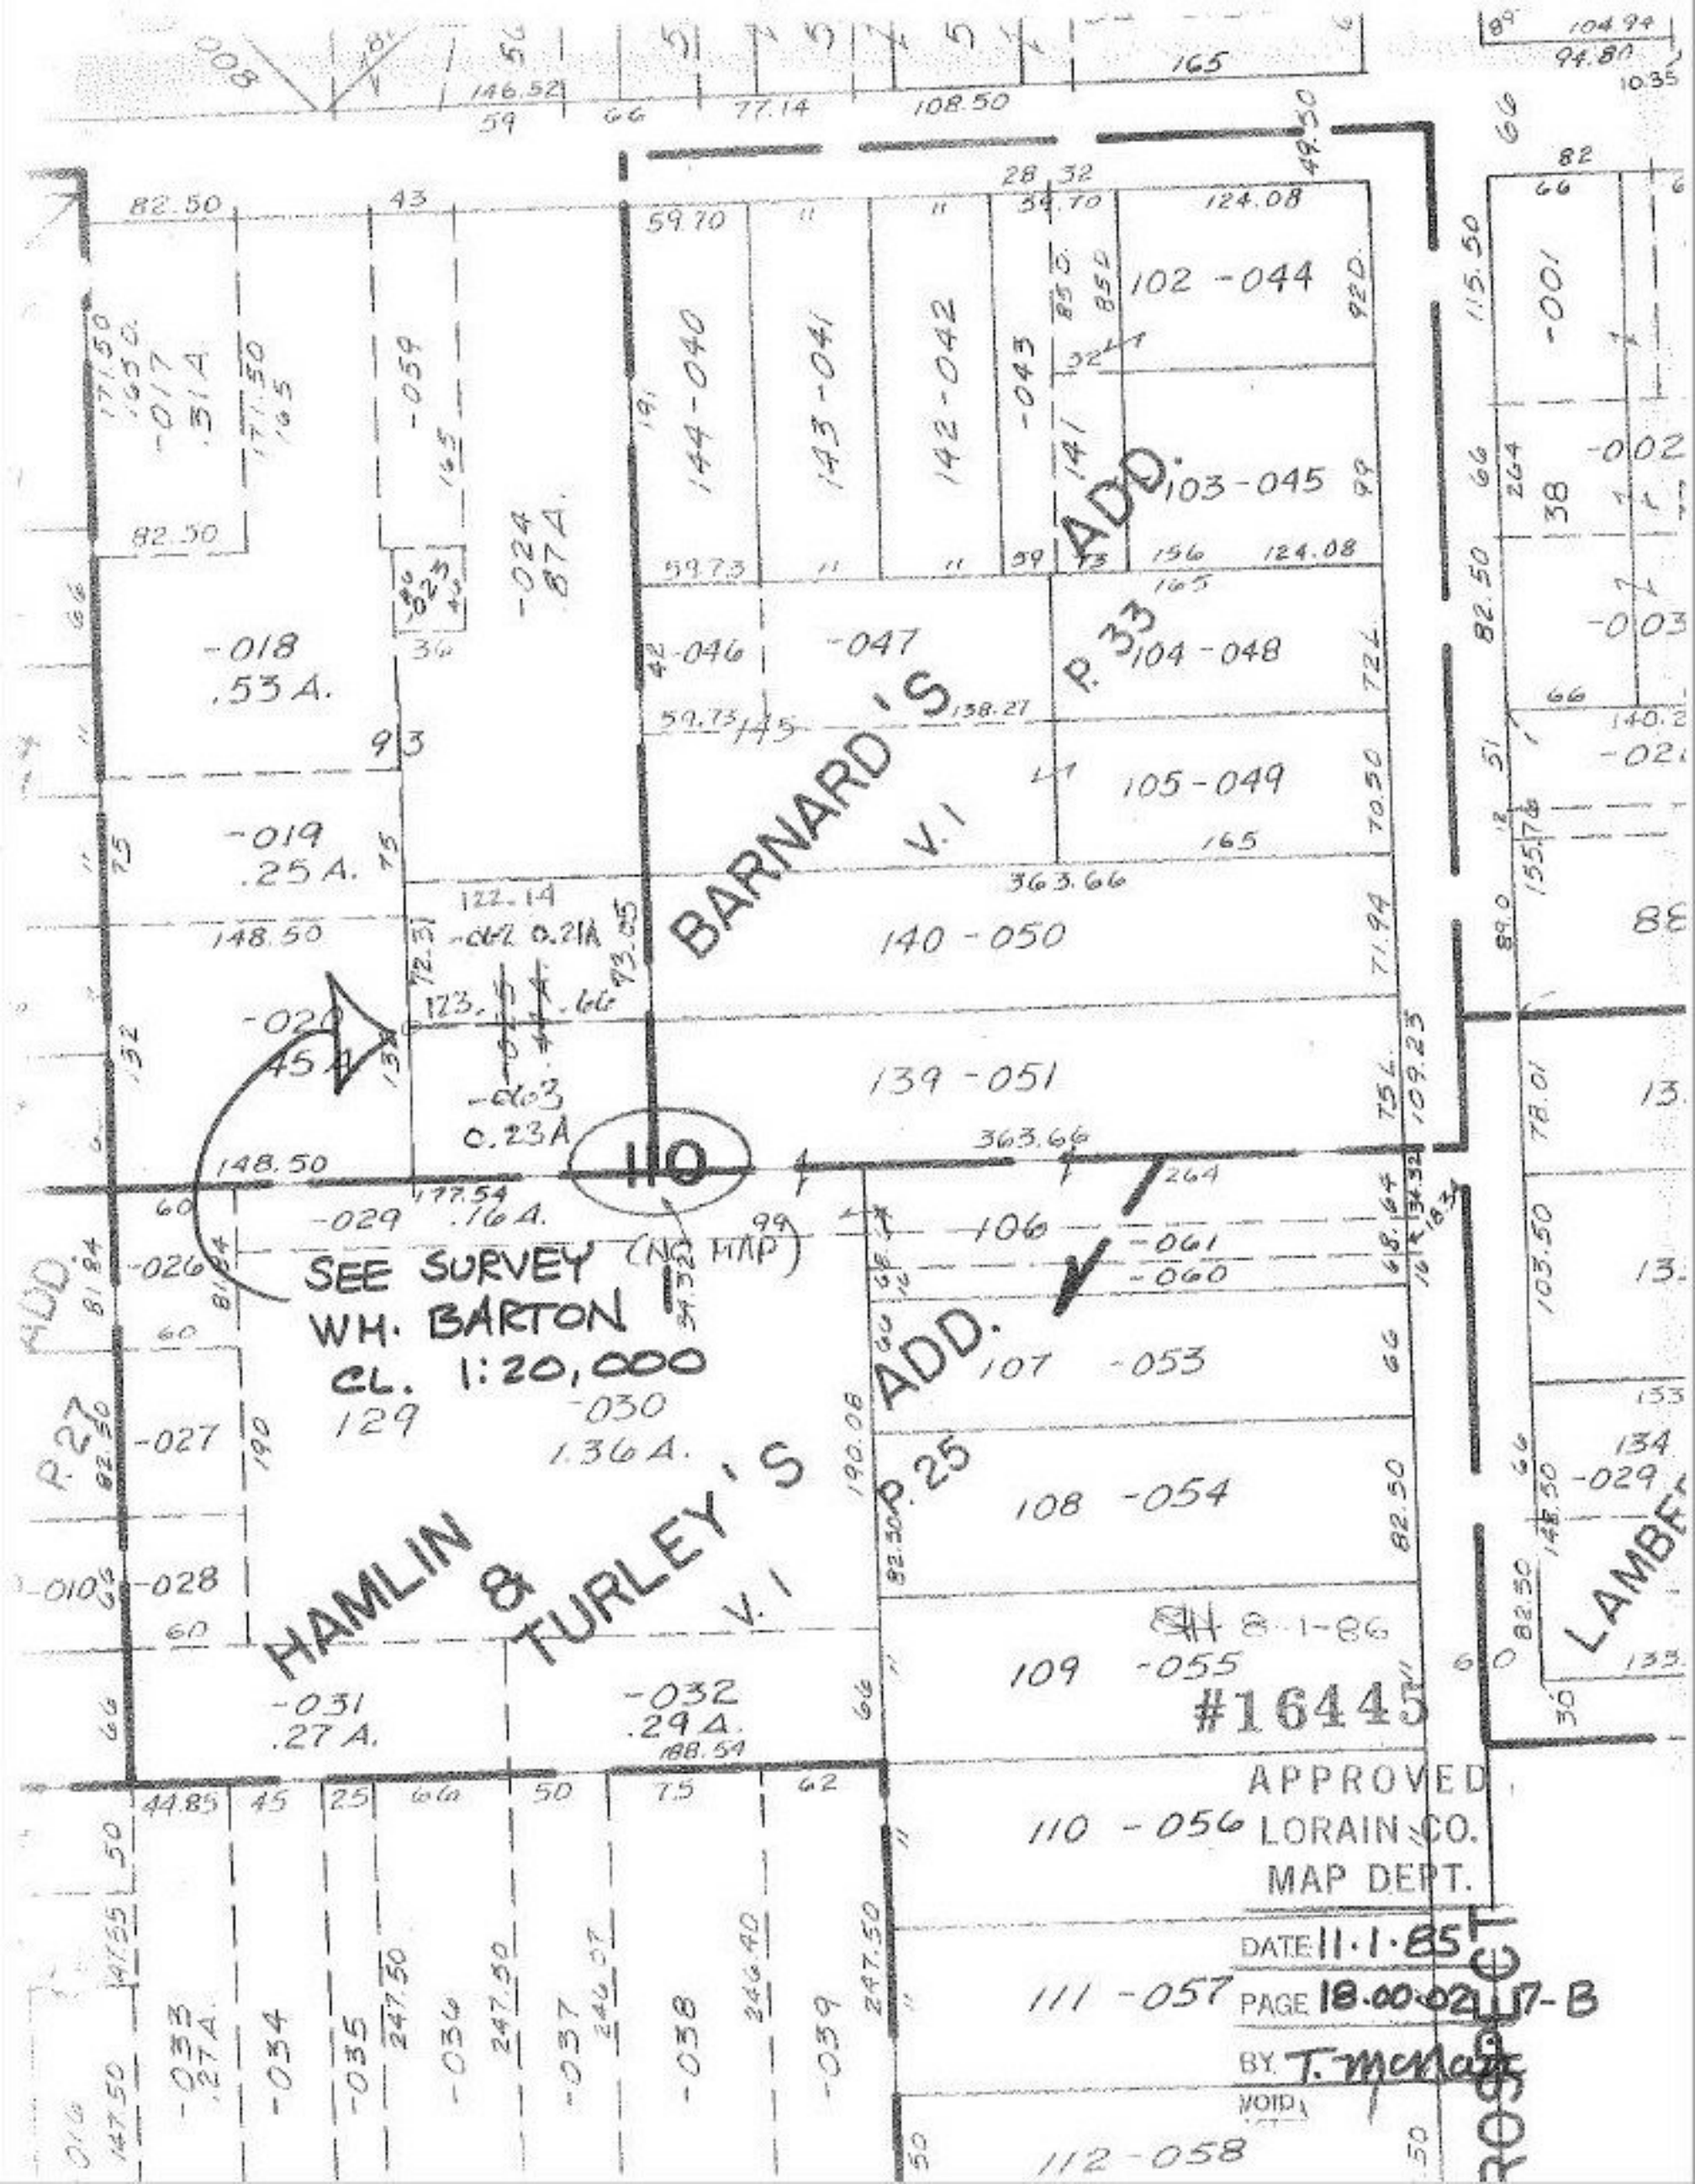

BARNARD'S ADD.
V.1
P. 33
HAMLIN & TURLEY'S ADD.
V.1
P. 25
P. 27
LAMBE
SEE SURVEY
WH. BARTON
CL. 1:20,000
(NO MAP)
110
102 -044
103 -045
104 -048
105 -049
140 -050
139 -051
106
107 -053
108 -054
109 -055
110 -056
111 -057
112 -058
144 -040
143 -041
142 -042
-043
-046
-047
-018
.53 A.
-019
.25 A.
-020
.45 A.
-024
.87 A.
-029
.16 A.
-030
1.36 A.
-031
.27 A.
-032
.29 A.
-033
.27 A.
-034
-035
-036
-037
-038
-039
-017
.31 A
-059
-062 0.21A
-063
0.23A
-001
-002
-003
-029
-026
-027
-028
-010
-061
-060
#16445
APPROVED
LORAIN CO.
MAP DEPT.
DATE 11·1·85
PAGE 18.00.02 17-B
BY T. McNair
VOID