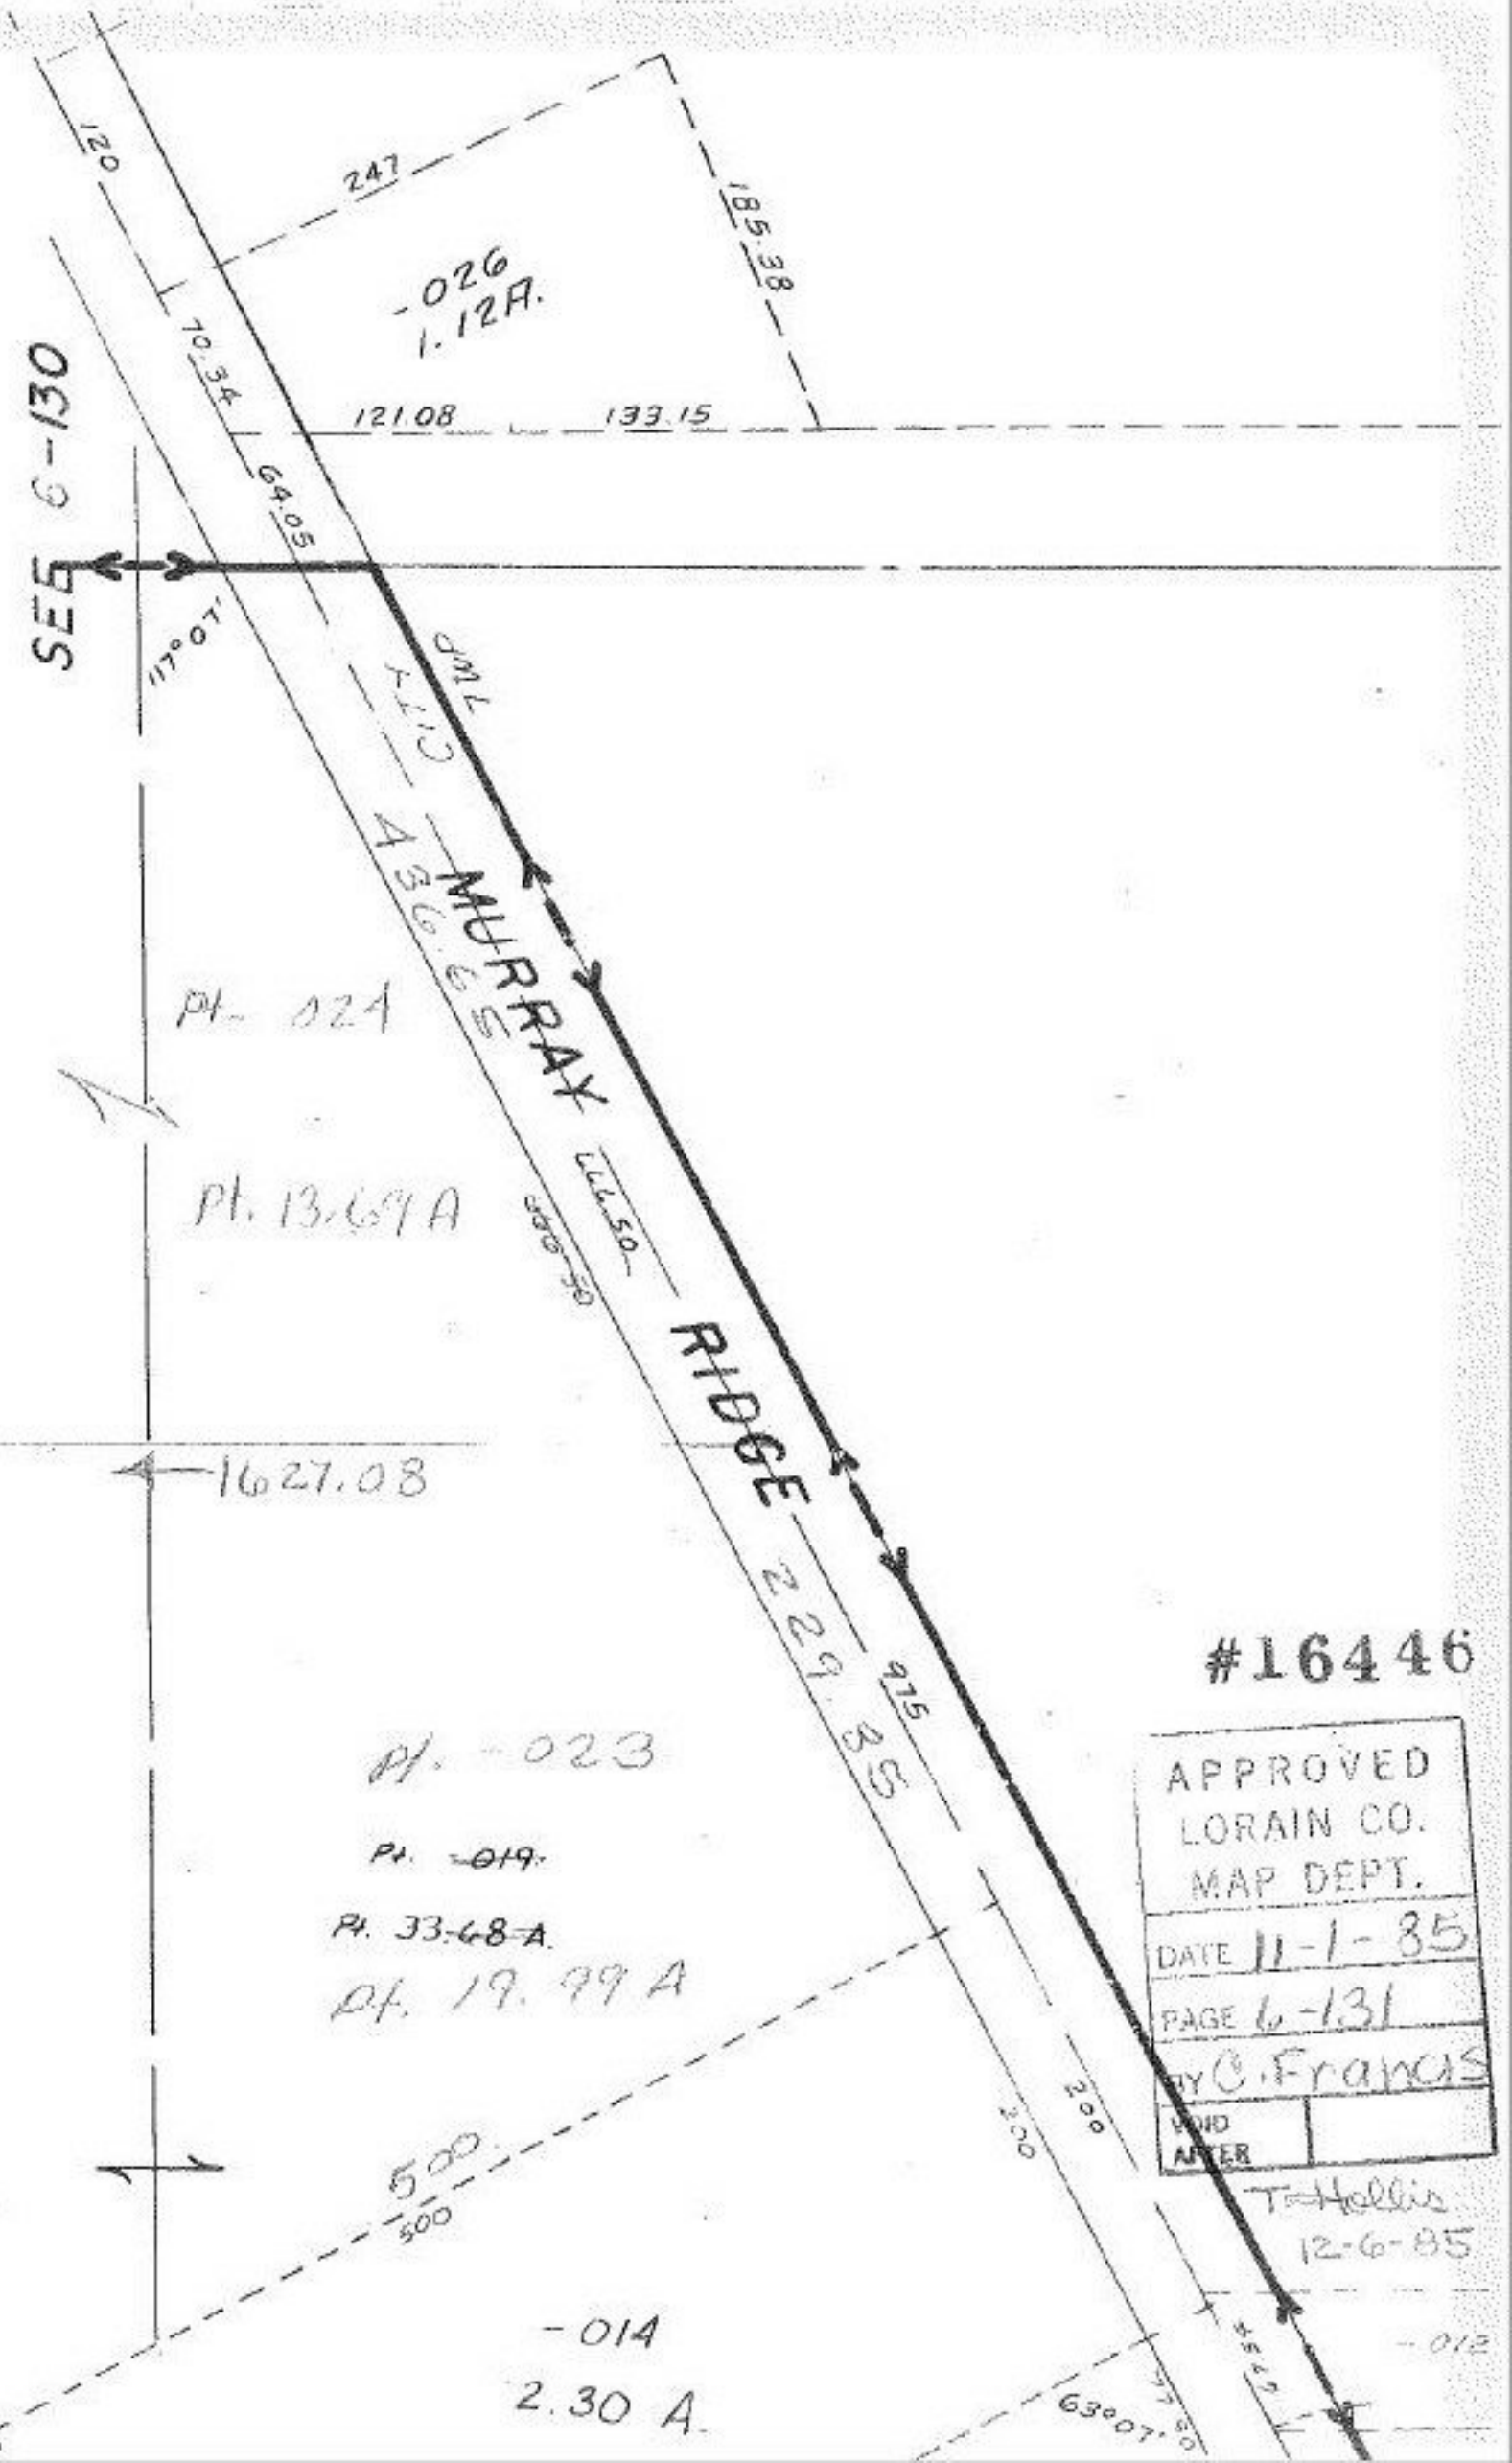

SEE 6-130
120
247
185.38
-026
1.12A.
70.34
121.08
133.15
64.05
117°07'
MURRAY RIDGE
436.65
Pt. 024
Pt. 13.69 A
1627.08
229.85
975
Pt. -023
Pt. -019
Pt. 33.68 A
Pt. 19.99 A
500
500
200
200
-014
2.30 A.
63°07'
-012
#16446
APPROVED
LORAIN CO.
MAP DEPT.
DATE 11-1-85
PAGE 6-131
BY C. Francis
VOID AFTER
T. Hollis
12-6-85