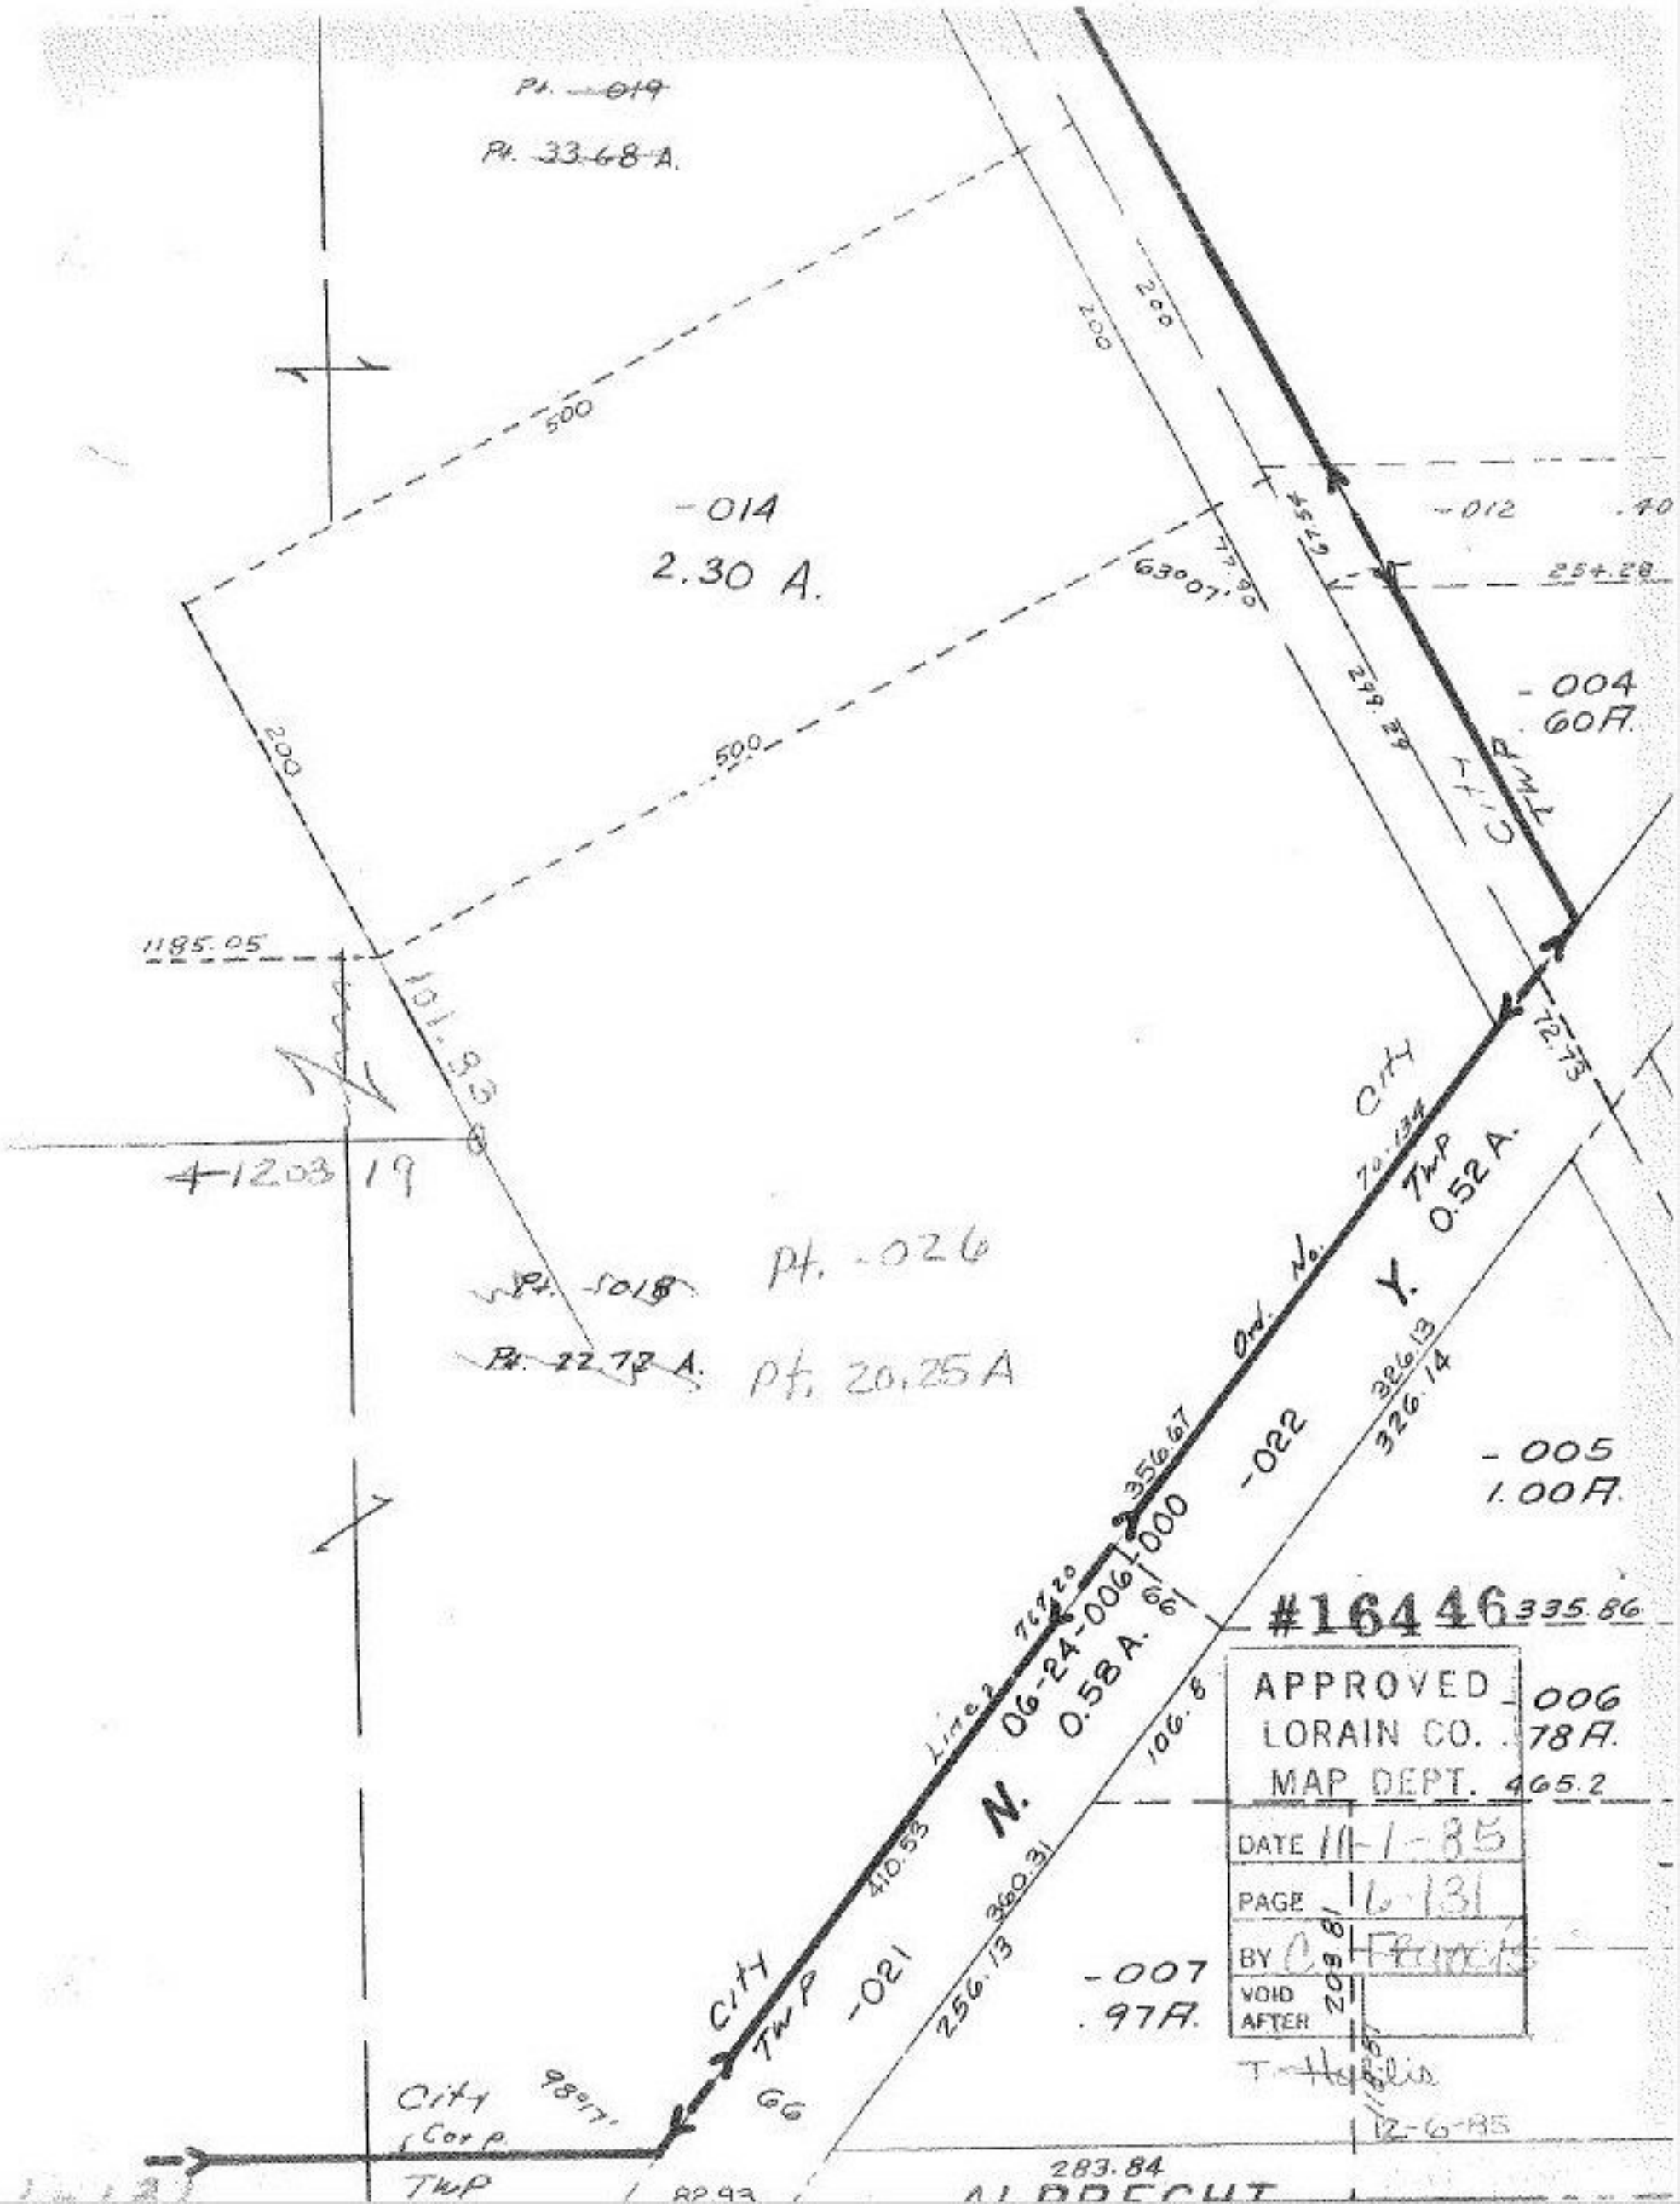

Pt. -019
Pt. 33.68 A.
-014
2.30 A.
500
200
200
500
200
63°07'
77.90
67.54
299.29
-012
.40
254.28
-004
.60 A.
City
Twp
1185.05
101.93
1203.19
Pt. -026
Pt. -018
Pt. 22.72 A.
Pt. 20.25 A
City
Twp
0.52 A.
Y.
Ord. No.
70.134
72.73
326.13
326.14
-022
356.67
-005
1.00 A.
#16446
335.86
-006
.78 A.
465.2
N.
06-24-006
0.58 A.
Line 2
767.20
410.53
106.8
360.31
256.13
-021
City
Twp
66
-007
.97 A.
209.81
City
Corp.
Twp
98°17'
82.93
283.84
ALBRECHT
APPROVED
LORAIN CO.
MAP DEPT.
DATE 11-1-85
PAGE 6-131
BY C. Francis
VOID AFTER
T. Hyblis
12-6-85