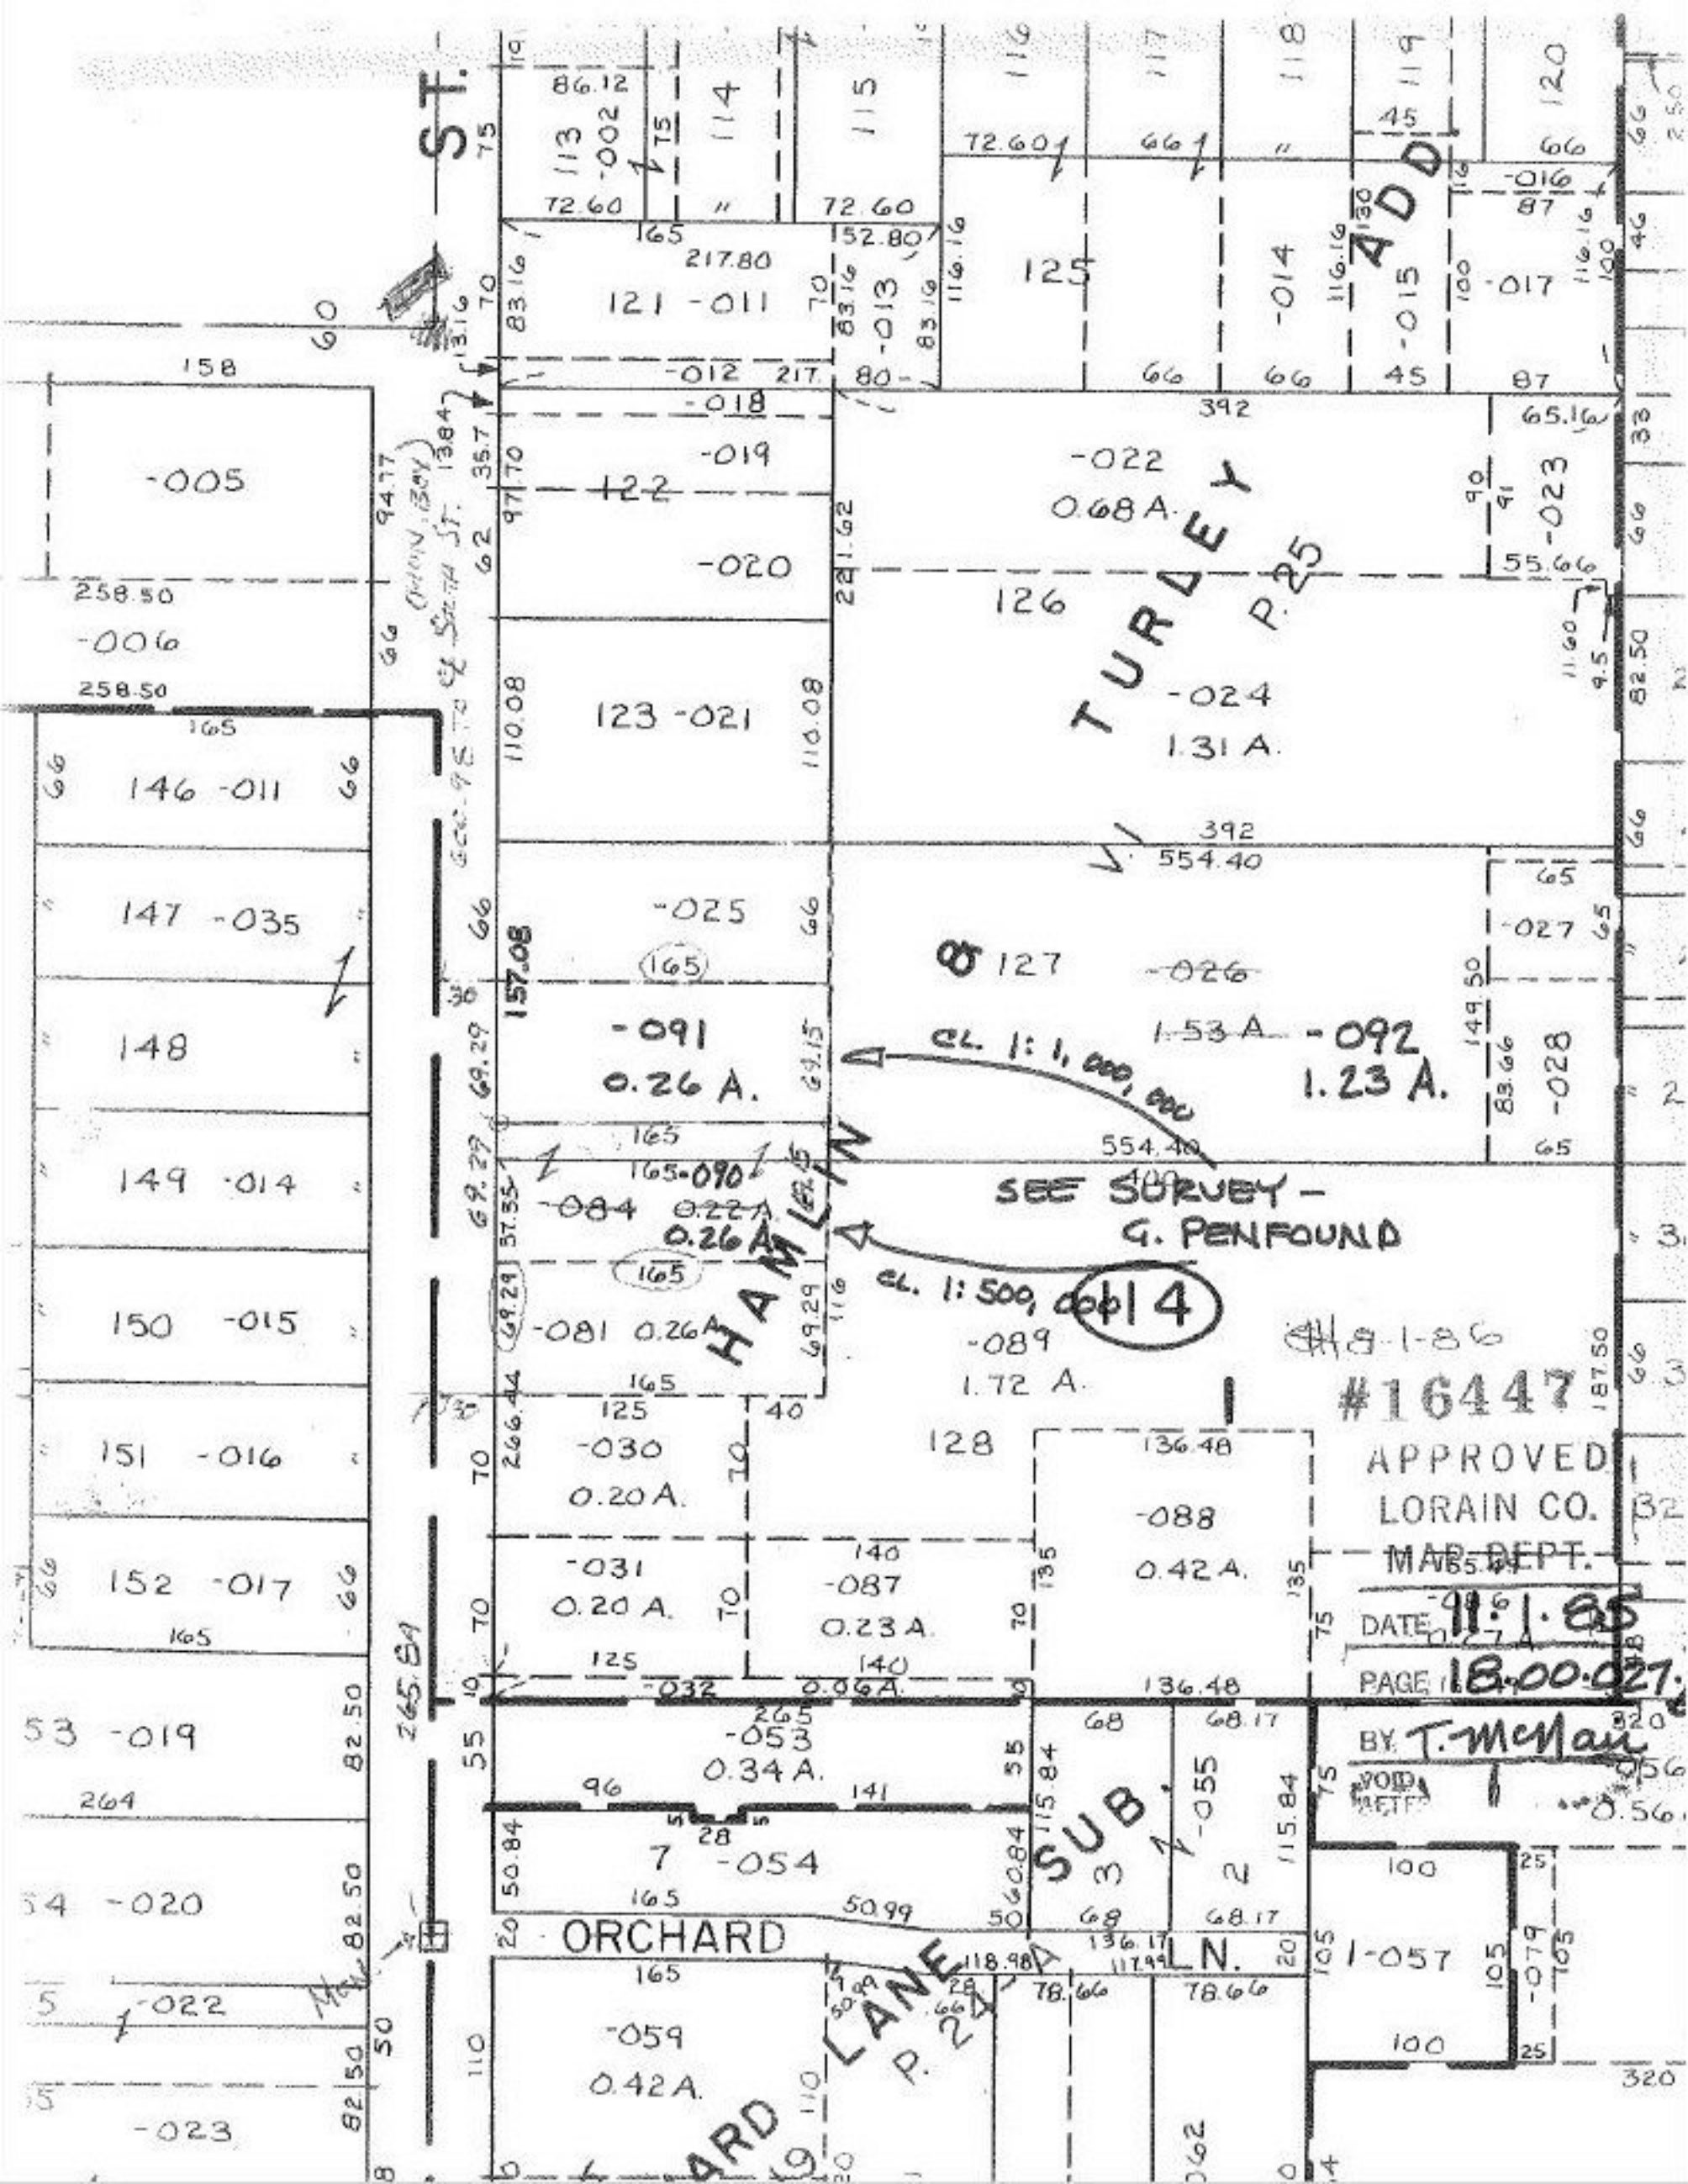

ST.
ADD
TURLEY
P. 25
HAMLIN
SUB.
ORCHARD
LN.
LANE
P. 24
CL. 1: 1,000,000
SEE SURVEY - G. PENFOUND
CL. 1: 500,000
114
#16447
APPROVED
LORAIN CO.
MAP DEPT.
DATE 11.1.85
PAGE 18.00.027
BY T. McNair
VOID