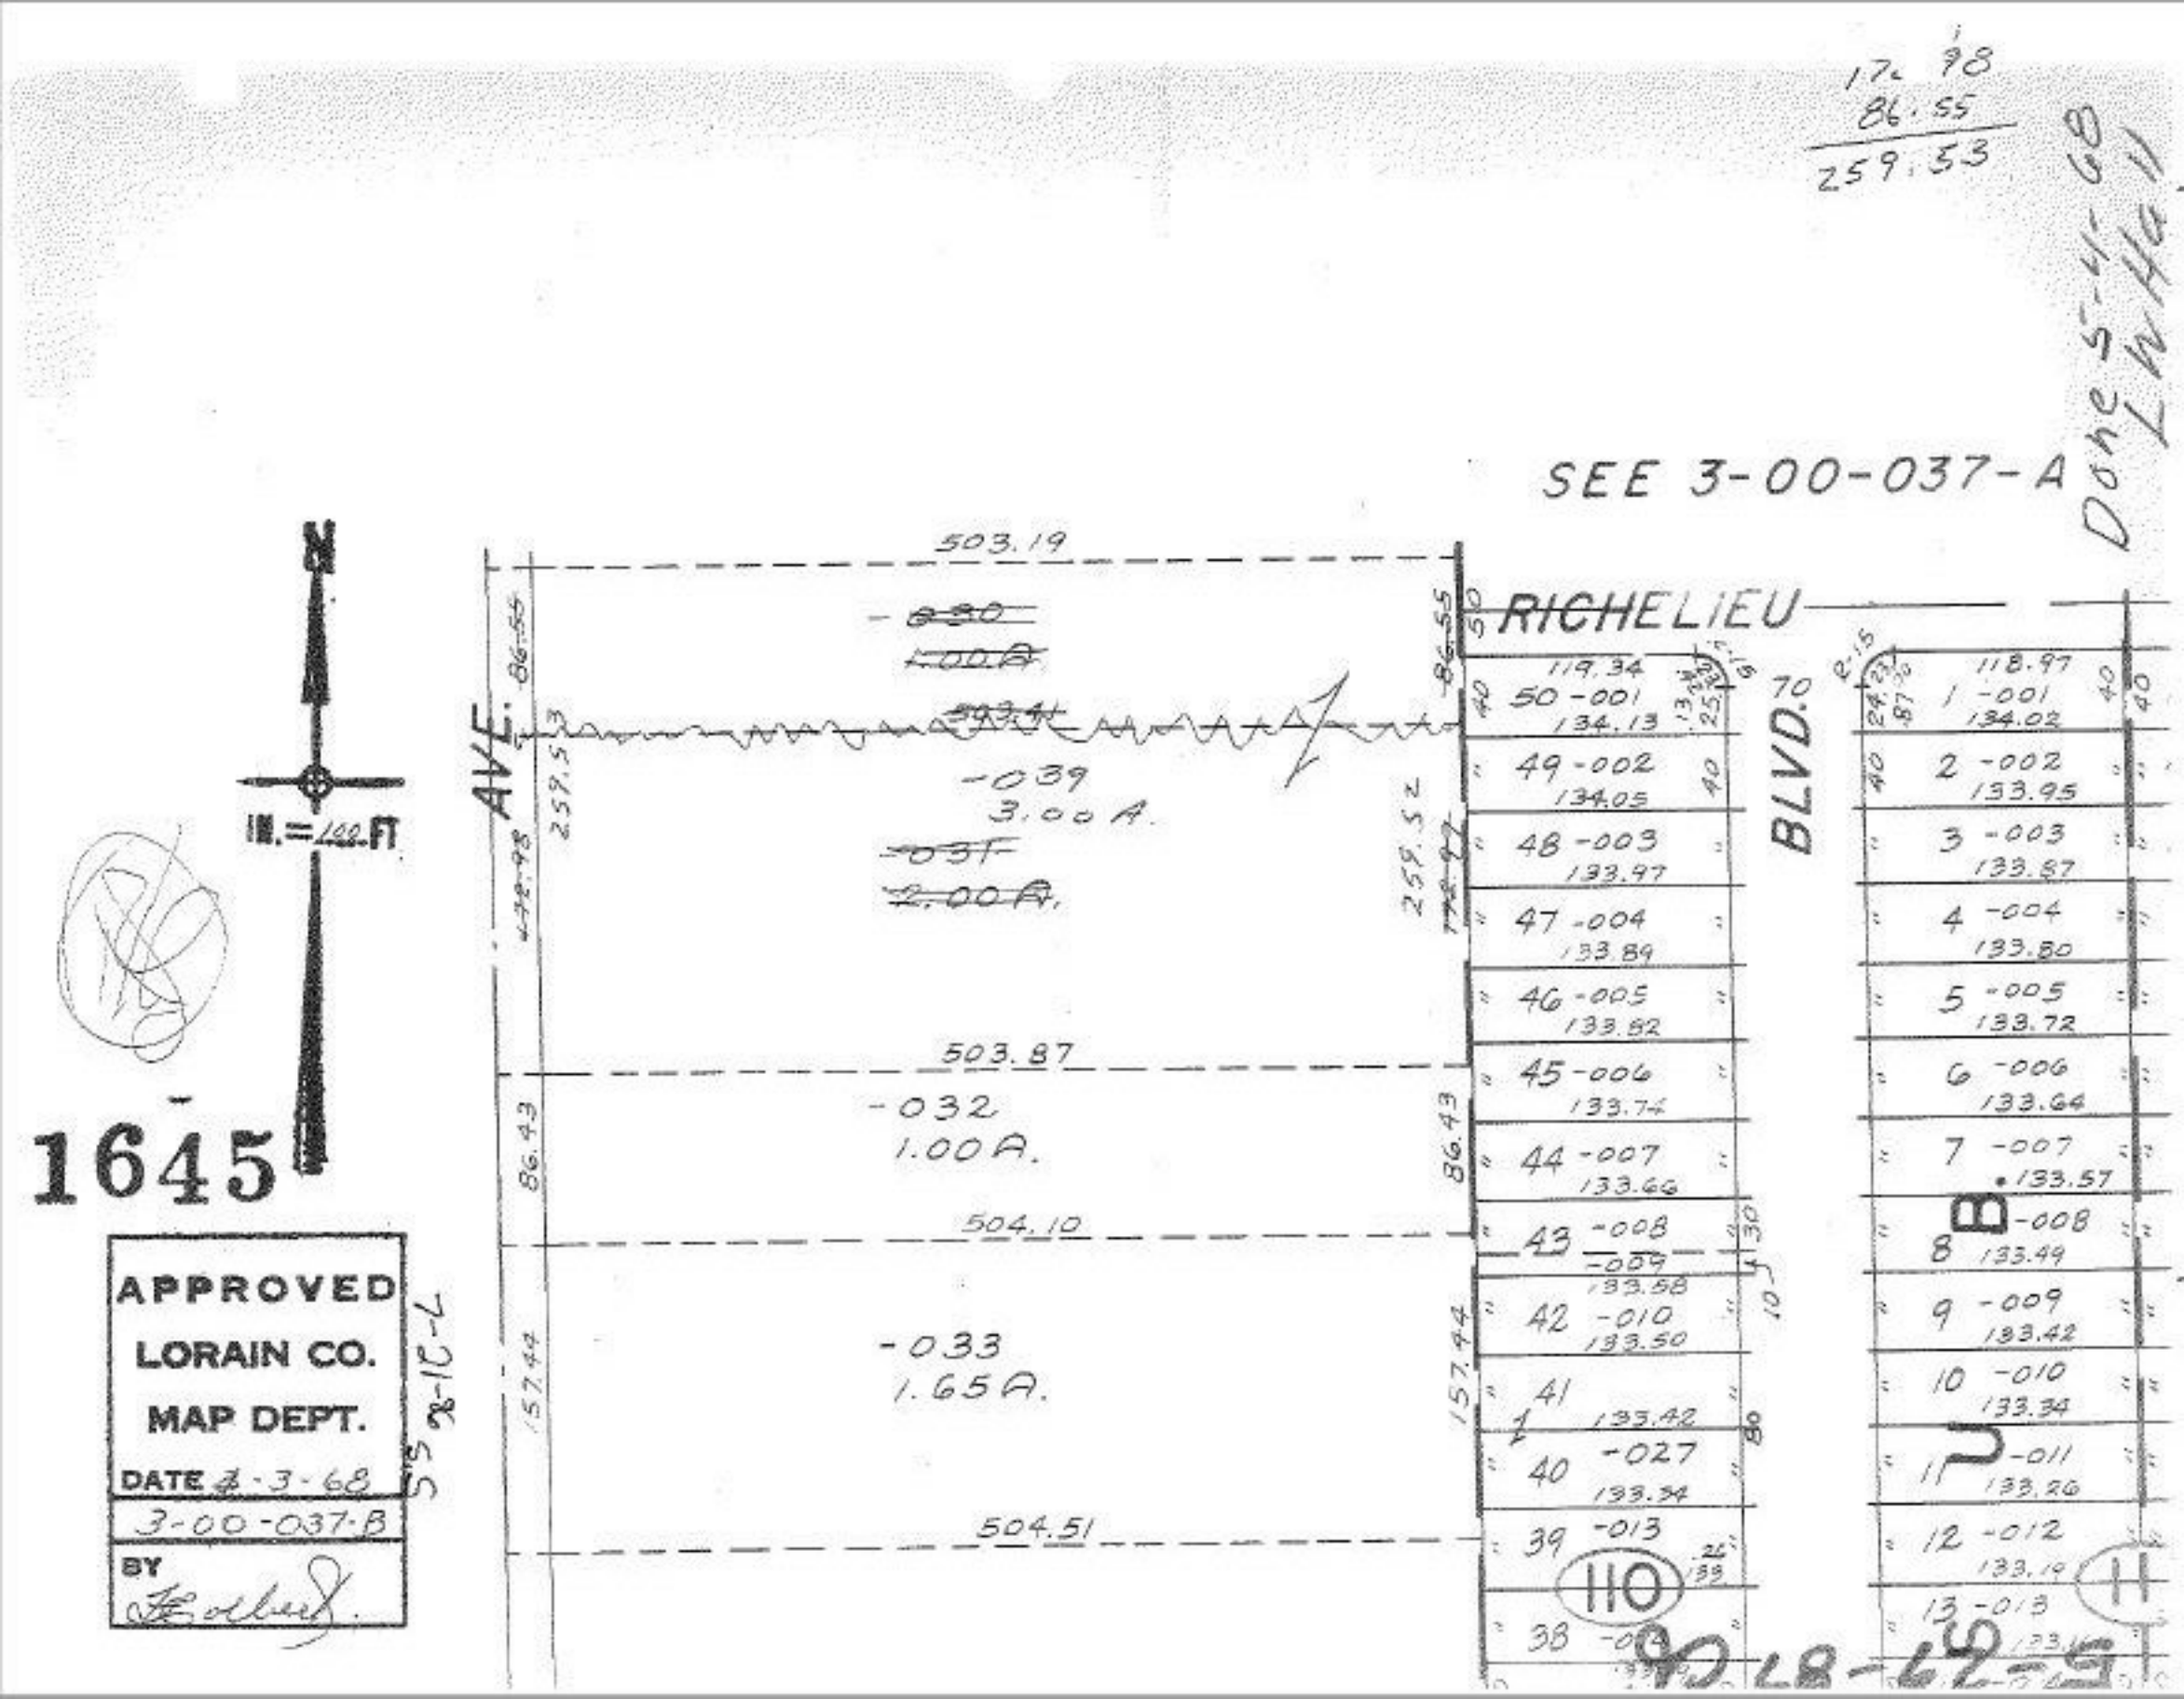

17.98
86.55
259.53
Done 5-4-68
LW Hall
SEE 3-00-037-A
N
IN.=100 FT
1645
APPROVED
LORAIN CO.
MAP DEPT.
DATE 4-3-68
3-00-037-B
BY
503.19
-030
1.00 A.
503.41
-039
3.00 A.
-031
2.00 A.
503.87
-032
1.00 A.
504.10
-033
1.65 A.
504.51
AVE.
RICHELIEU
BLVD.
50 -001 134.13
49 -002 134.05
48 -003 133.97
47 -004 133.89
46 -005 133.82
45 -006 133.74
44 -007 133.66
43 -008 -009 133.58
42 -010 133.50
41 133.42
40 -027 133.34
39 -013
38 -014
1 -001 134.02
2 -002 133.95
3 -003 133.87
4 -004 133.80
5 -005 133.72
6 -006 133.64
7 -007 133.57
8 -008 133.49
9 -009 133.42
10 -010 133.34
11 -011 133.26
12 -012 133.19
13 -013
110
11