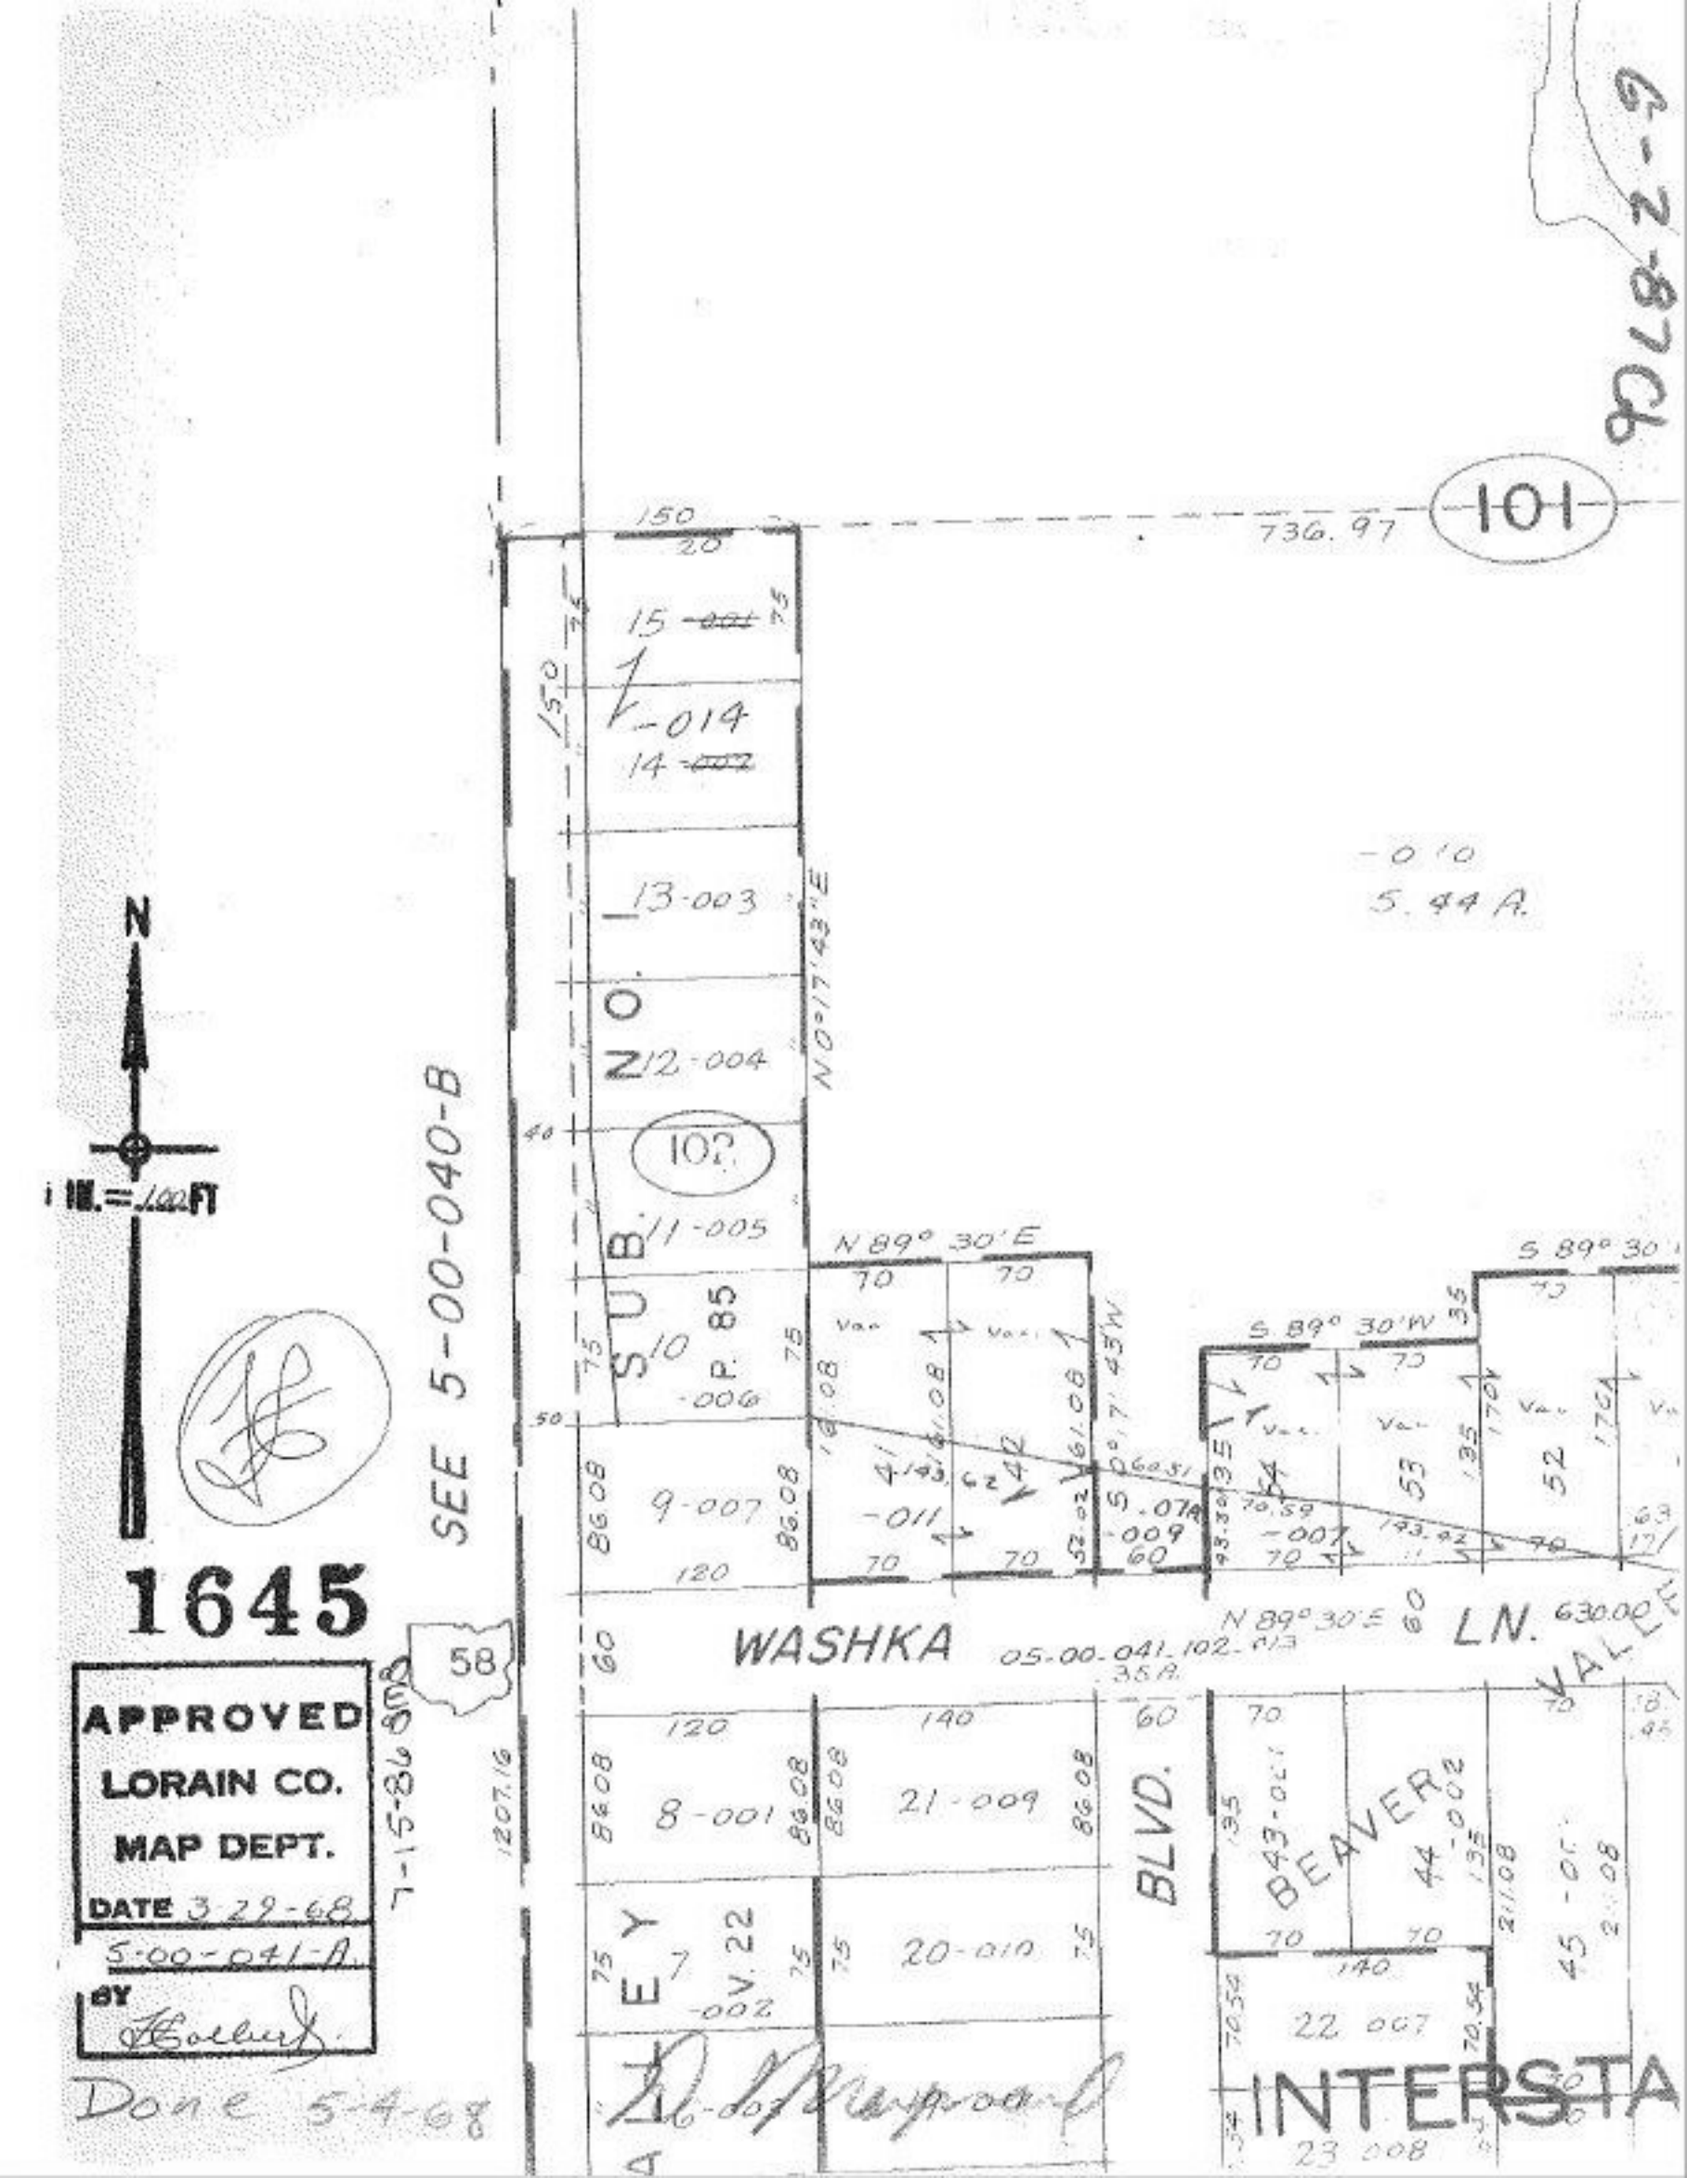

6-2-87Cb
101
736.97
15 -001
-014
14 -002
13-003
12-004
102
11-005
SUB. NO. 1
P. 85
10
-006
9-007
SEE 5-00-040-B
N 0°17'43"E
-010
5.44 A.
N 89° 30'E
S 89° 30'W
S 89° 30'
41
42
-011
-009
-007
54
53
52
WASHKA
LN.
630.00
05-00-041-102-013
.35 A.
58
7-15-86 BMB
1207.16
8-001
21-009
20-010
7
V. 22
-002
BLVD.
BEAVER
44-002
45-001
22 007
23 008
INTERSTA
N
1 IN. = 100 FT
1645
APPROVED
LORAIN CO.
MAP DEPT.
DATE 3-29-68
5-00-041-A
BY
Done 5-4-68