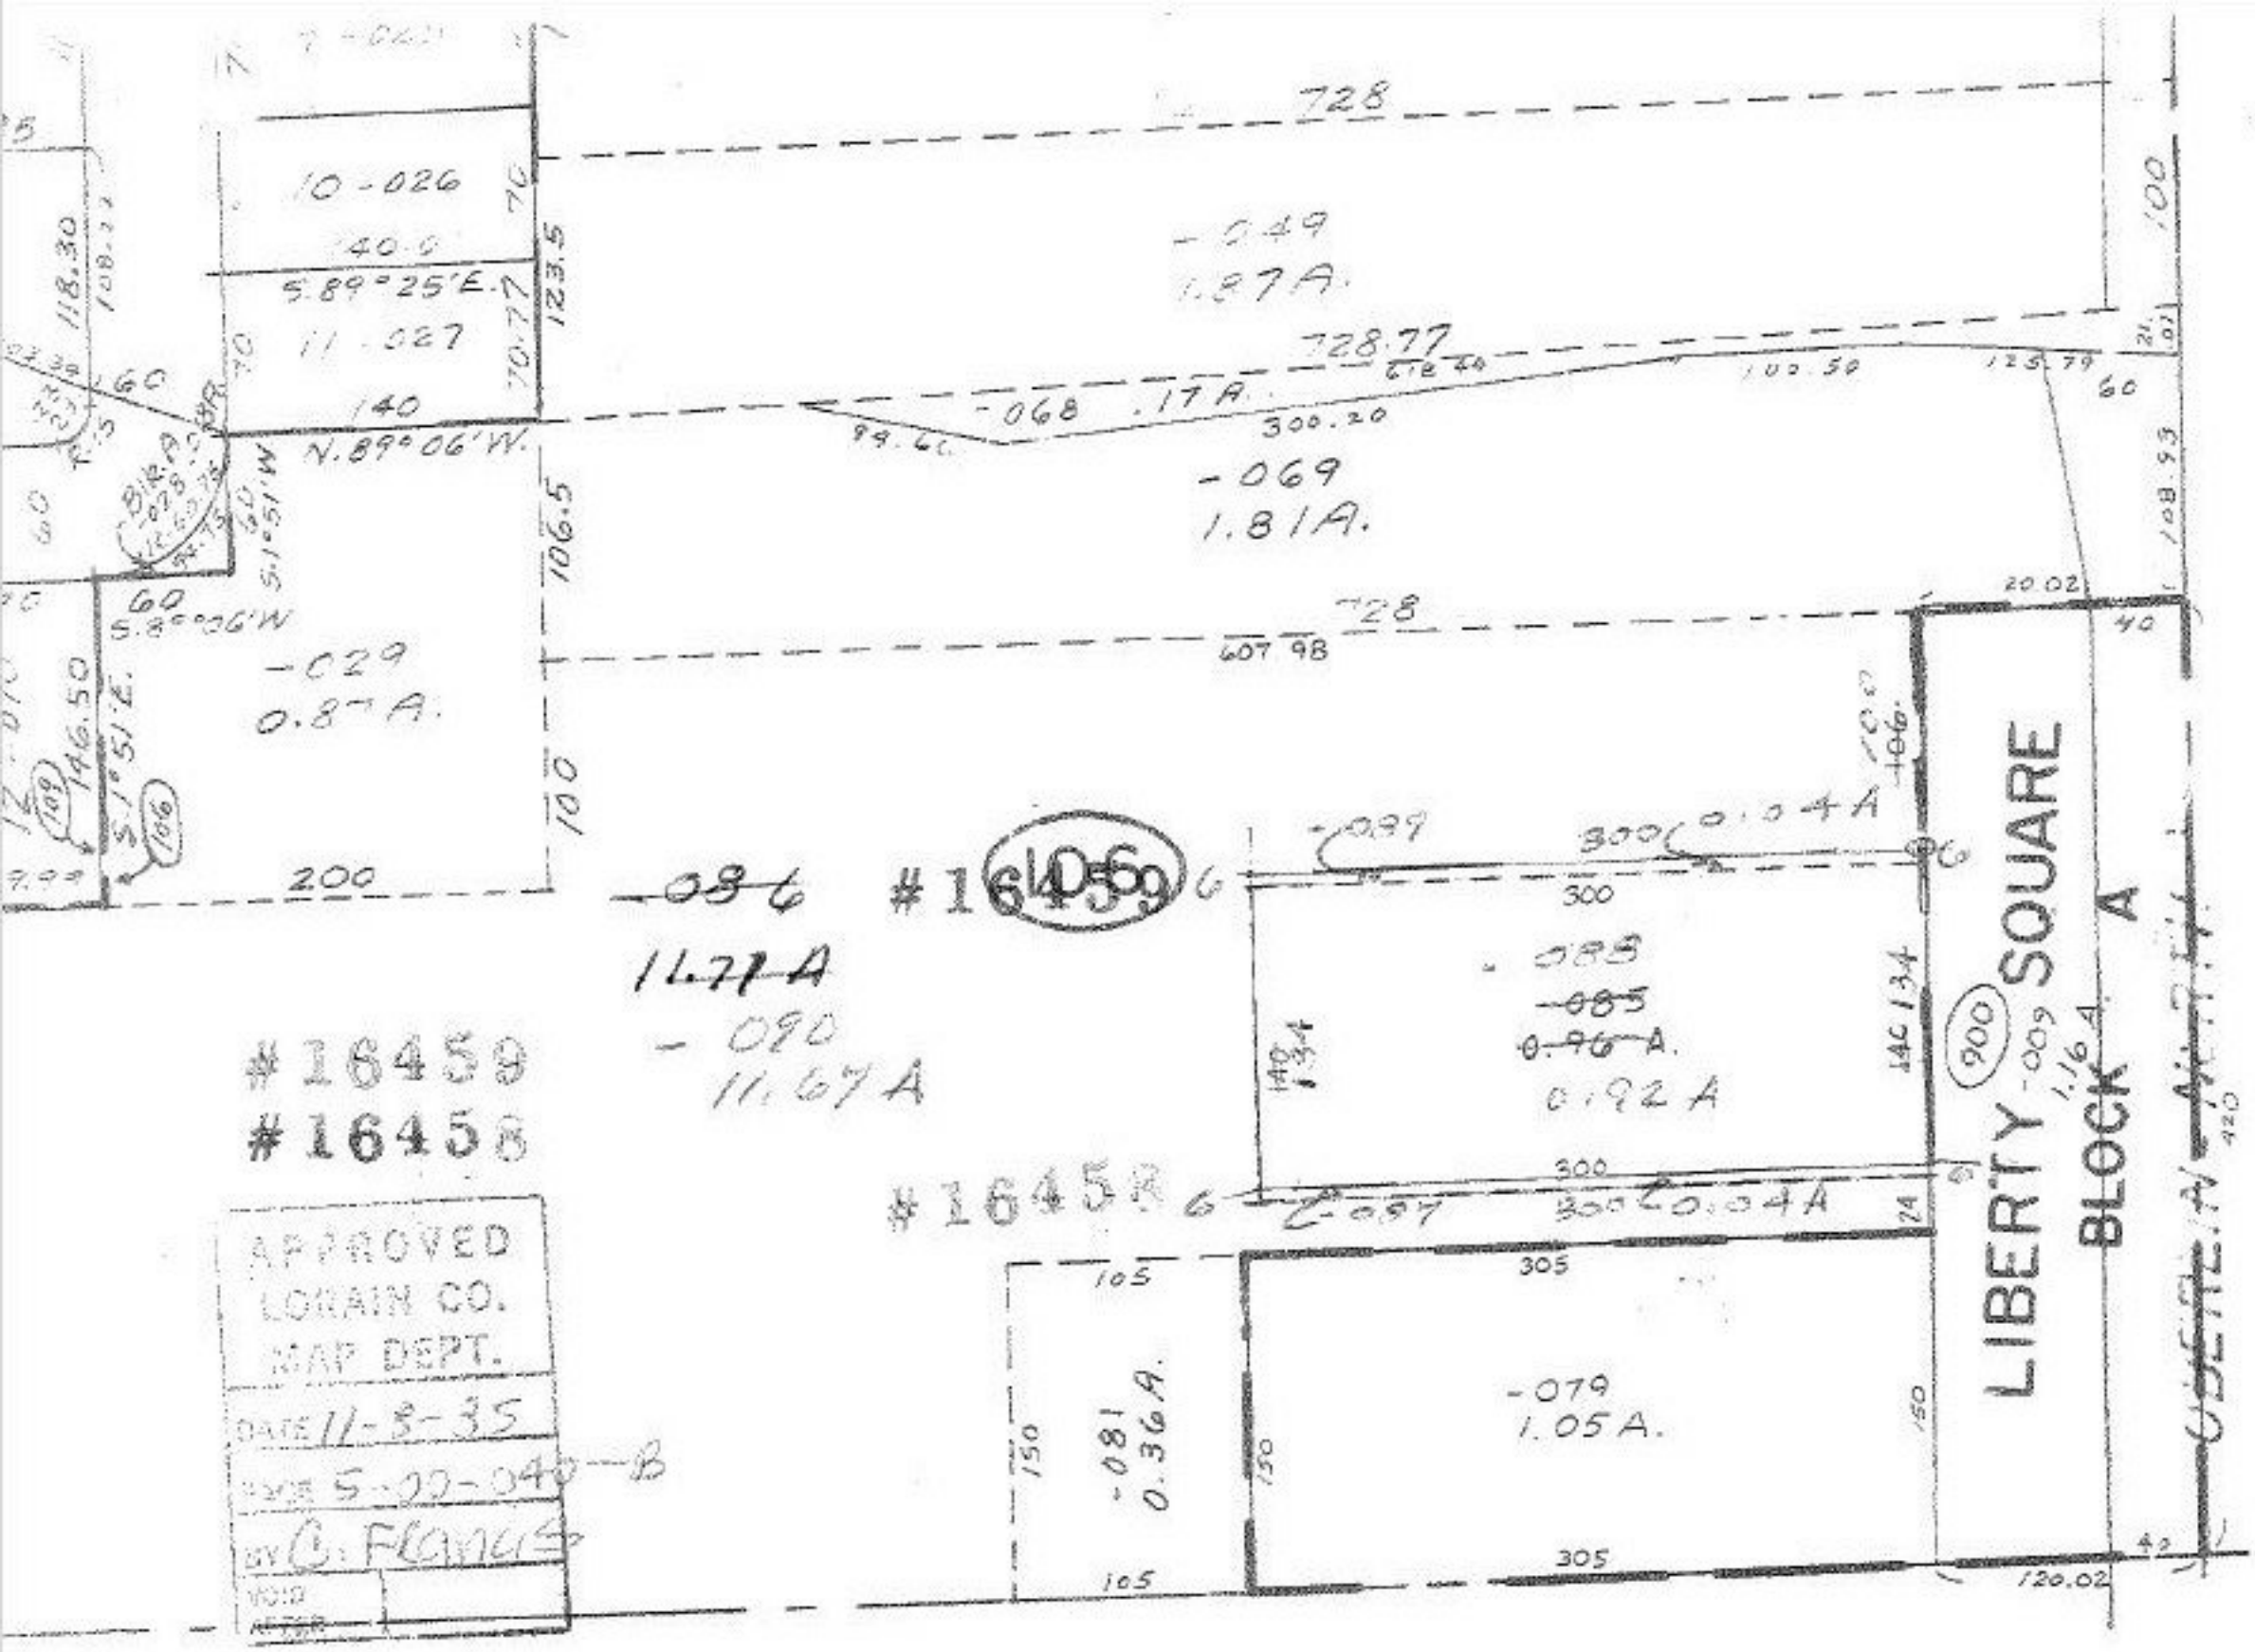

728
10-026
140.0
S.89°25'E.
11-027
140
N.89°06'W.
-049
1.87A.
728.77
-068 .17A.
300.20
-069
1.81A.
728
607.98
-029
0.87A.
200
106.5
100
123.5
118.30
146.50
S.1°51'E.
S.89°06'W
-089
300
0.04A
300
-088
-085
0.96 A.
0.92 A
300
-087
300
0.04A
305
-079
1.05A.
-081
0.36A.
105
150
305
120.02
LIBERTY SQUARE
BLOCK A
900
-009
1.16A
#16459
#16458
#16458
#16459
11.77A
-090
11.67A
APPROVED
LORAIN CO.
MAP DEPT.
DATE 11-8-85
PAGE 5-00-040-B
BY C. Francis
VOID
AFTER
5-00-039-B
3-28-86