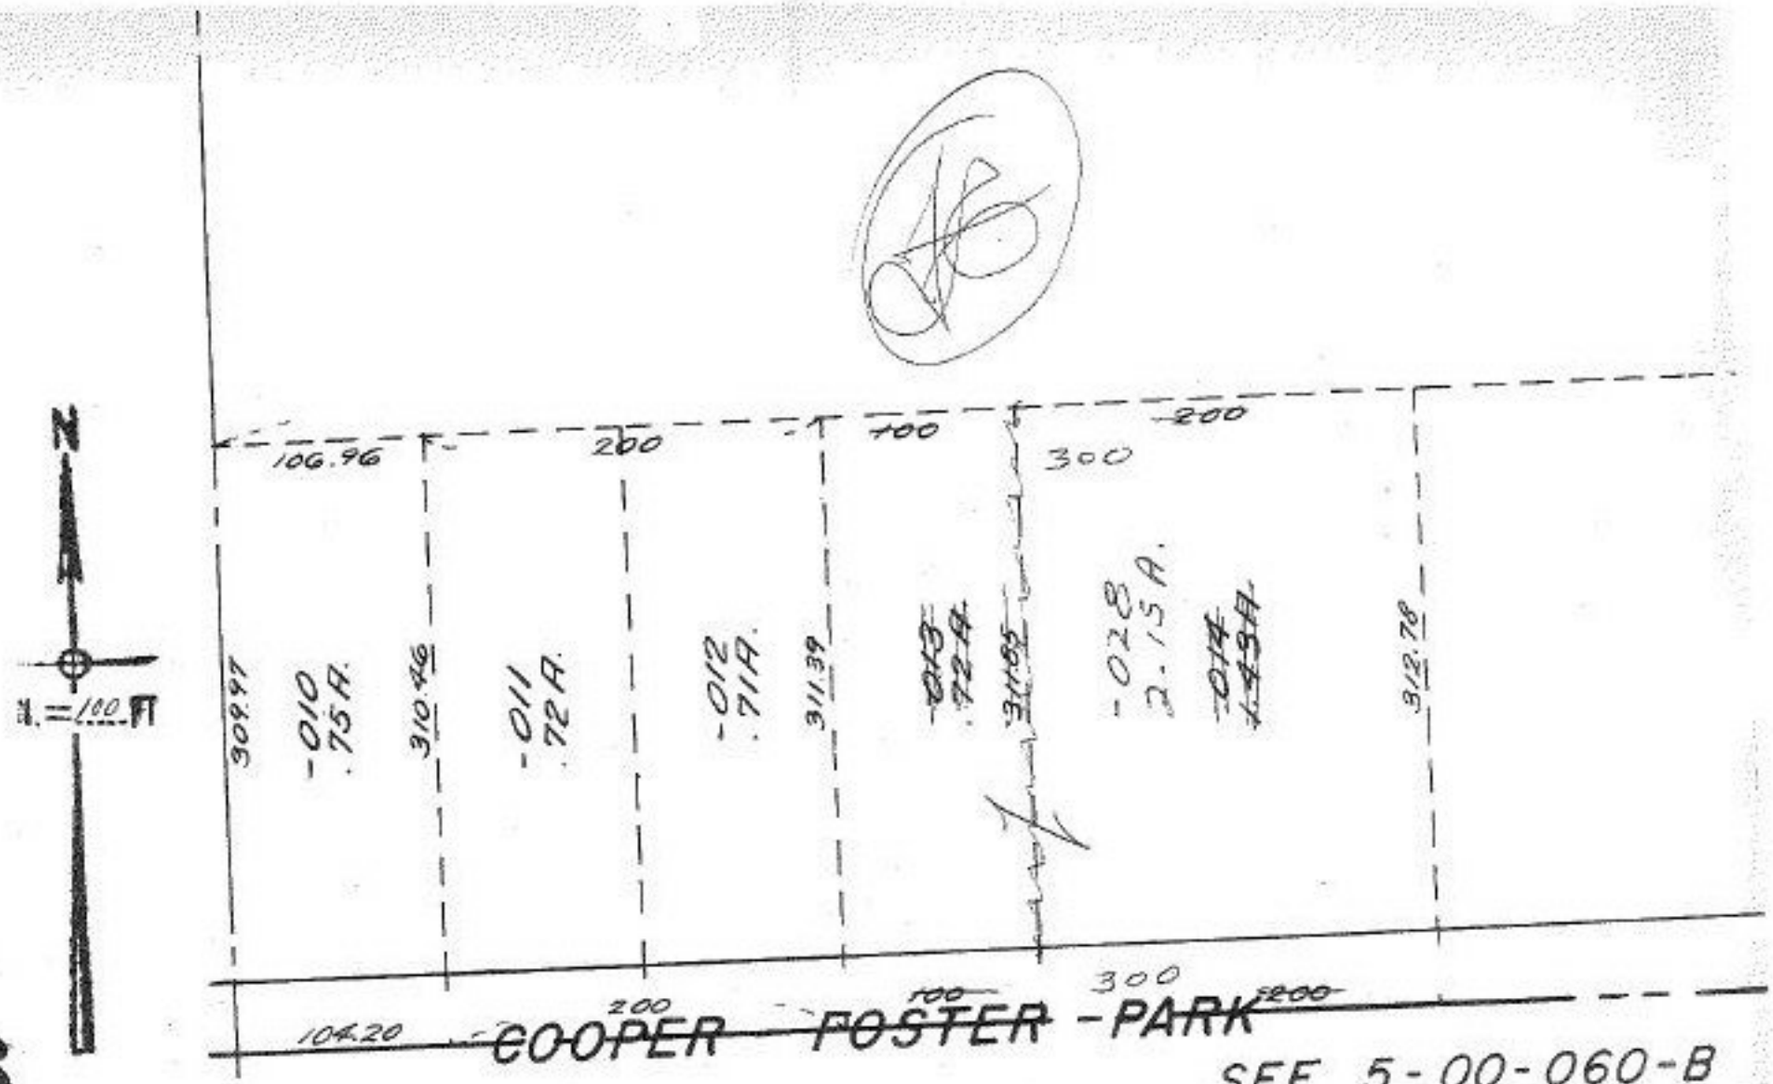

1646

7-14-86
S.S

APPROVED
LORAIN CO.
MAP DEPT.
DATE 4-3-68
2-02-005-A.
BY

BLACK RIVER TWP.

SCALE: 1" = 100'

02-02-005-109-013,014

Done 4-29-68
L W Hall