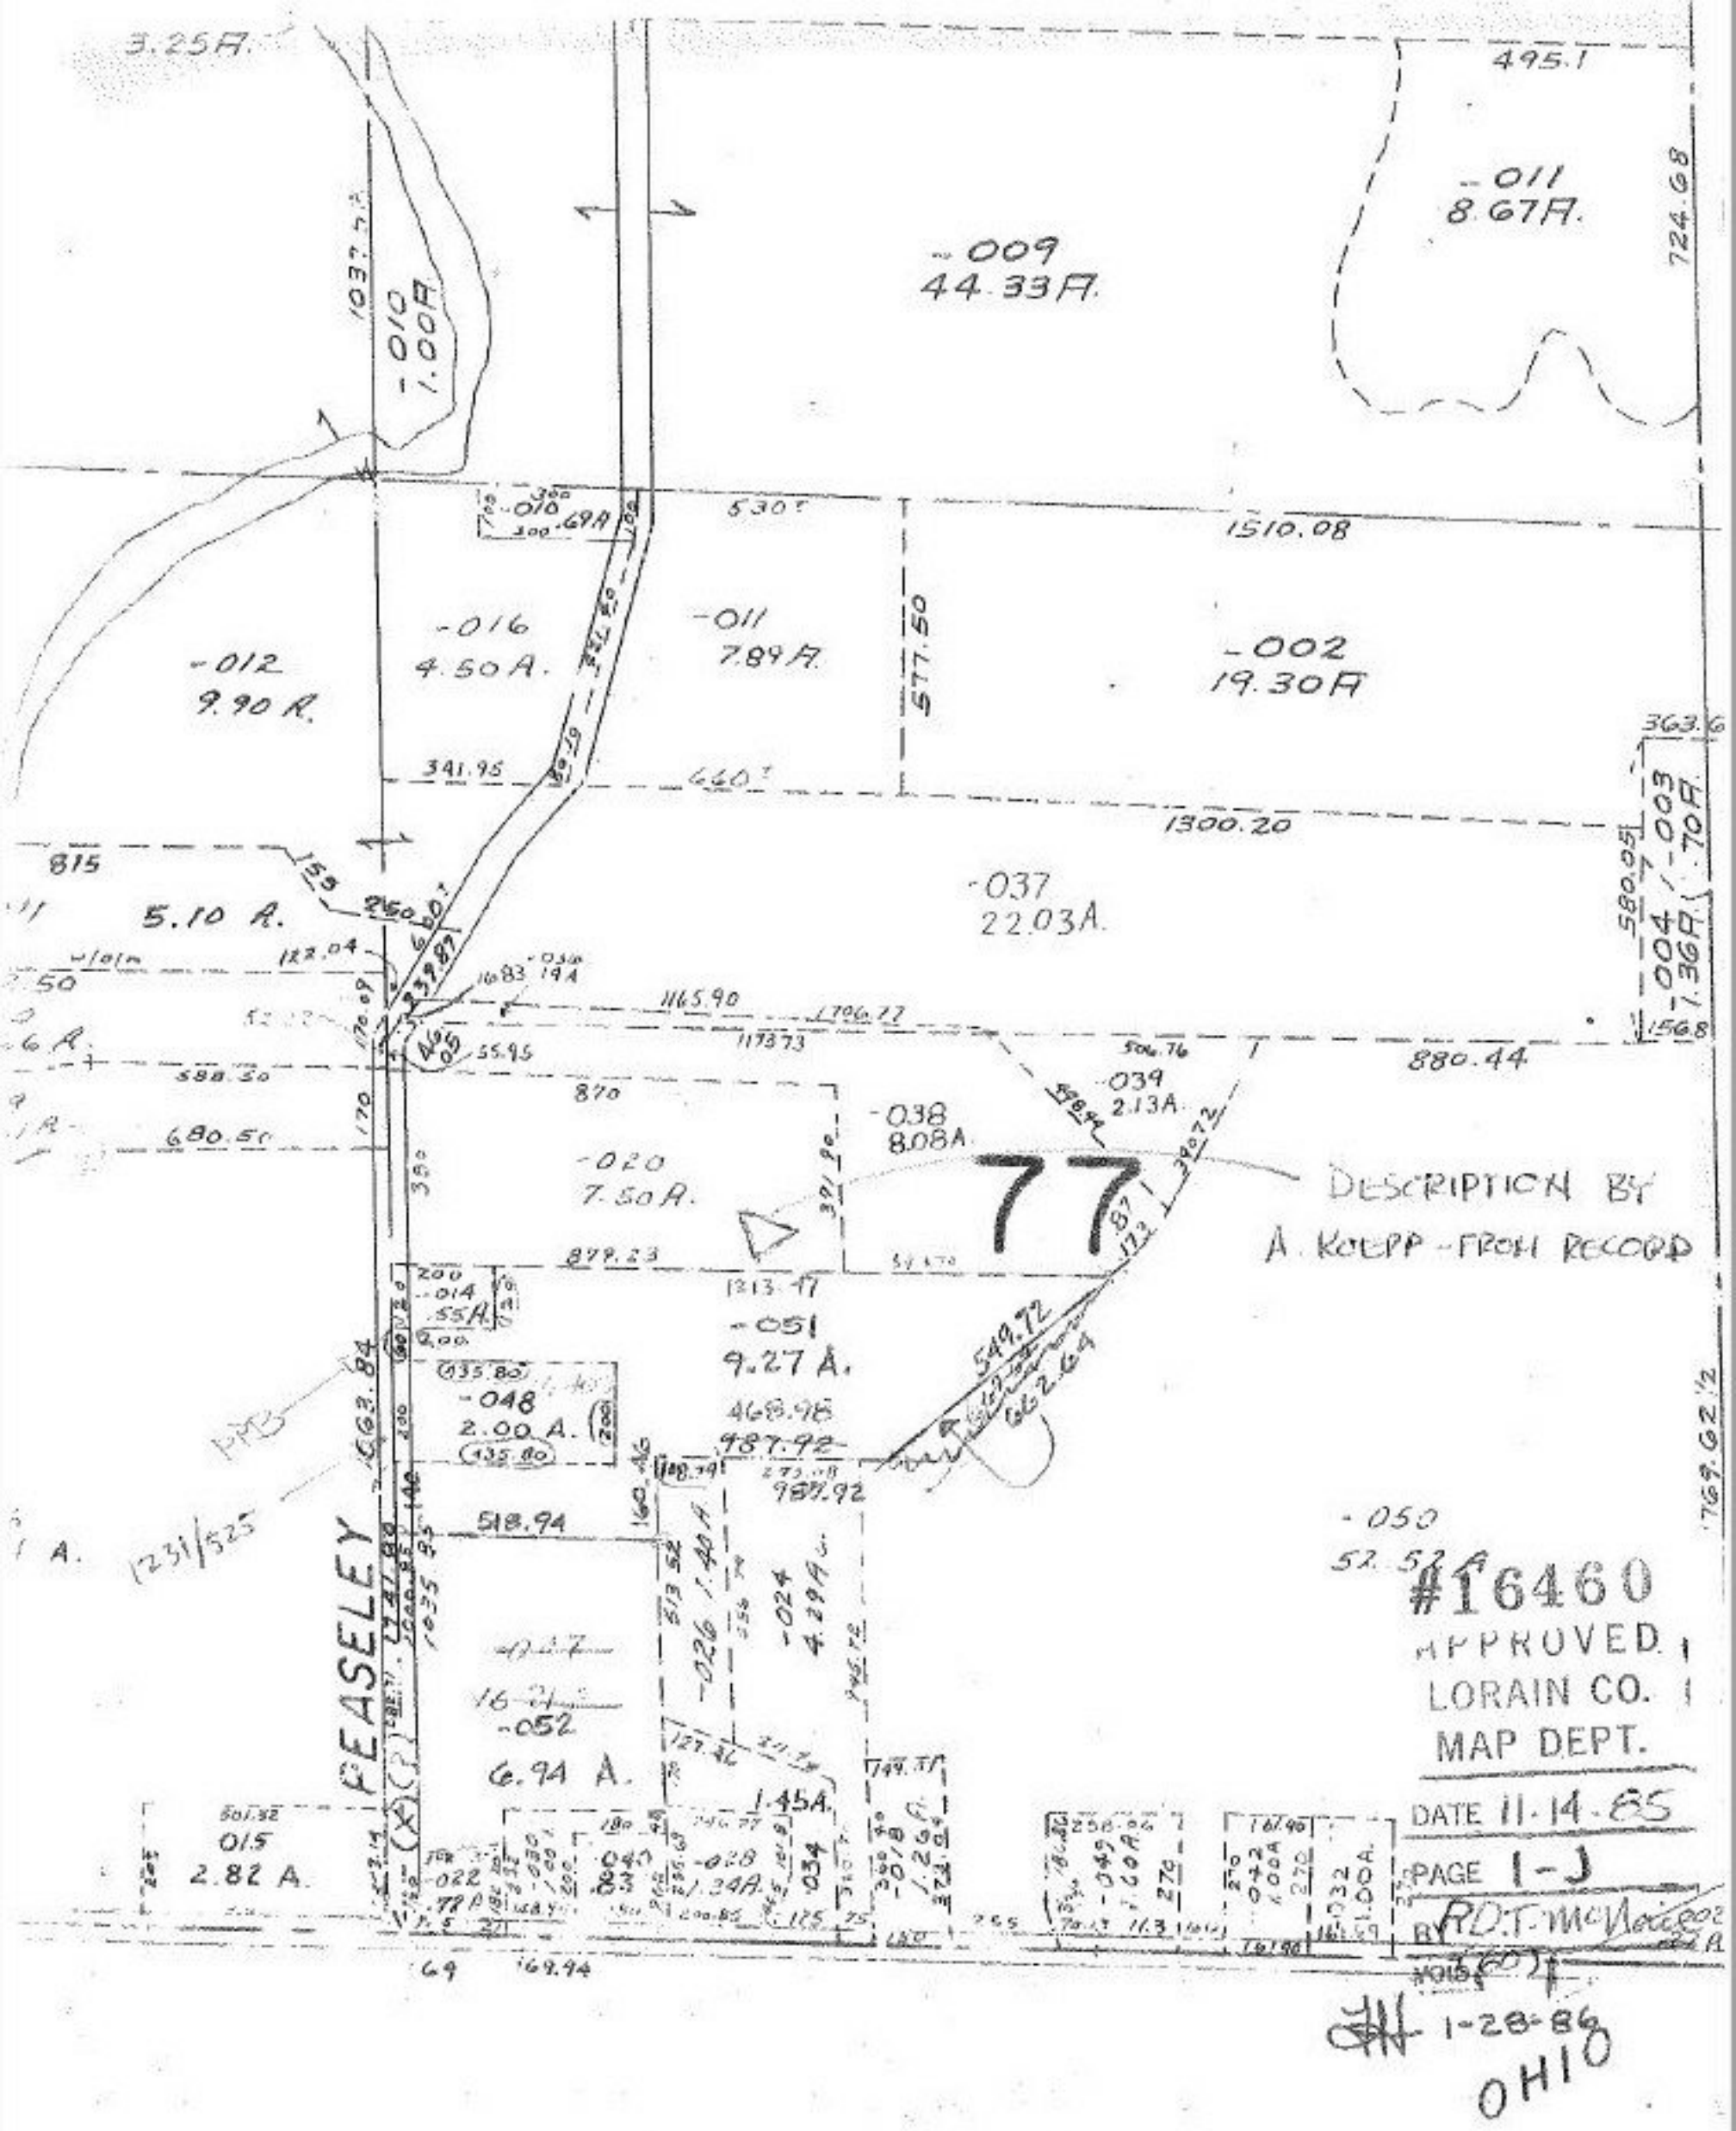
3.25A.
495.1
-011
8.67A.
724.68
-009
44.33A.
-010
1.00A.
530±
1510.08
-016
4.50A.
-011
7.89A.
577.50
-002
19.30A
-012
9.90A.
341.95
660±
1300.20
363.6
815
5.10 A.
-037
22.03A.
580.05
-004
1.36A.
-003
.70A.
156.8
1165.90
1706.77
880.44
588.50
870
-039
2.13A.
-038
8.08A.
680.50
-020
7.50A.
77
DESCRIPTION BY
A. KOEPP - FROM RECORD
879.23
-014
.55A.
-051
9.27 A.
549.72
662.64
-048
2.00 A.
468.98
987.92
987.92
518.94
-050
52.52A
PEASELEY
-026
1.40A.
-024
4.29A.
-052
6.94 A.
1.45A.
015
2.82 A.
-028
1.34A.
-032
1.00A.
169.94
769.62½
#16460
APPROVED
LORAIN CO.
MAP DEPT.
DATE 11-14-85
PAGE 1-J
BY R.D.T. McNeil
1-28-86
OHIO