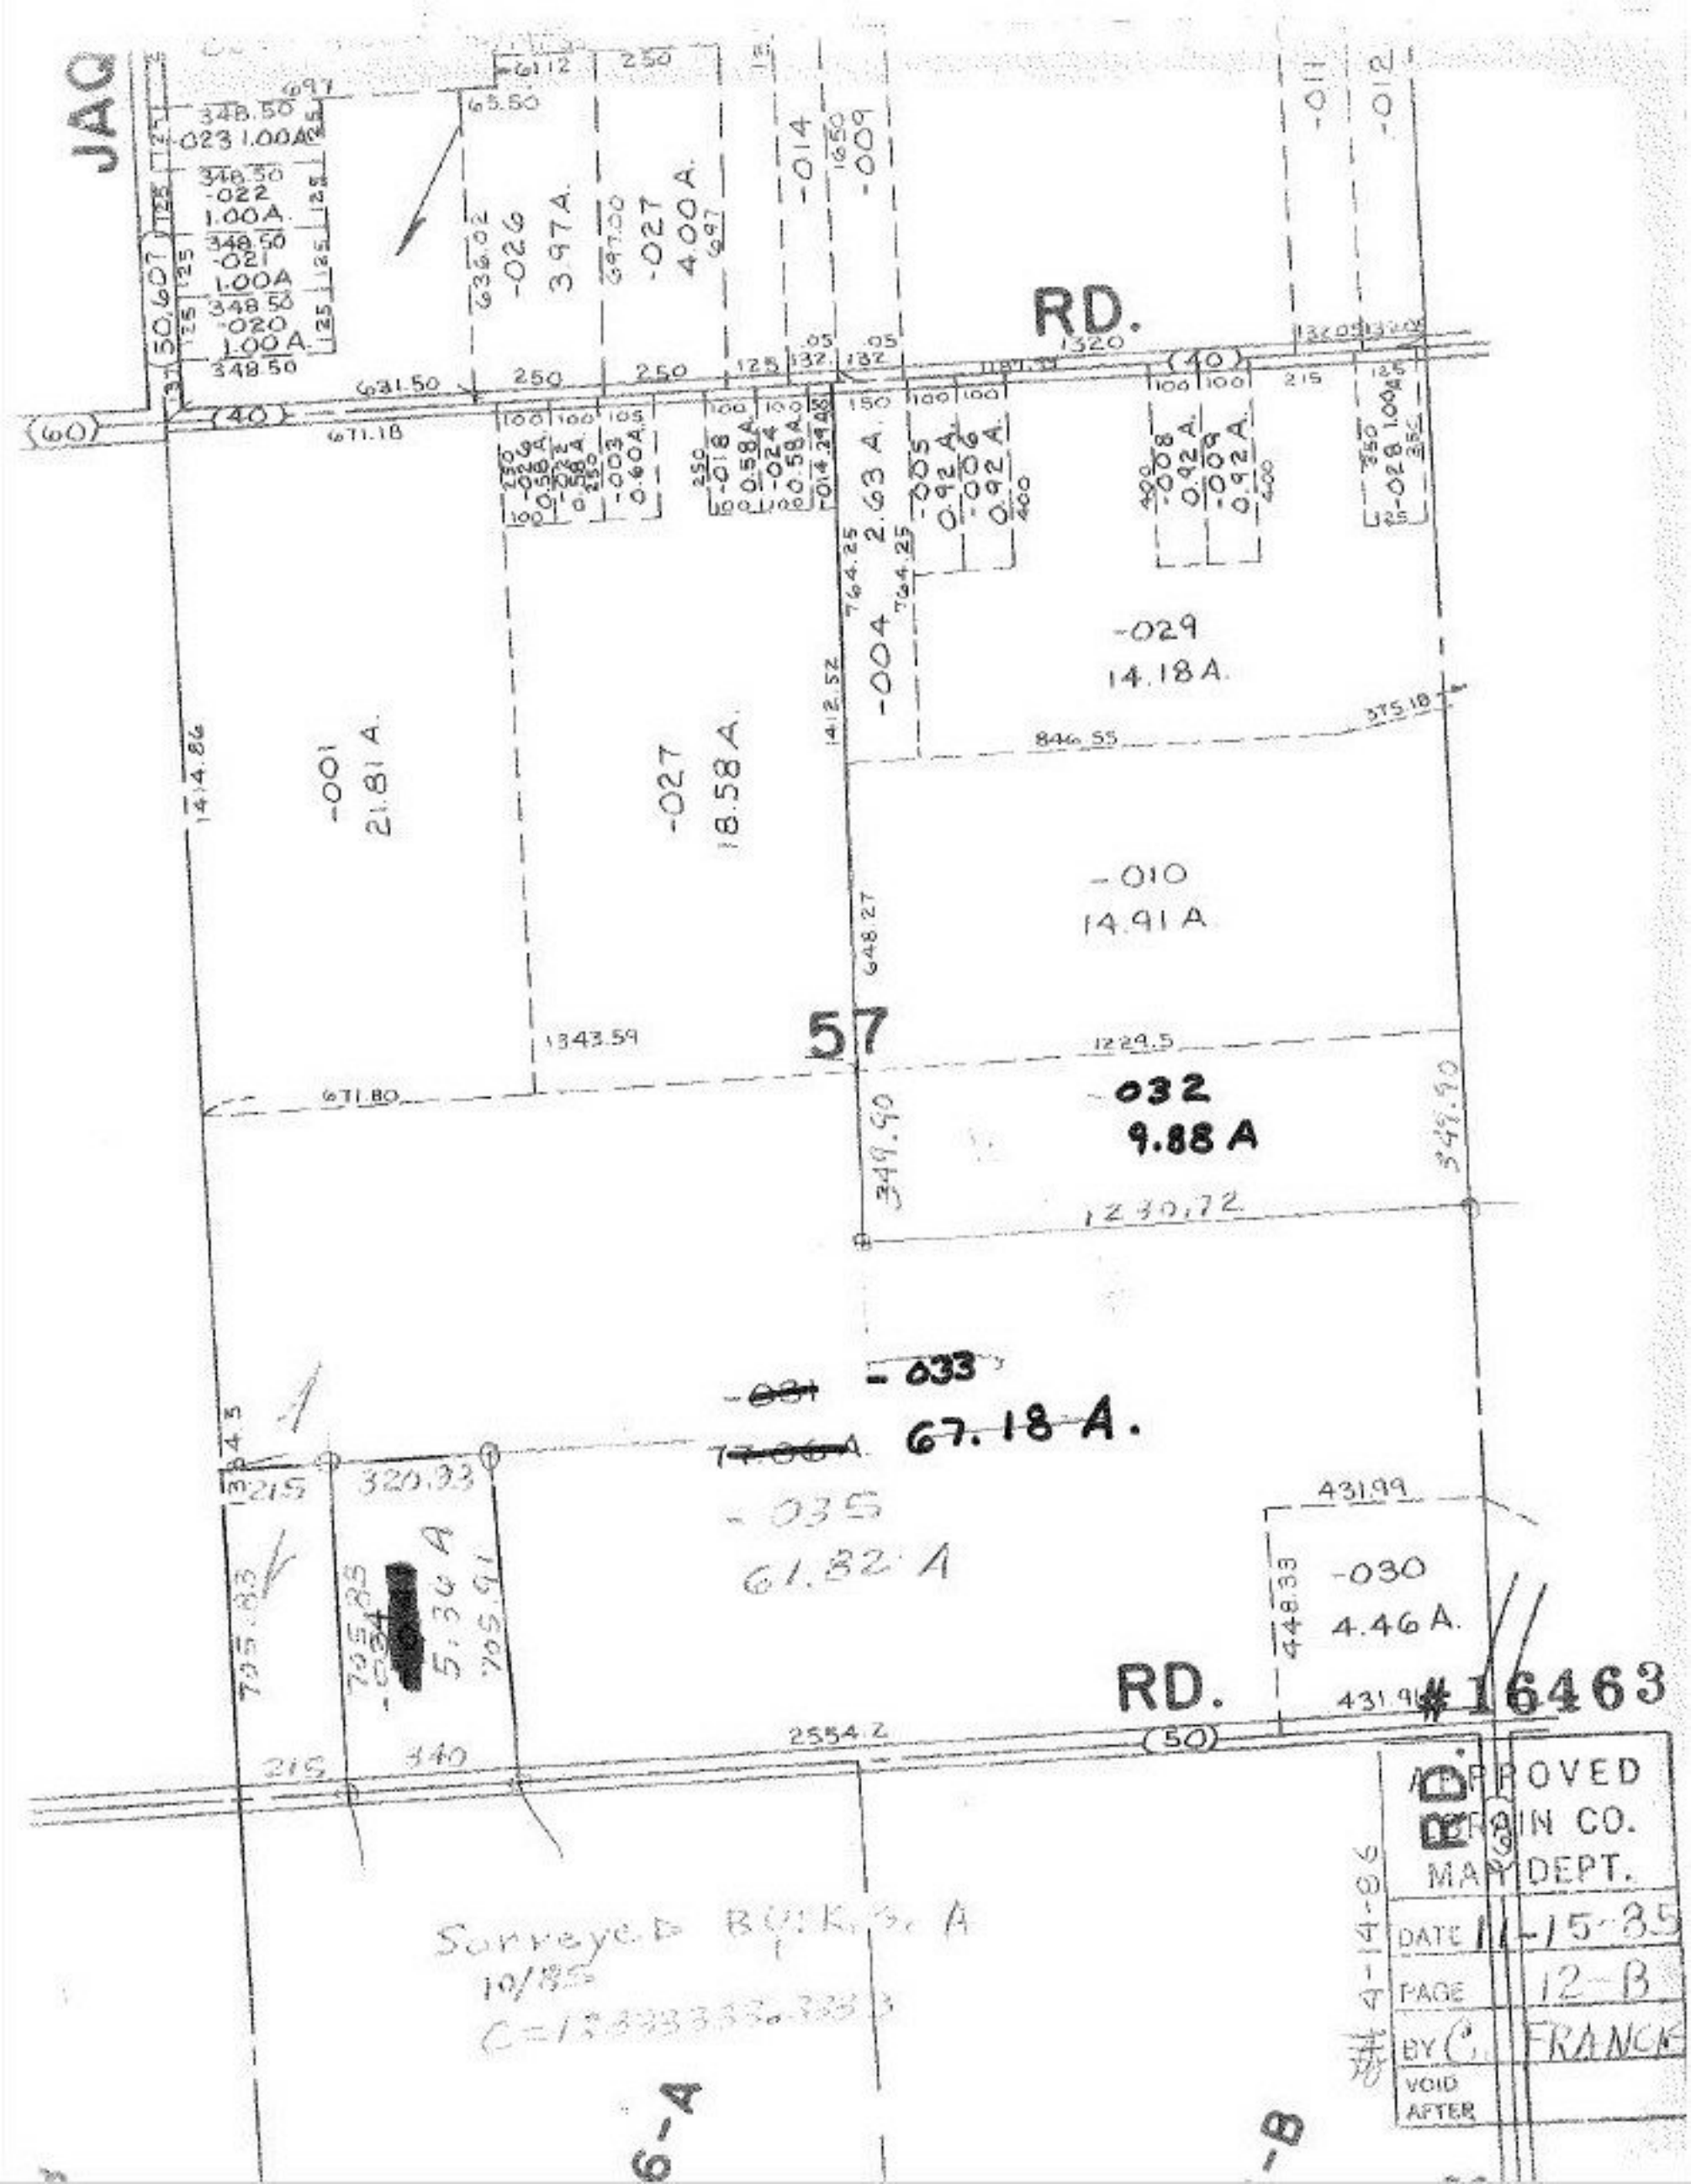
JAQ
RD.
-029
14.18 A.
-010
14.91 A
-001
21.81 A.
-027
18.58 A.
57
-032
9.88 A
-033
67.18 A.
-035
61.82 A
-030
4.46 A.
RD.
#16463
Surveyed BY: K.S. A
10/85
APPROVED
DRAIN CO.
MAP DEPT.
DATE 11-15-85
PAGE 12-B
BY C. FRANCK
VOID
AFTER
4-14-86